


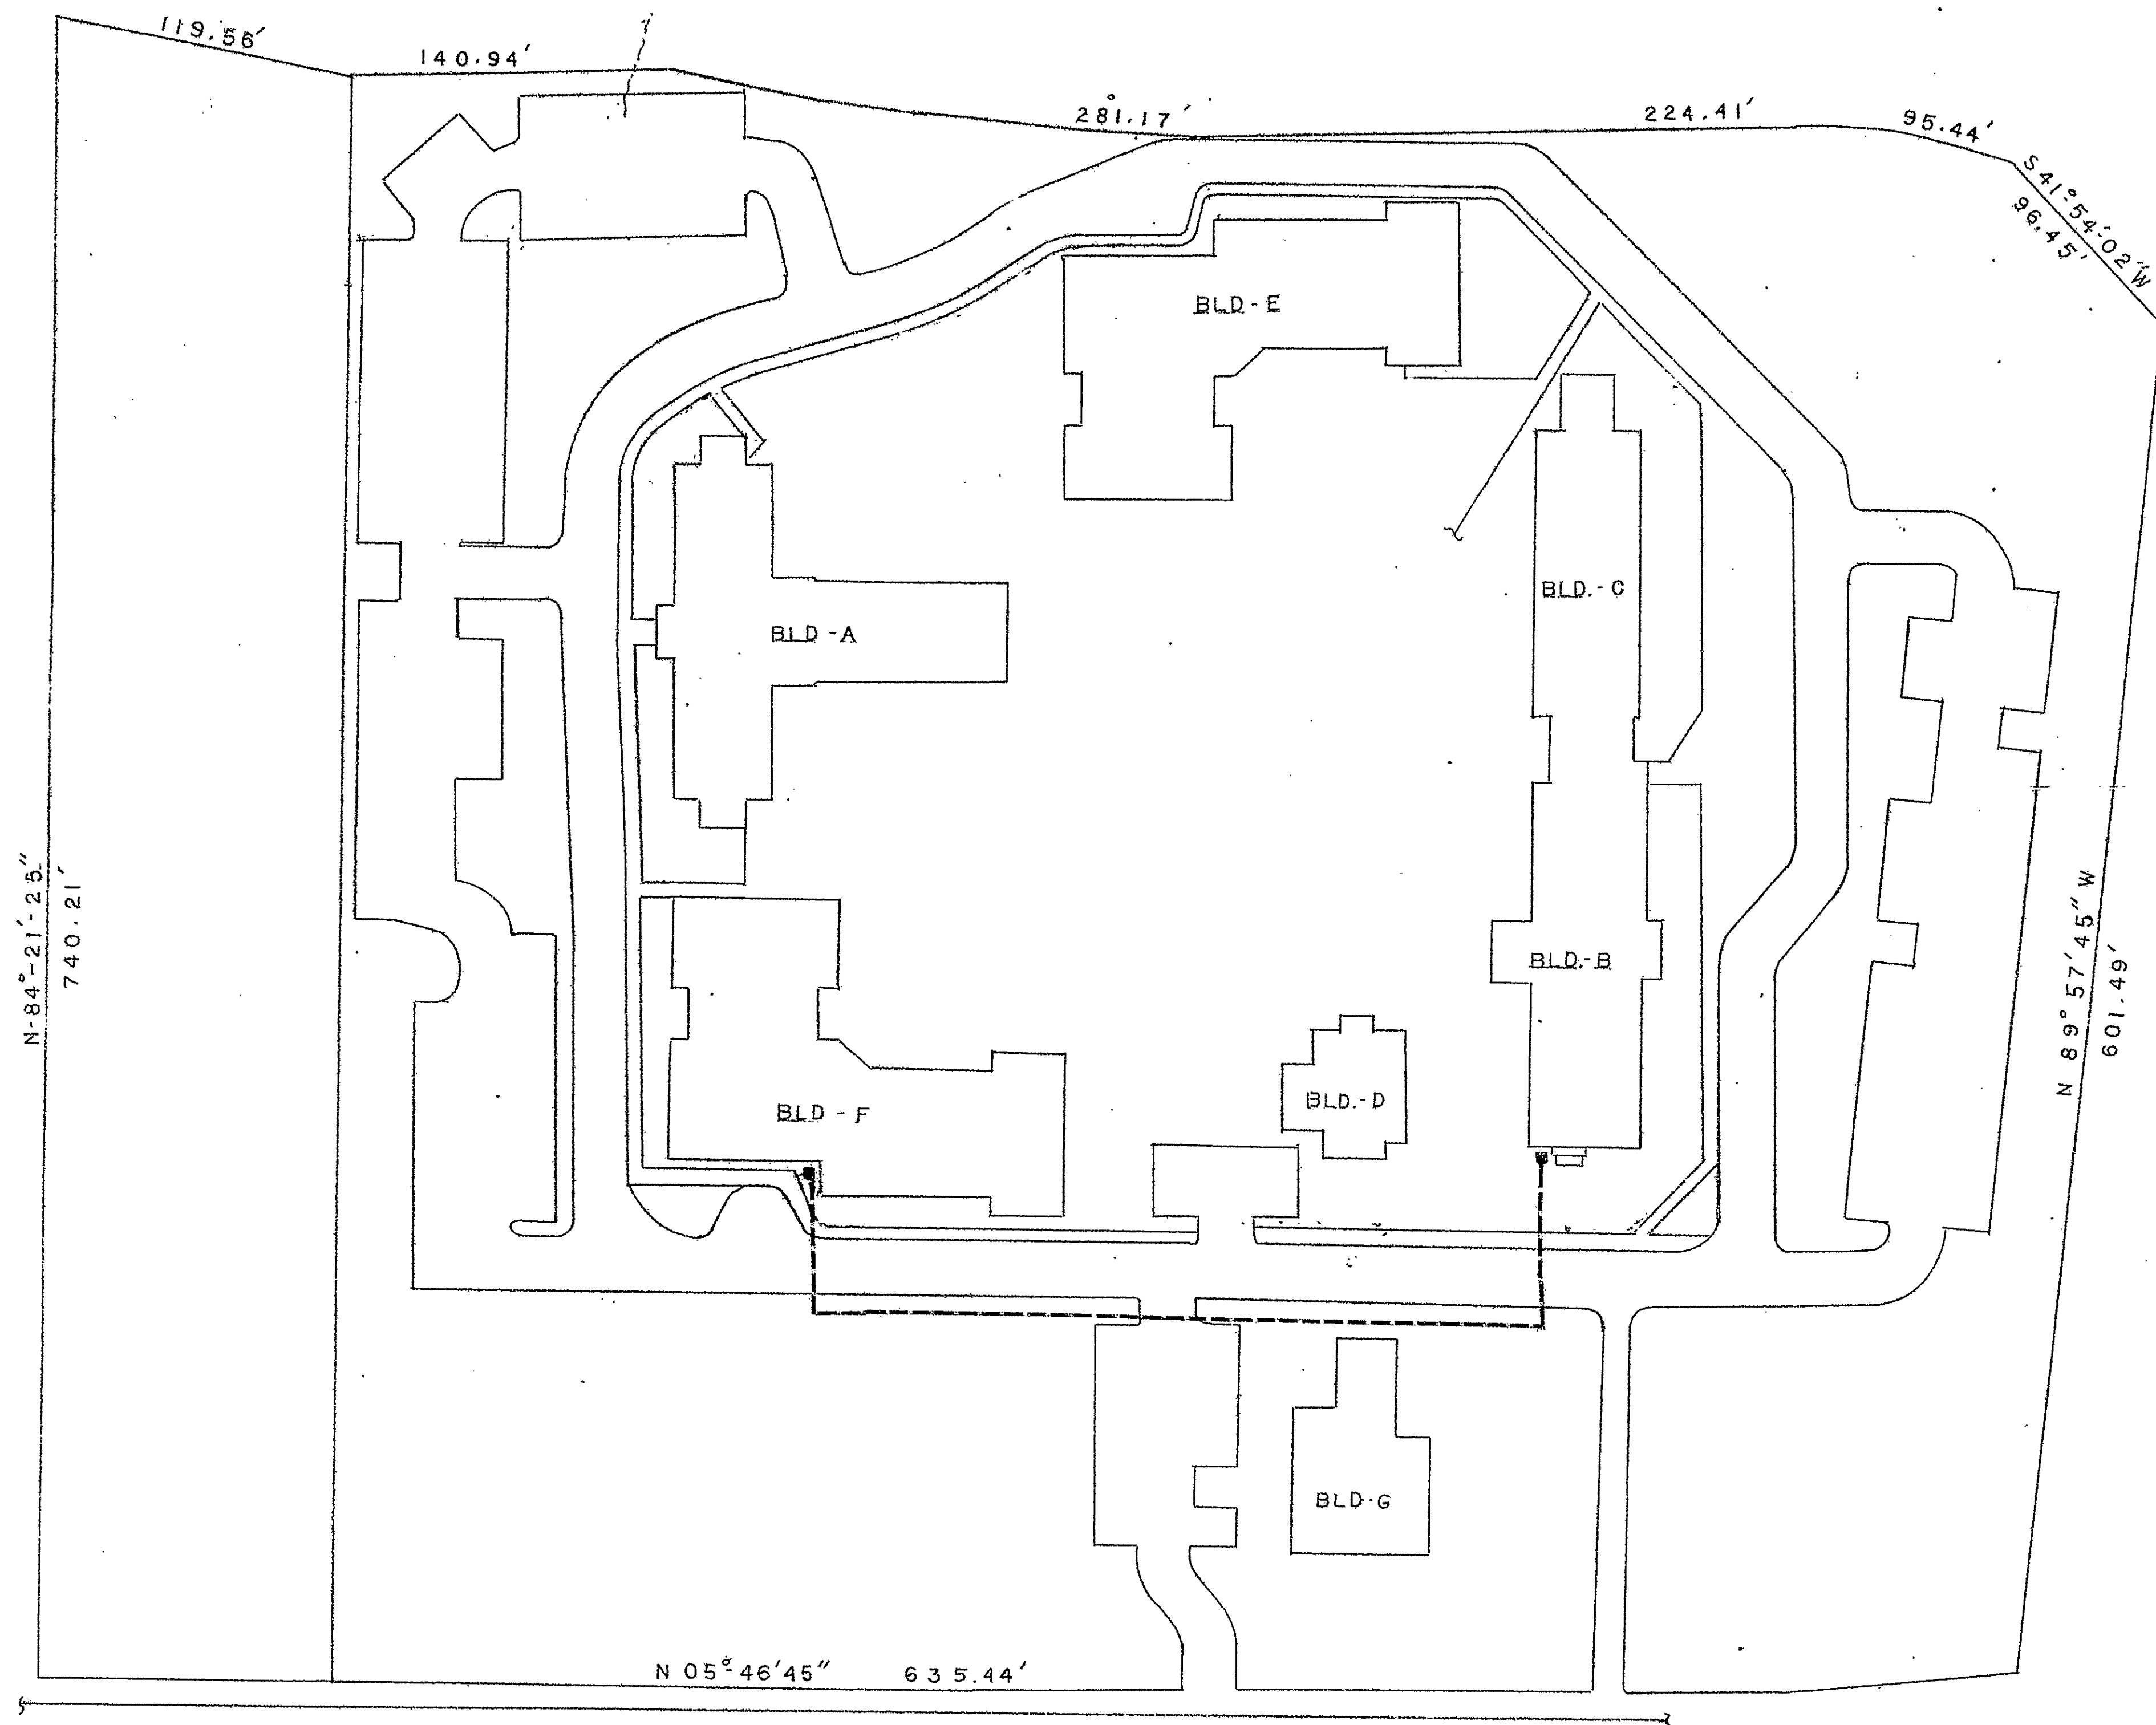

SISSON AVENUE

THIS SKETCH COMPILED FROM MAPS BY
CLOSE, JENSEN AND MILLER SHEETS —
S-1, S-2, S-3, S-4 AND DATED 3/9/79.

LEGEND
 TRANSFORMER
 BURIED CABLE

THE UNDERSIGNED UTILITY EMPLOYEE
CERTIFIES THIS MAP TO BE
"SUBSTANTIALLY CORRECT" AND IN
ACCORDANCE WITH CLASS D OF CODE
OF CONN. TECHNICAL COUNCIL, INC.
THE HARTFORD ELECTRIC LIGHT COMPANY
PER Donald F. Poland

The portion of Sisson Avenue shown
on this plan is an established public
street of the City of Hartford.

Sept. 16, 1980 George F. Williams
City Engineer

NO.	DATE	DESCRIPTION	BY

THE HARTFORD ELECTRIC LIGHT CO.
 SKETCH OF ELECTRIC FACILITIES
 ON THE PROPERTY OF THE SHEPHERD
 PARK COMPANY AT 170 SISSON
 AVENUE, HARTFORD, CONNECTICUT.
 DRAWN BY D.F.P. APPROVED BY AS
 SCALE 1" = 50'
 DATE 7-21-80 NO. DU3H0019-A



113

RECEIVED BY
439450
Rafael...

#102

1113