


1119-1

1119-1

RECEIVED BY
R. A. ...
Aug 1 11 13 AM '80
TOWN OF ...
VOL. ... PAGE ...

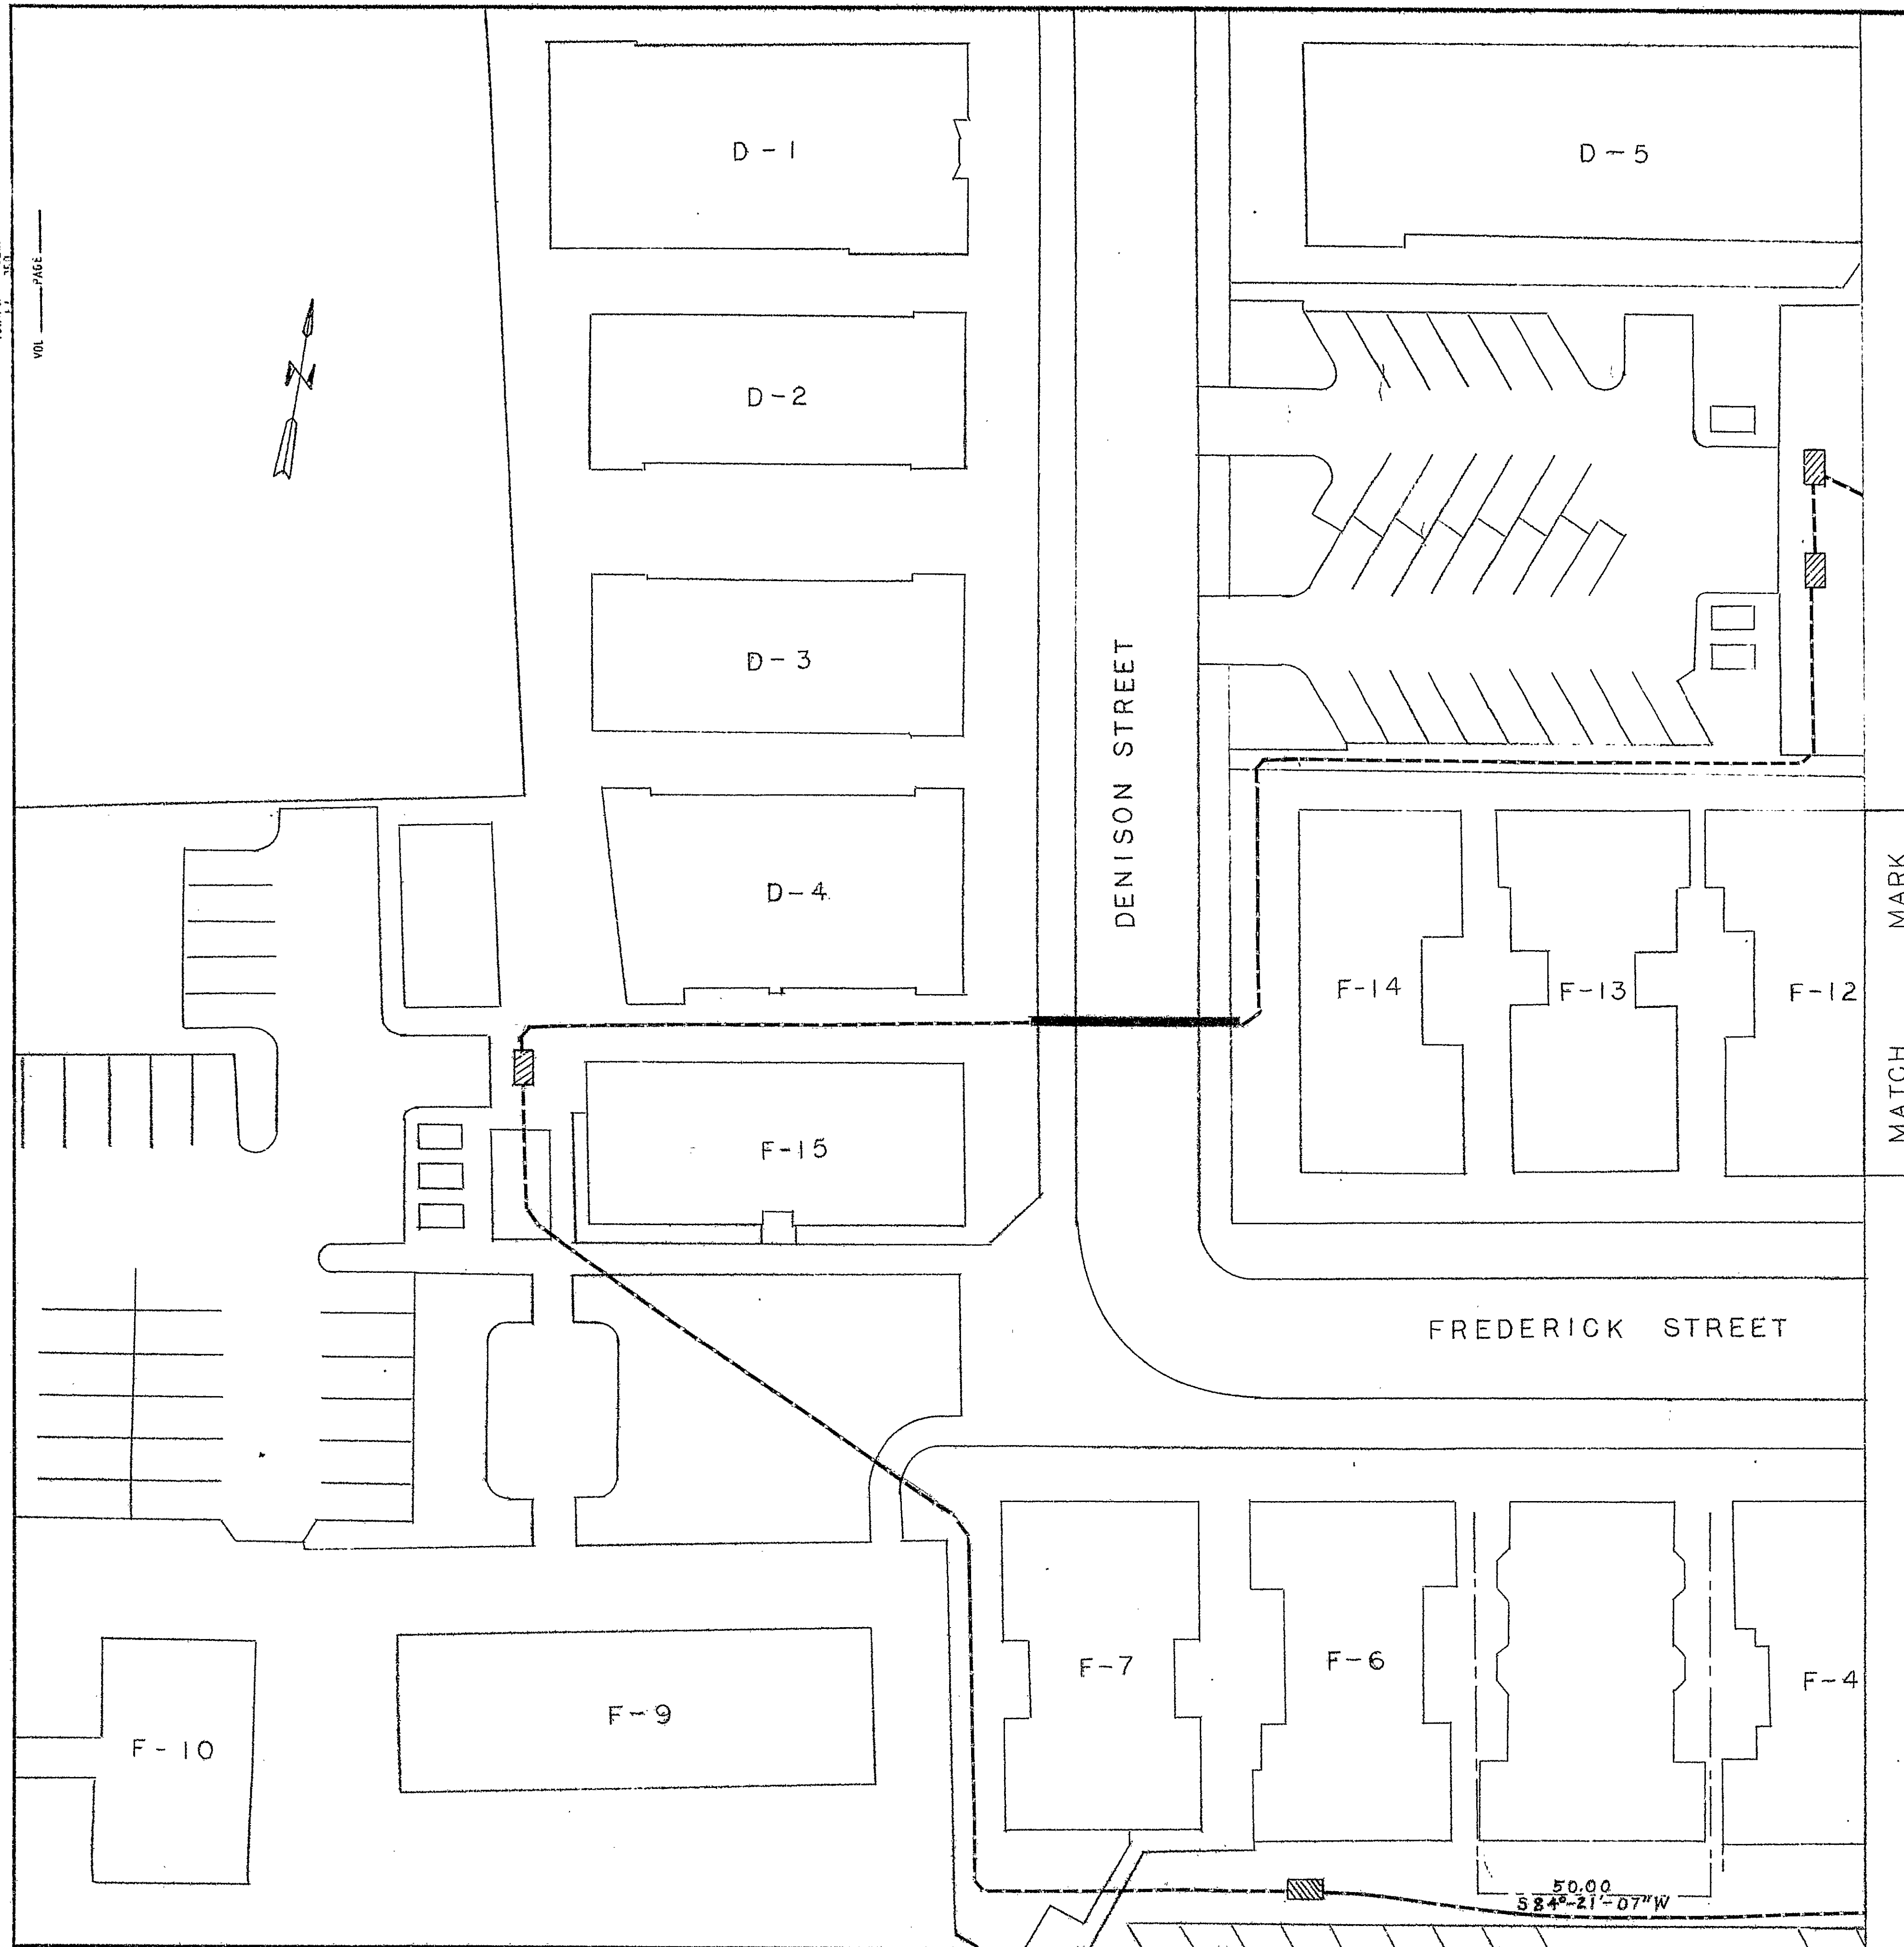

- LEGEND
- TRANSFORMER
 - DIRECT BURIED CABLE
 - CONDUIT
 - SWITCH

THIS SKETCH COMPILED FROM MAPS BY C.E. MAGUIRE INC.
TITLED - FREDERICK, DENISON AND OWEN SITE IMPROVEMENTS

THE UNDERSIGNED UTILITY EMPLOYEE
CERTIFIES THIS MAP TO BE
"SUBSTANTIALLY CORRECT" AND IN
ACCORDANCE WITH CLASS D OF CODE
OF CONN. TECHNICAL COUNCIL, INC.
THE HARTFORD ELECTRIC LIGHT COMPANY
PER Daniel F. Polanski

The portions of Denison Street and
Frederick Street shown on this
plan are established public
streets of the City of Hartford.
Aug. 4, 1980 George C. ...
City Engineer

NO.	DATE	DESCRIPTION	BY

THE HARTFORD ELECTRIC LIGHT CO.
SKETCH SHOWING ELECTRIC FACILI-
TIES ON THE PROPERTY OF 412
FARMINGTON REALTY CORPORA-
TION, HARTFORD, CONNECTICUT.
DRAWN BY DEP APPROVED BY ...
SCALE 1" = 20' DATE 7/3/80
N.O. 09410100 PAGE-1

