1121-3

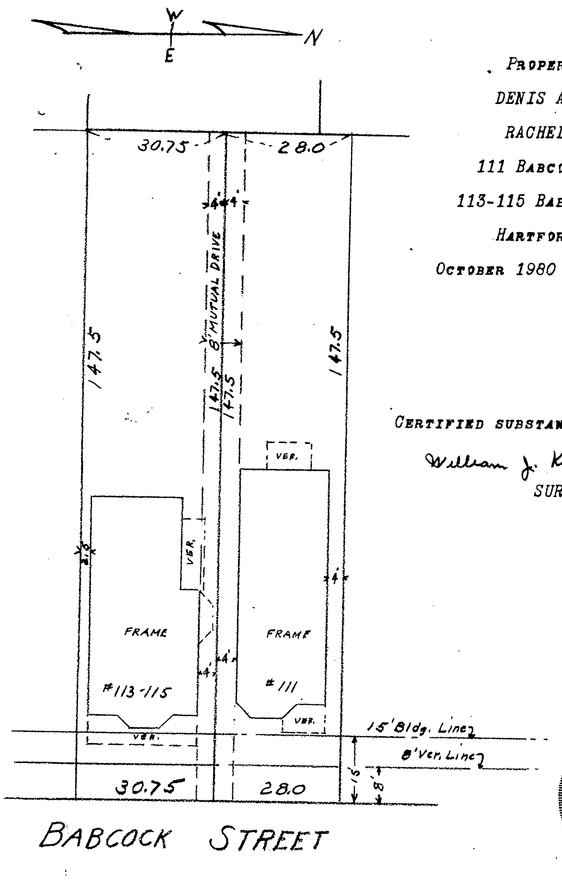

PROPERTY OF
DENIS A. PARE
RACHEL PARE
111 BABCOCK STREET
113-115 BABCOCK STREET
HARTFORD CONN.
OCTOBER 1980 SCALE 1" = 20'

CERTIFIED SUBSTANTIALLY CORRECT.

William J. Kozlowski
SURVEYOR

STATE OF CONNECTICUT
WILLIAM J. KOZLOWSKI
No. 1981
REGISTERED
LAND SURVEYOR

The portion of Babcock Street shown on this plan is an established public street of the City of Hartford.

Dec. 29, 1980 George E. Hepburn
City Engineer

RECEIVED BY
Robert F. Ballerini
Dec 29 2 53 PM '80
TOWN & CITY CLERK
HARTFORD
VOL. ____ PAGE ____

EASI-FILE CORP. IRVINE CA
1121
EFM 74

#116 1121