


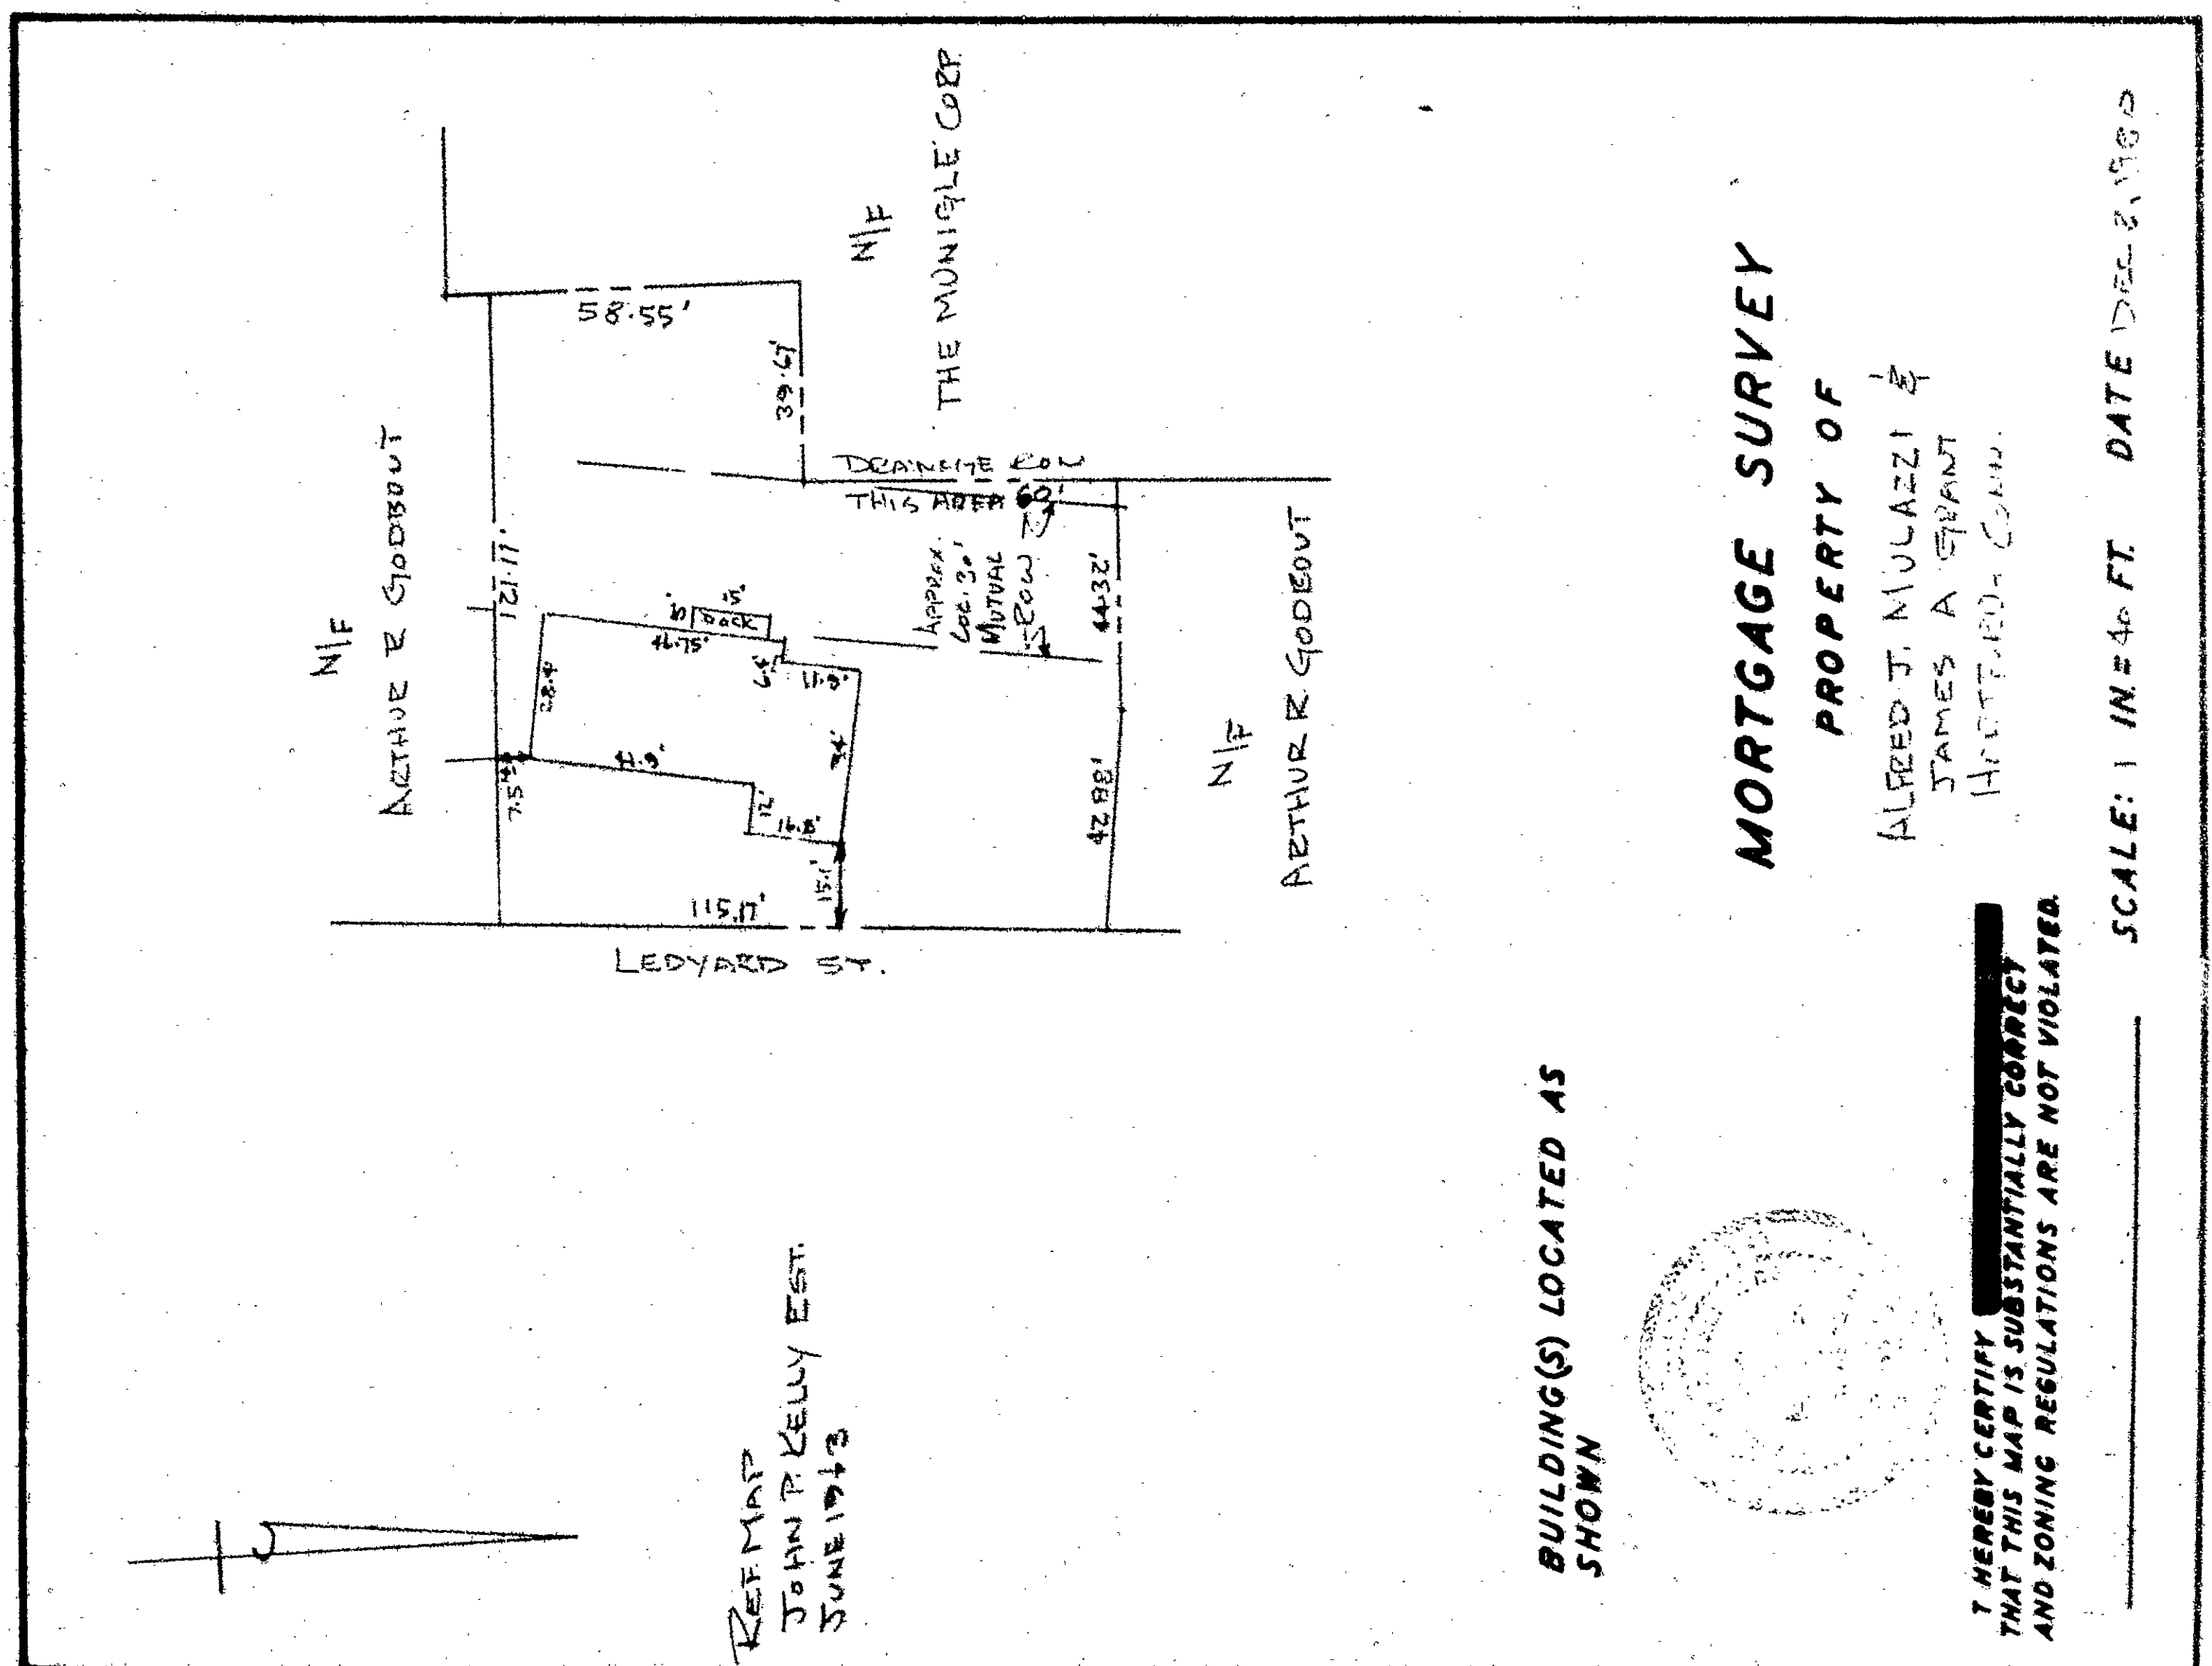

RECEIVED BY
RECEIVED BY
RECEIVED BY
RECEIVED BY

The portion of Ledyard Street shown on this plan is an established public street of the City of Hartford.
Feb. 3, 1981
City Engineer



1122 128