



Dec 11 1980
 Dec 11 1980
 Dec 11 1980
 Dec 11 1980

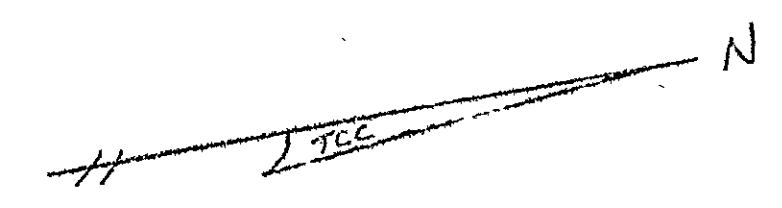

Block 8 Parcel 2

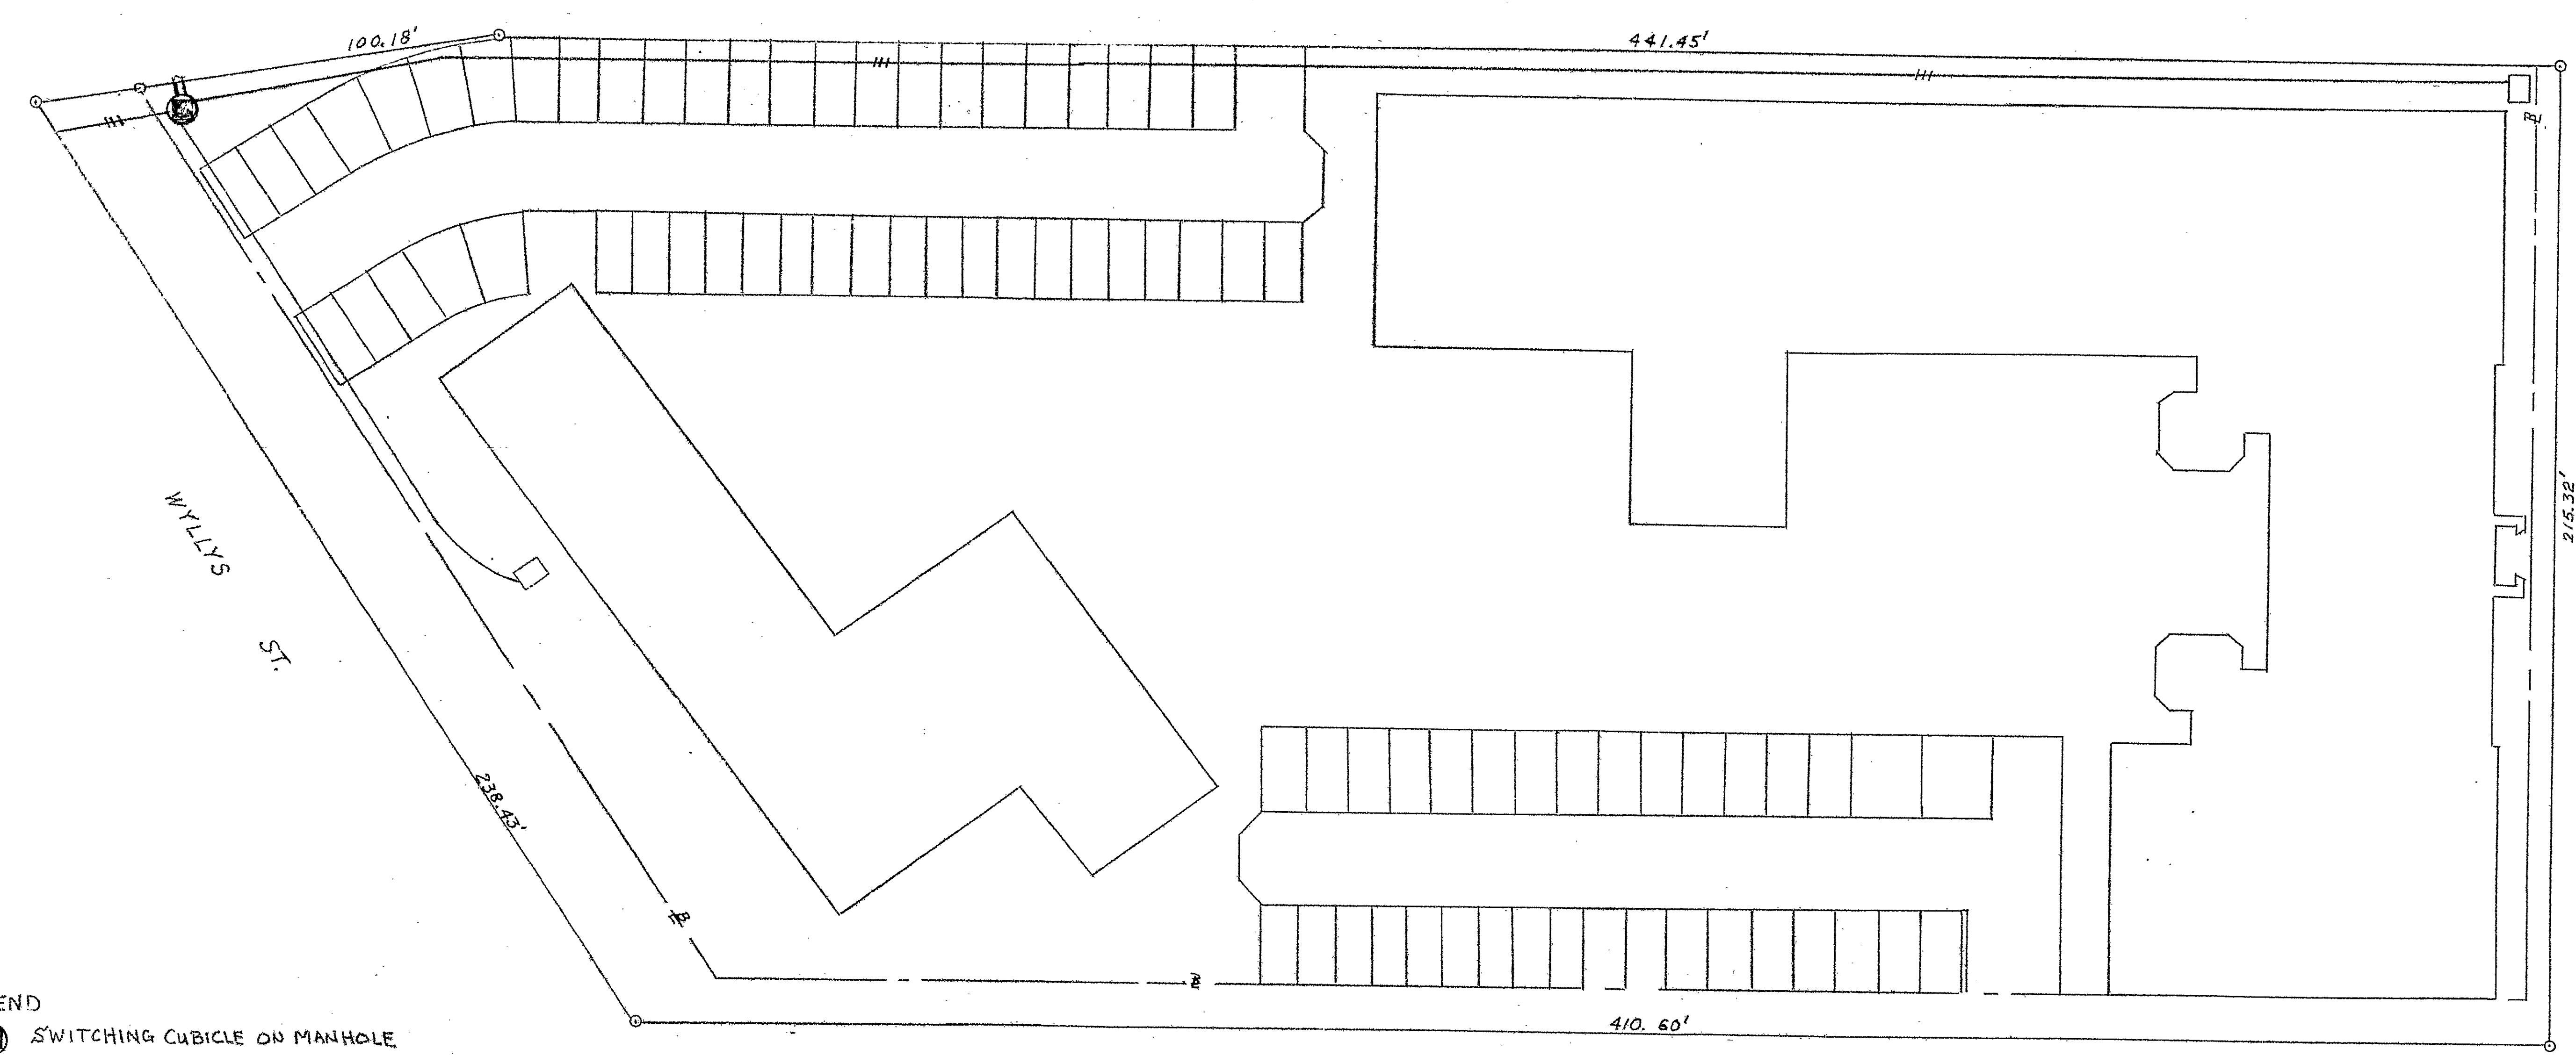

- LEGEND
- SWITCHING CUBICLE ON MANHOLE
 - PADMOUNT TRANSFORMER
 - UNDERGROUND CABLE
 - CONDUIT

The portions of Wyllis Street, Union Street and Charter Oak Avenue shown on this plan are established public streets of the City of Hartford.
 Dec. 12, 1980
[Signature]
 City Engineer


THIS SKETCH COMPILED FROM A MAP ENTITLED:
 SITE PLAN HARTFORD SQUARE WEST
 HARTFORD, CONNECTICUT BY IGOR VECHESLOFF
 PROFESSIONAL ENGINEER & LAND SURVEYOR
 51 LORRAINE STREET HARTFORD, CONNECTICUT
 SCALE 1"=20' DATED 10-6-80 REV. 10-18-80
 DRAWING NO. 1818

THE UNDERSIGNED UTILITY EMPLOYEE
 CERTIFIES THIS MAP TO BE
 A TRUE AND CORRECT COPY OF THE
 RECORD MAP AS FILED IN THE
 OFFICE OF THE REGISTER OF DEEDS
 OF THE CITY OF HARTFORD, CONNECTICUT
 PER *[Signature]*

Drawn by T.C.C. Check by R.T.G. Approved by P.P.

NO.	DATE	DESCRIPTION	BY
1	12/11/80	MOVED TRANSFORMER LOCATION	STK

THE HARTFORD ELECTRIC LIGHT CO.
 FACILITIES ON THE PROPERTY OF
 THOMAS K. STANDISH
 1 HARTFORD SQUARE WEST
 HARTFORD, CONNECTICUT
 NO. E-C-10448-1017
 SCALE 1"=20'
 DECEMBER 11, 1980

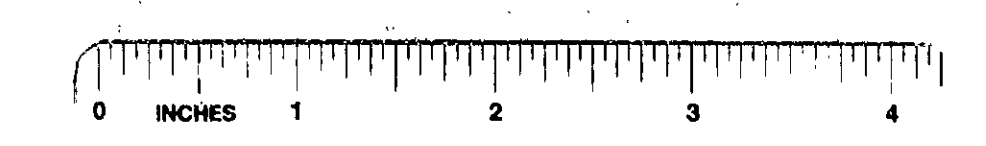

1125

5611