



1126-1

RECEIVED BY
Robert H. Miller
Dec 10 4 53 AM '84
TOWN & CITY CLERK
HARTFORD
VOL. _____ PAGE _____

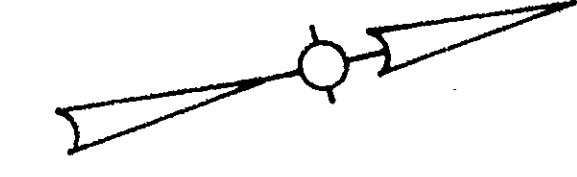

N/F BUSHNELL PLAZA APARTMENTS - STAGE II

BUSHNELL TOWER CONDOMINIUM

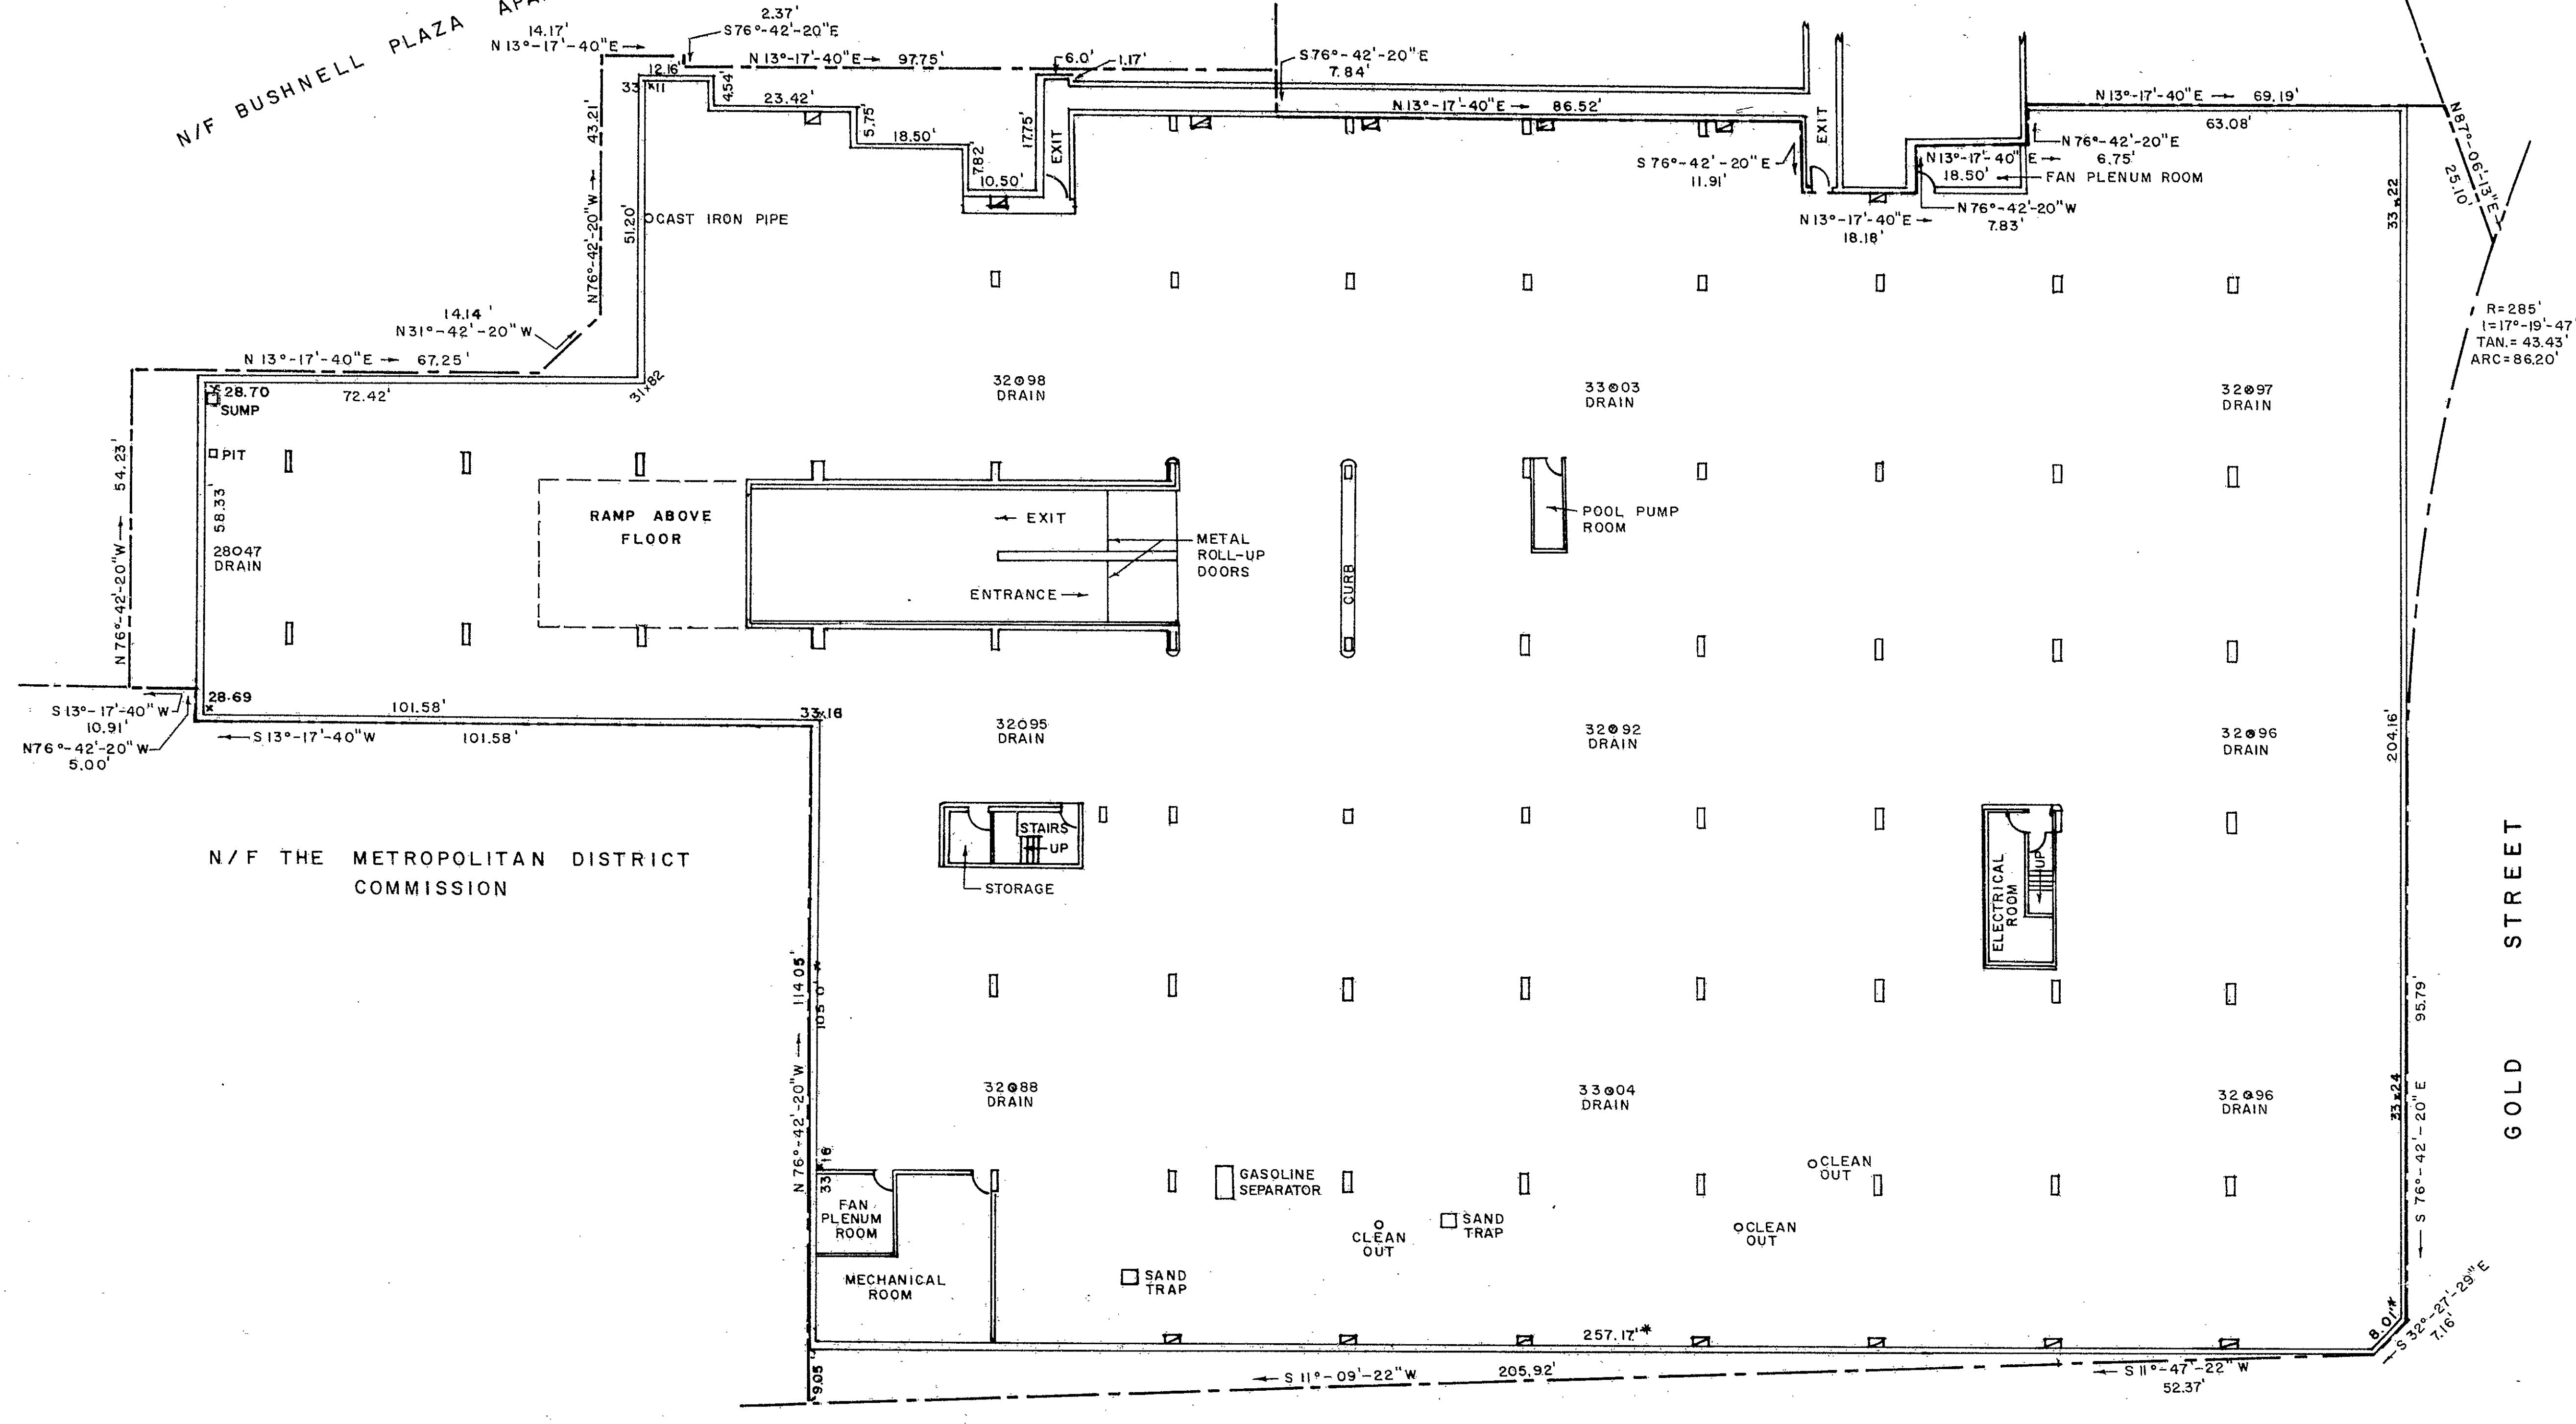

NOTES:
1. SEE SHEET 1 OF 2 FOR OVERHEAD UTILITIES.
2. SEE SHEET 1 OF 2 FOR NOTES.

LEGEND:
☐ GAS VENTS
□ COLUMNS
— BOUNDARY LINE

MAIN STREET


GOLD STREET

The portions of Main Street and Gold Street shown on this plan are established public streets of the City of Hartford.
Dec. 12, 1980

I hereby certify that this survey was actually made upon the ground on September 24, 1980, and that it and the bounds and measurements shown hereon are correct within the standards of a Class A-2 survey as defined in the Code of Recommended Practice for Standards of Accuracy of Surveys and Maps adopted December 10, 1975, as amended by the Connecticut Association of Land Surveyors, Inc., and that, unless otherwise shown, title lines and lines of actual possession are the same, the building is located as shown and does not encroach over or upon street, title or building lines, there are no violations of zoning regulations with reference to the location of said building, and there are no easements except as noted or encroachments affecting this property apparent from a careful inspection of the same.

May F. Shaw
Land Surveyor Conn. Reg. No. 5733

BUSHNELL PLAZA CONDOMINIUM GOLD STREET HARTFORD, CONNECTICUT			
date: 9/24/80	drawn by: K.C.	job no. 80135	
scale: 1/16" = 1'-0"	checked by: M.S.	sheet no. 2 OF 2	
STRAUSS ENGINEERING ASSOCIATES engineers • landscape architects • surveyors avon park north • avon, connecticut			

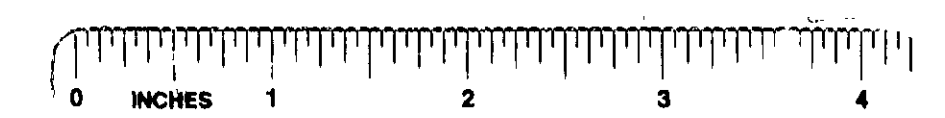

1126

426