


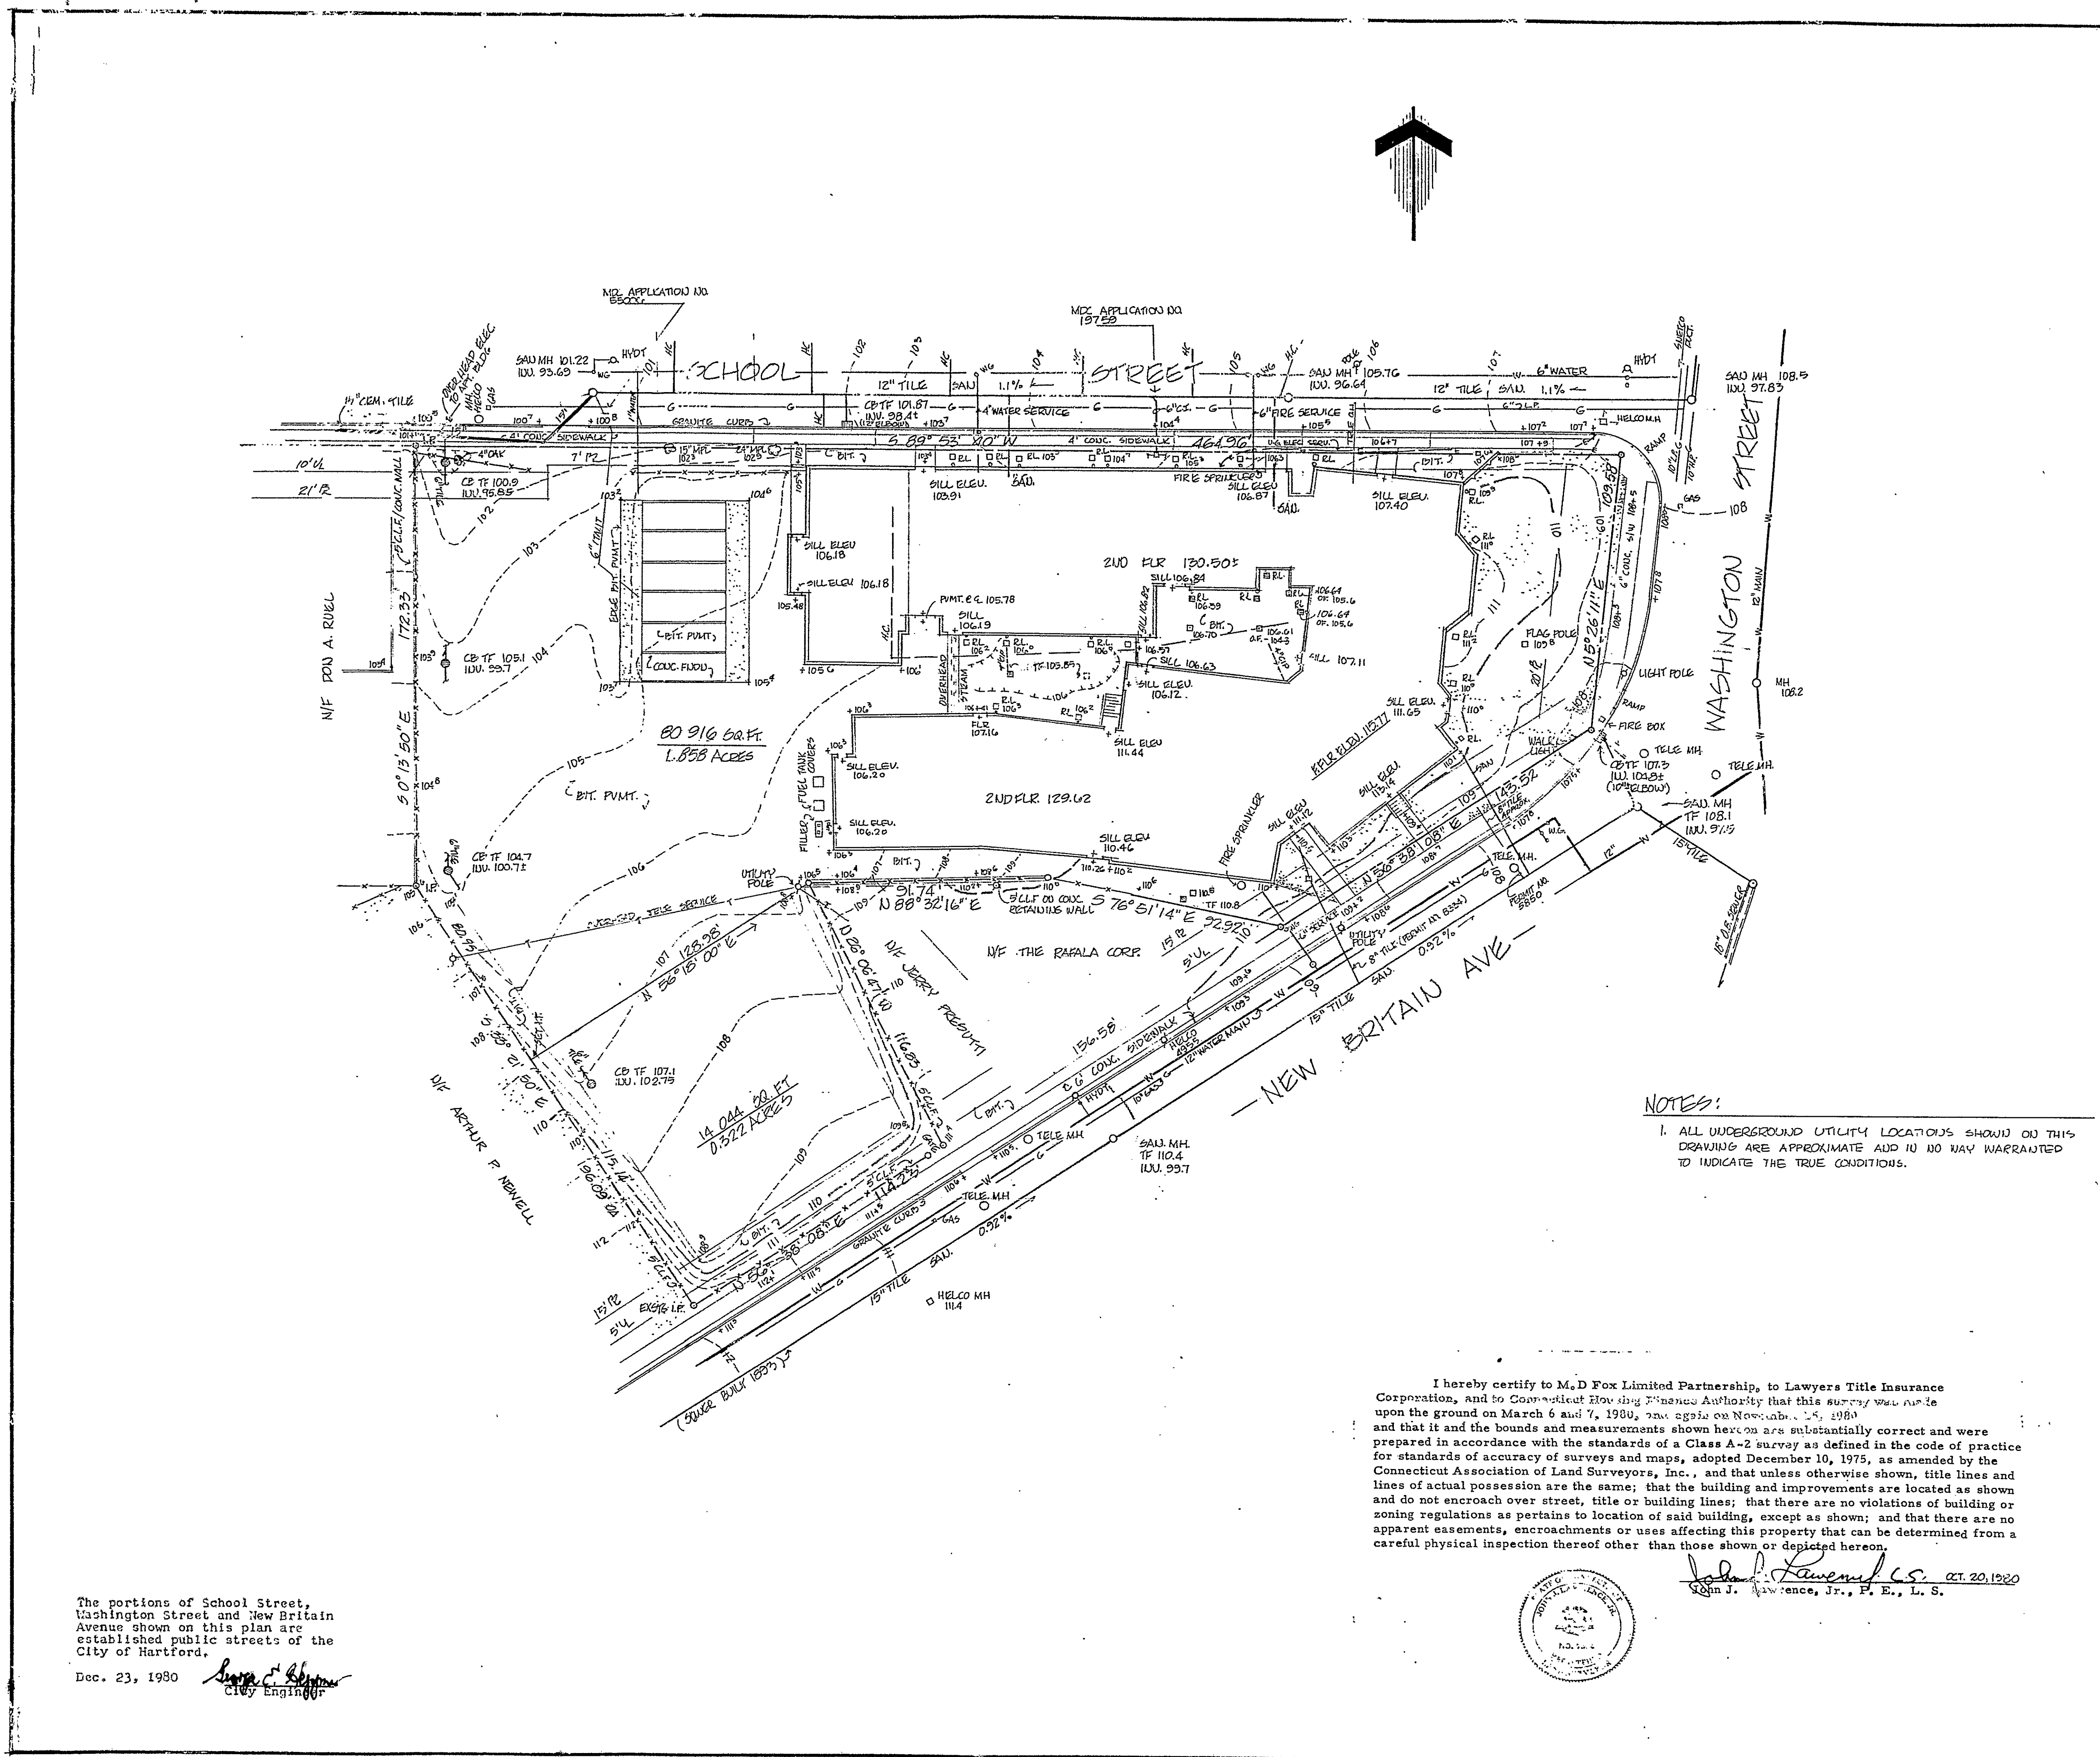

- LEGEND**
- CB — CATCH BASIN
  - MH — MANHOLE
  - RL — RAIN LEADER
  - HVDT — FIRE HYDRANT
  - WIG — WATERGATE
  - W — WATER
  - G — GAS
  - E — ELEC.
  - T — TELE
  - OF — OVER FLOW (GLOW)

| NO. | REVISION | DATE |
|-----|----------|------|
|-----|----------|------|

**PROPERTY SURVEY  
TOPOGRAPHY SURVEY**

**MICHAEL D. FOX SCHOOL**  
SCHOOL HOUSING PROJECT

**461 WASHINGTON STREET  
HARTFORD, CONN.**

**MARCH 1980** **SCALE: 1" = 30'**  
**NOVEMBER 1980**

| 7   | REVISE PLINGS - NF PRESENT NF BRAL    | NOVEMBER 23, 1980 |
|-----|---------------------------------------|-------------------|
| 6   | CERTIFICATION UP DATE                 | NOVEMBER 10, 1980 |
| 5   | PROPERTY LINE REVISION                |                   |
| 4   | REVISE CERTIFICATION                  |                   |
| 3   | C.H.E.A. CERTIFICATION                | OCTOBER 20, 1980  |
| 2   | COURT YARD GATES, INVERTS, ETC.       | JUNE 23, 1980     |
| 1   | UTILITIES ADDED (FROM AVAILABLE MAPS) | MAY 15, 1980      |
|     | OVERHEAD ELEC. SERVICE'S              | MARCH 20, 1980    |
| NO. | REVISION                              | DATE              |

**JOHN J. LAWRENCE & ASSOC., INC.**  
ENGINEERS  
FARMINGTON, CONNECTICUT

I hereby certify to M.D. Fox Limited Partnership, to Lawyers Title Insurance Corporation, and to Connecticut Building Finance Authority that this survey was made upon the ground on March 6 and 7, 1980, and again on November 1, 2, 3, 1980, and that it and the bounds and measurements shown hereon are substantially correct and were prepared in accordance with the standards of a Class A-2 survey as defined in the code of practice for standards of accuracy of surveys and maps, adopted December 10, 1975, as amended by the Connecticut Association of Land Surveyors, Inc., and that unless otherwise shown, title lines and lines of actual possession are the same; that the building and improvements are located as shown and do not encroach over street, title or building lines; that there are no violations of building or zoning regulations as pertain to location of said building, except as shown; and that there are no apparent easements, encroachments or uses affecting this property that can be determined from a careful physical inspection thereof other than those shown or depicted hereon.

*John J. Lawrence, Jr., P. E., L. S.* OCT. 20, 1980  
John J. Lawrence, Jr., P. E., L. S.

The portions of School Street, Washington Street and New Britain Avenue shown on this plan are established public streets of the City of Hartford.  
City Engineer

