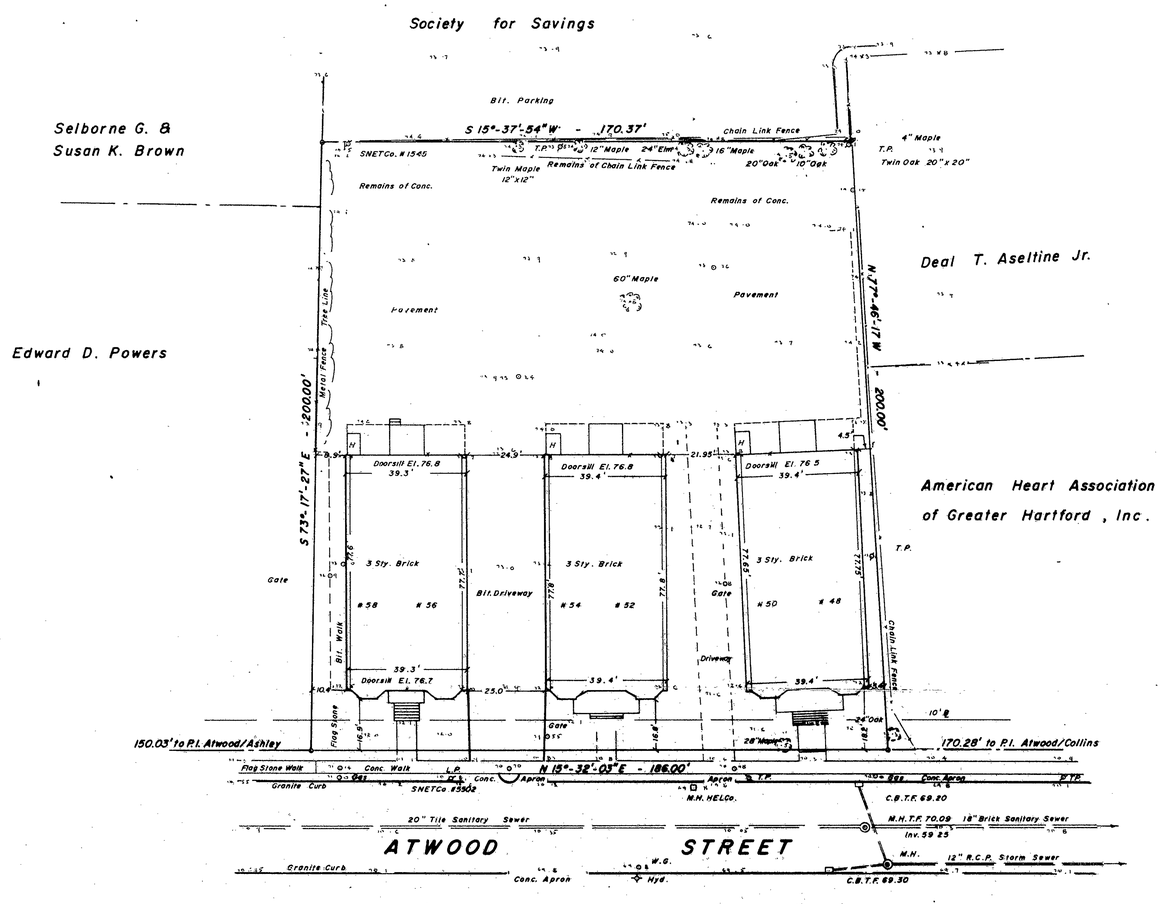

Zone R-2
Area = 35 603 s.f. (0.817 ac.)

ATWOOD STREET CONDOMINIUM

HARTFORD, CONN.

NOTE:
Elevation based on MDC Datum
Mon. HH-97 El. 71.44

U S Life Title Insurance Co. of New York
Colonial Bank & Trust Co.

The position of proposed Street shown on this plan is as established public street of the City of Hartford.

Jan. 8, 1981
City Engineer

I HEREBY CERTIFY THAT THIS MAP AND SURVEY WERE PREPARED IN ACCORDANCE WITH THE STANDARDS OF A CLASS A-2 SURVEY AS DEFINED IN THE CODE OF PRACTICE FOR STANDARDS OF ACCURACY OF SURVEYS AND MAPS, ADOPTED DECEMBER 10, 1975 AS AMENDED BY THE CONNECTICUT ASSOCIATION OF LAND SURVEYORS, INC.

8-11-80 DATE — 3756 REGISTRATION No.

Revised 11-15-80
Lots Dimensions 10-22-80

IGOR VECHESLOFF
PROFESSIONAL ENGINEER & LAND SURVEYOR
51 LORRAINE STREET
HARTFORD, CONNECTICUT

SCALE 1" = 20'	DATE 8-11-80
	DRAWING NO. 1836

RECEIVED BY
Jan 7 11 08 AM '81
TOWN & CITY CLERK
HARTFORD
VOL. ____ PAGE ____

1128

8811

464027

#113