


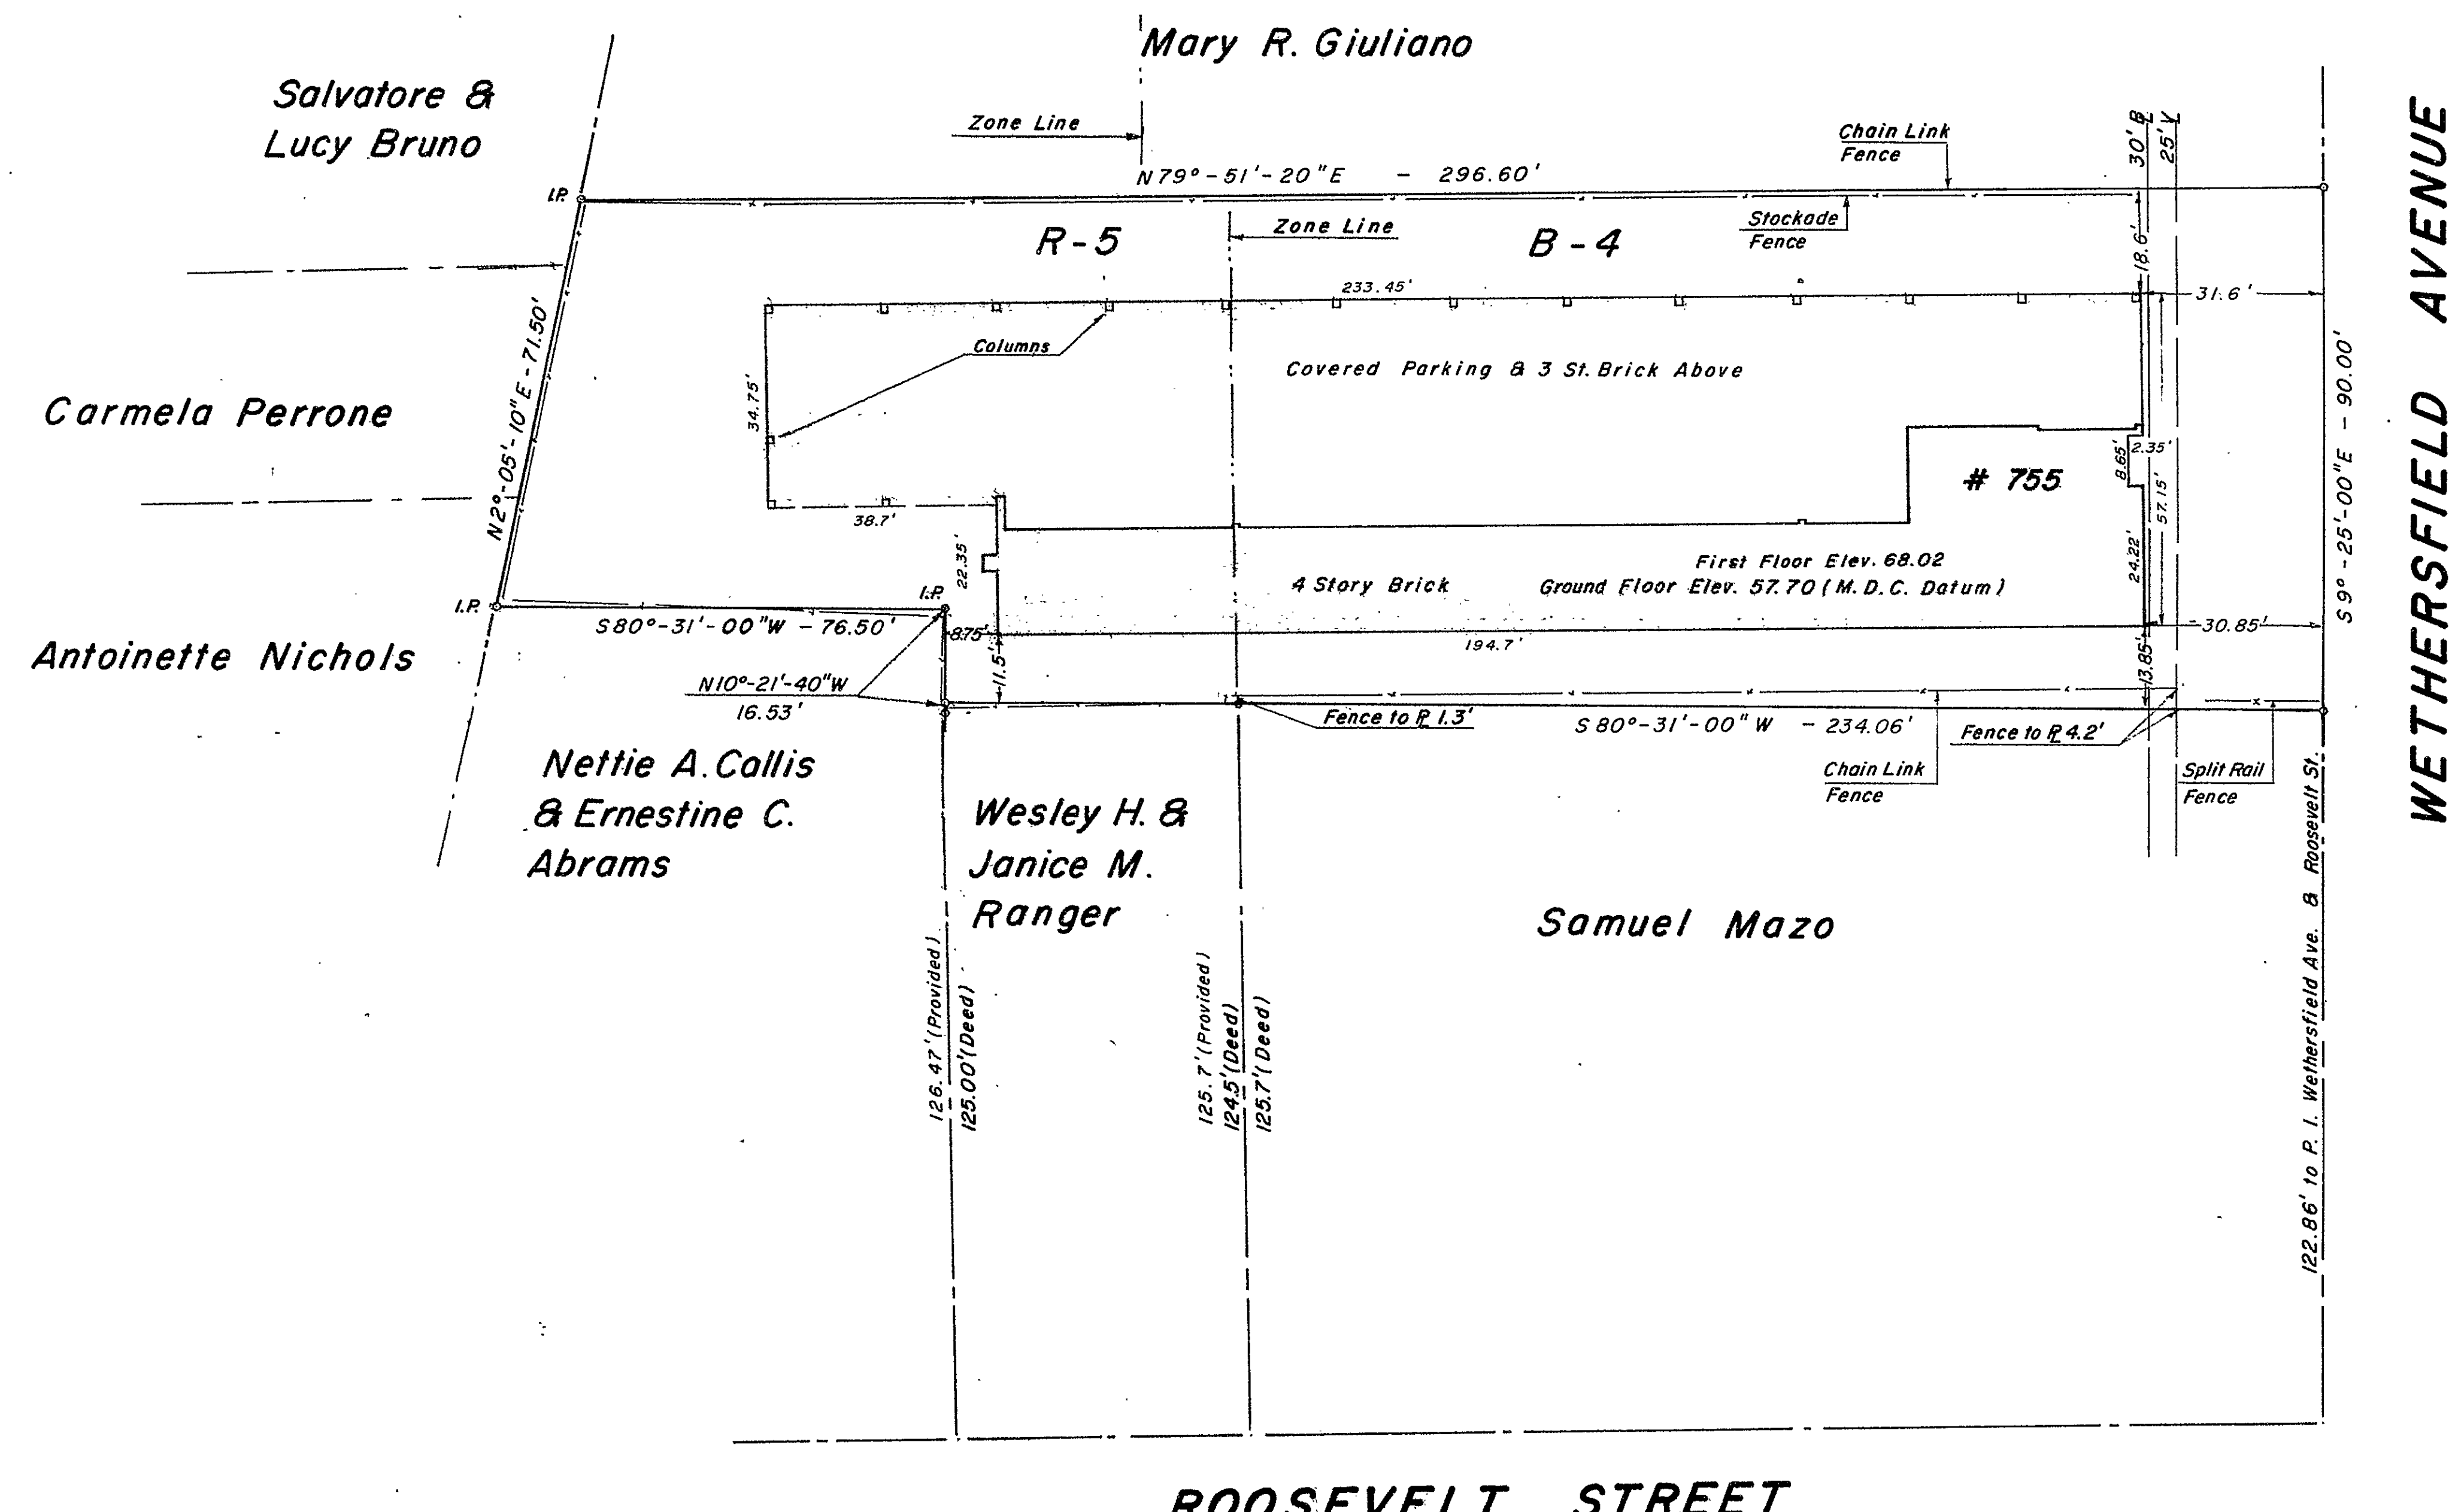

Area = 25652 s.f. (0.59 ac.)

PROPERTY OF
H. RAY ADAMS d/b/a L. APARTMENTS,
to be declared as a conversion condominium named
WETHERSFORD CONDOMINIUM
HARTFORD, CONN.

The portions of Wethersfield Avenue
and Roosevelt Street shown on this
plan are established public streets
of the City of Hartford.
Jan. 19, 1981
George C. Neppner
City Engineer

I HEREBY CERTIFY THAT THIS MAP AND SURVEY WERE PREPARED IN ACCORDANCE
WITH THE STANDARDS OF A CLASS A-2 SURVEY AS DEFINED IN THE CODE OF
PRACTICE FOR STANDARDS OF ACCURACY FOR SURVEYS AND MAPS, ADOPTED
DECEMBER 10, 1975 AS AMENDED BY THE CONNECTICUT ASSOCIATION OF LAND
SURVEYORS, INC.
11-10-80 3756
DATE REGISTRATION NO.

IGOR VECHESLOFF
PROFESSIONAL ENGINEER & LAND SURVEYOR
51 LORRAINE STREET
HARTFORD, CONNECTICUT
SCALE 1" = 20'
DATE 11-10-80
DRAWING NO. 1855



1131

1131

1131

RECEIVED BY
Robert A. Adams
JAN 19 2 27 PM '81
TOWN ENGINEER
HARTFORD
PAGE 1