


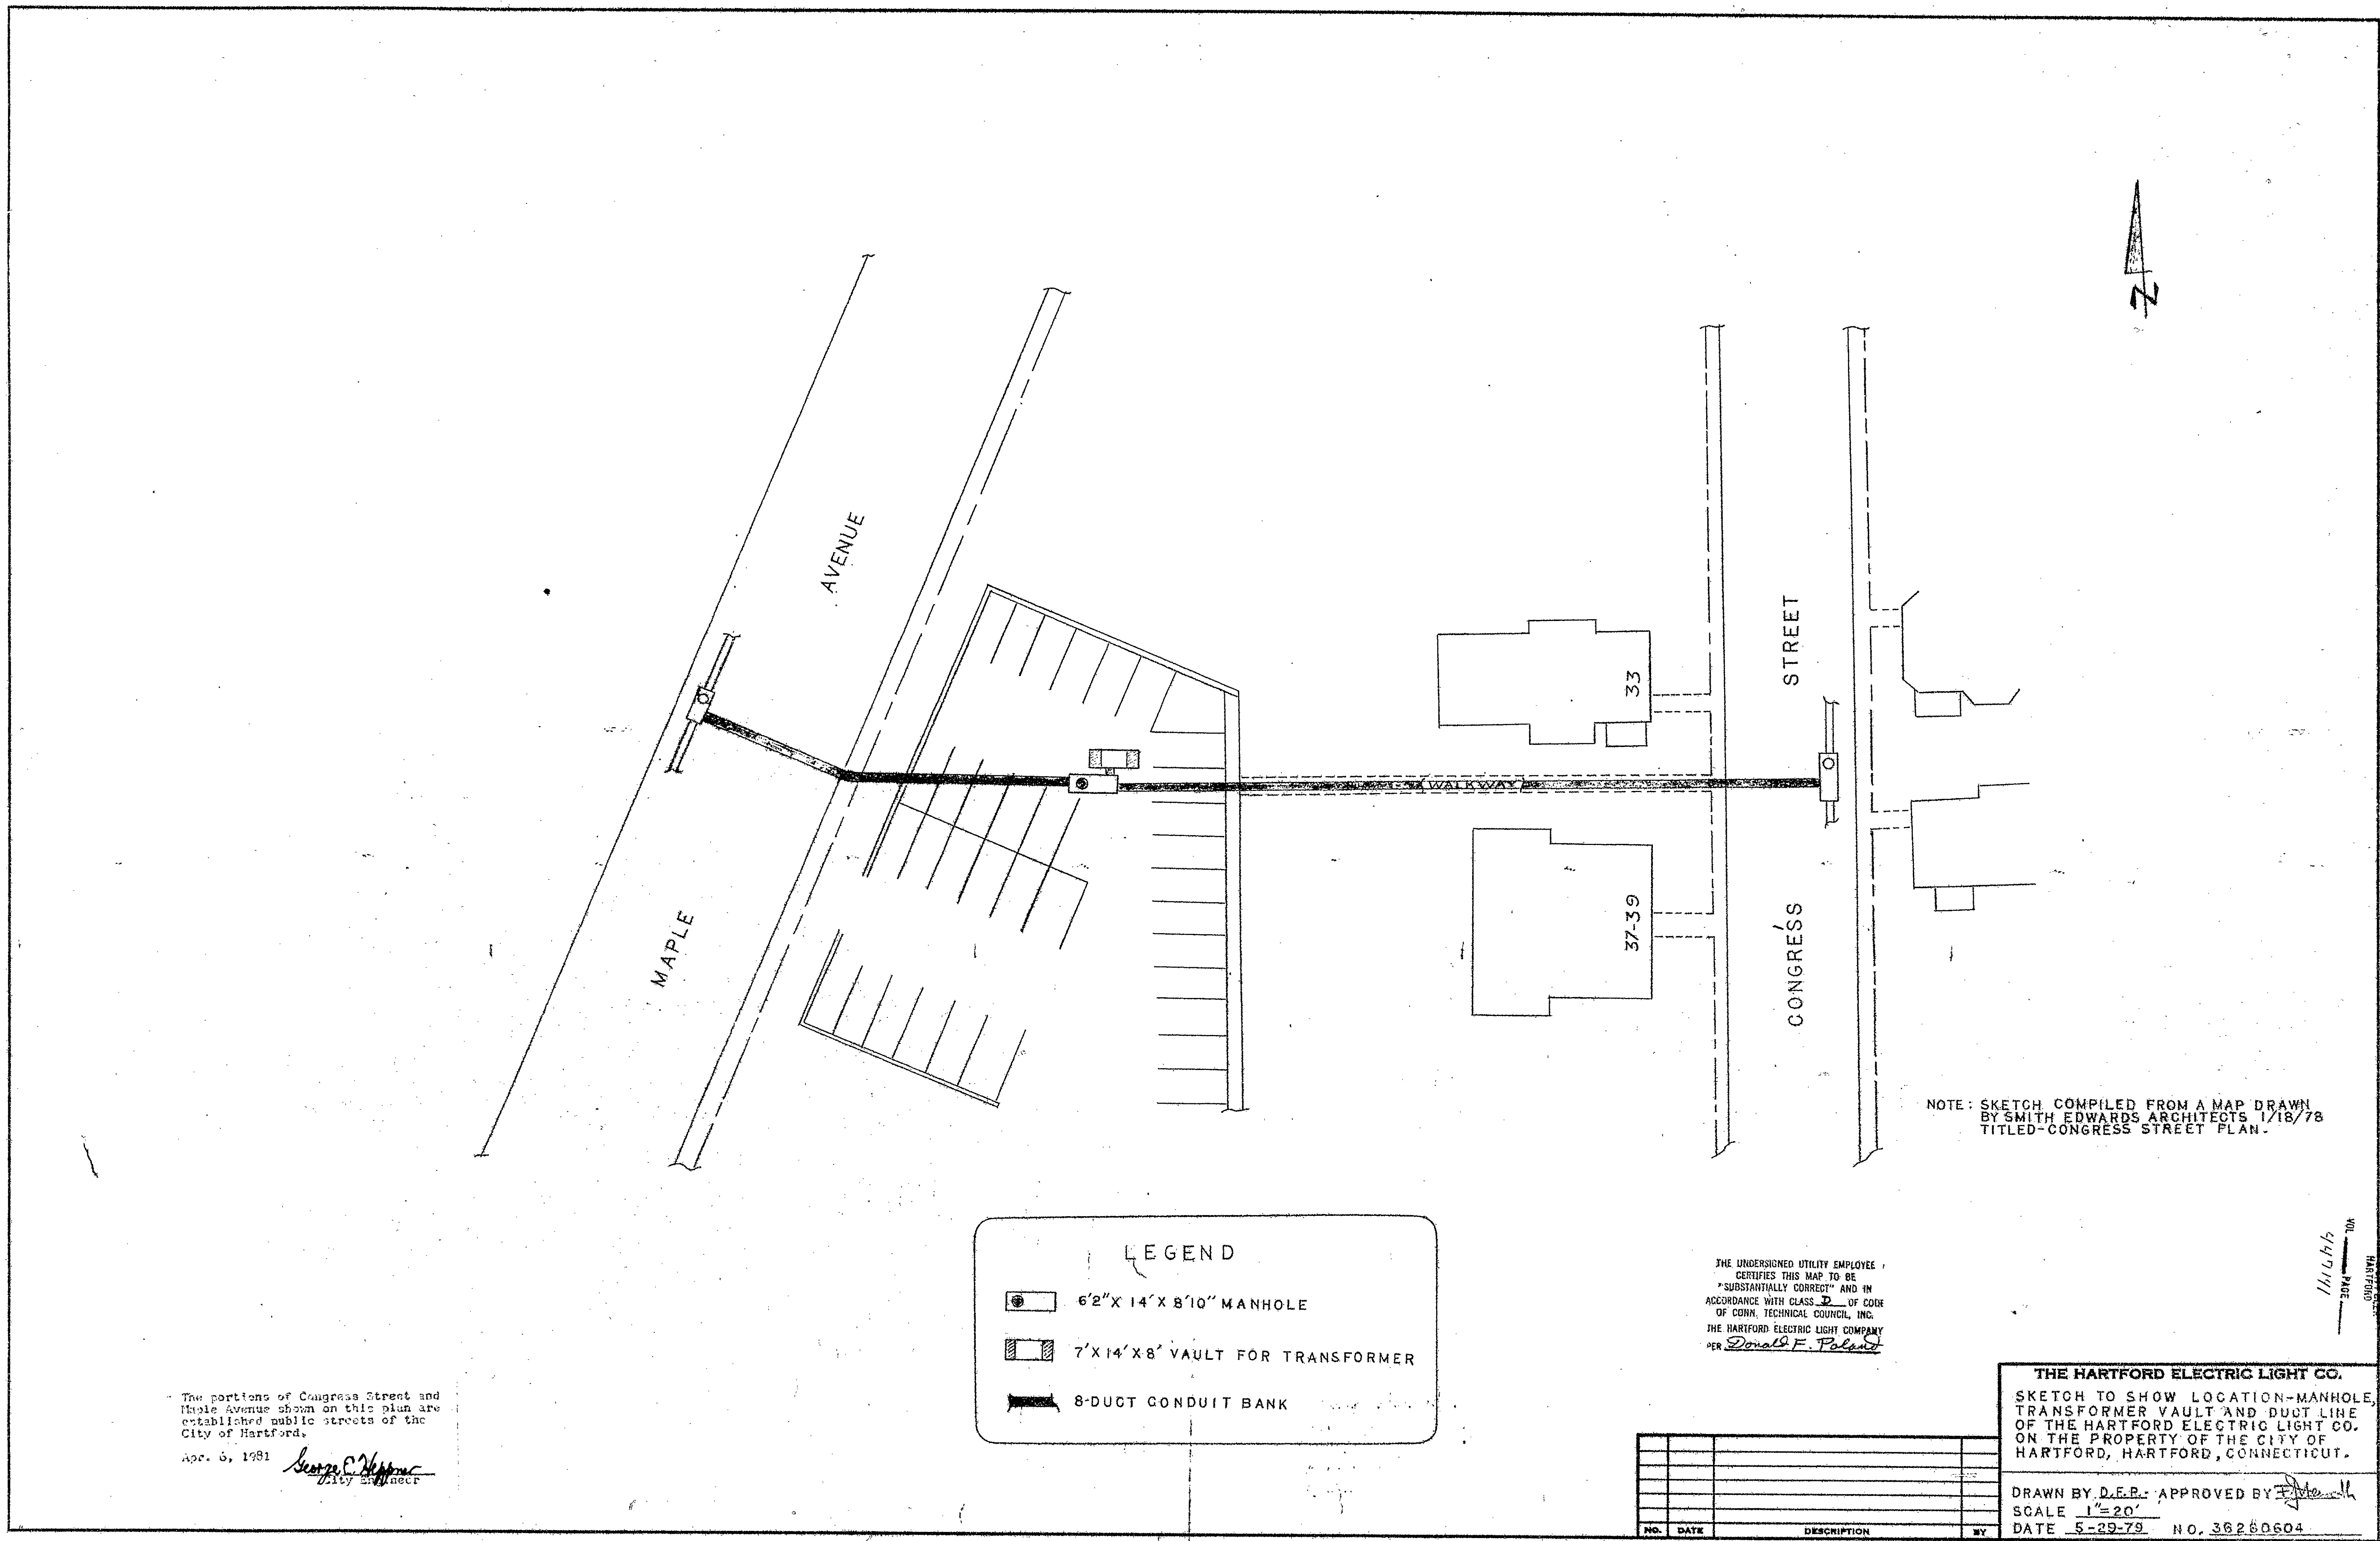

The portions of Congress Street and Maple Avenue shown on this plan are established public streets of the City of Hartford.
Apr. 6, 1981
George E. Higgins
City Engineer

LEGEND

- 6'2" X 14' X 8'10" MANHOLE
- 7' X 14' X 8' VAULT FOR TRANSFORMER
- 8-DUCT CONDUIT BANK

THE UNDERSIGNED UTILITY EMPLOYEE,
CERTIFIES THIS MAP TO BE
"SUBSTANTIALLY CORRECT" AND IN
OF CONN. TECHNICAL COUNCIL, INC.
THE HARTFORD ELECTRIC LIGHT COMPANY
PER *Donald F. Poland*

NO.	DATE	DESCRIPTION	BY

THE HARTFORD ELECTRIC LIGHT CO.
SKETCH TO SHOW LOCATION-MANHOLE,
TRANSFORMER VAULT AND DUCT LINE
OF THE HARTFORD ELECTRIC LIGHT CO.
ON THE PROPERTY OF THE CITY OF
HARTFORD, HARTFORD, CONNECTICUT.

DRAWN BY *D.F.P.* APPROVED BY *[Signature]*
SCALE 1"=20'
DATE 5-29-79 NO. 36260604