



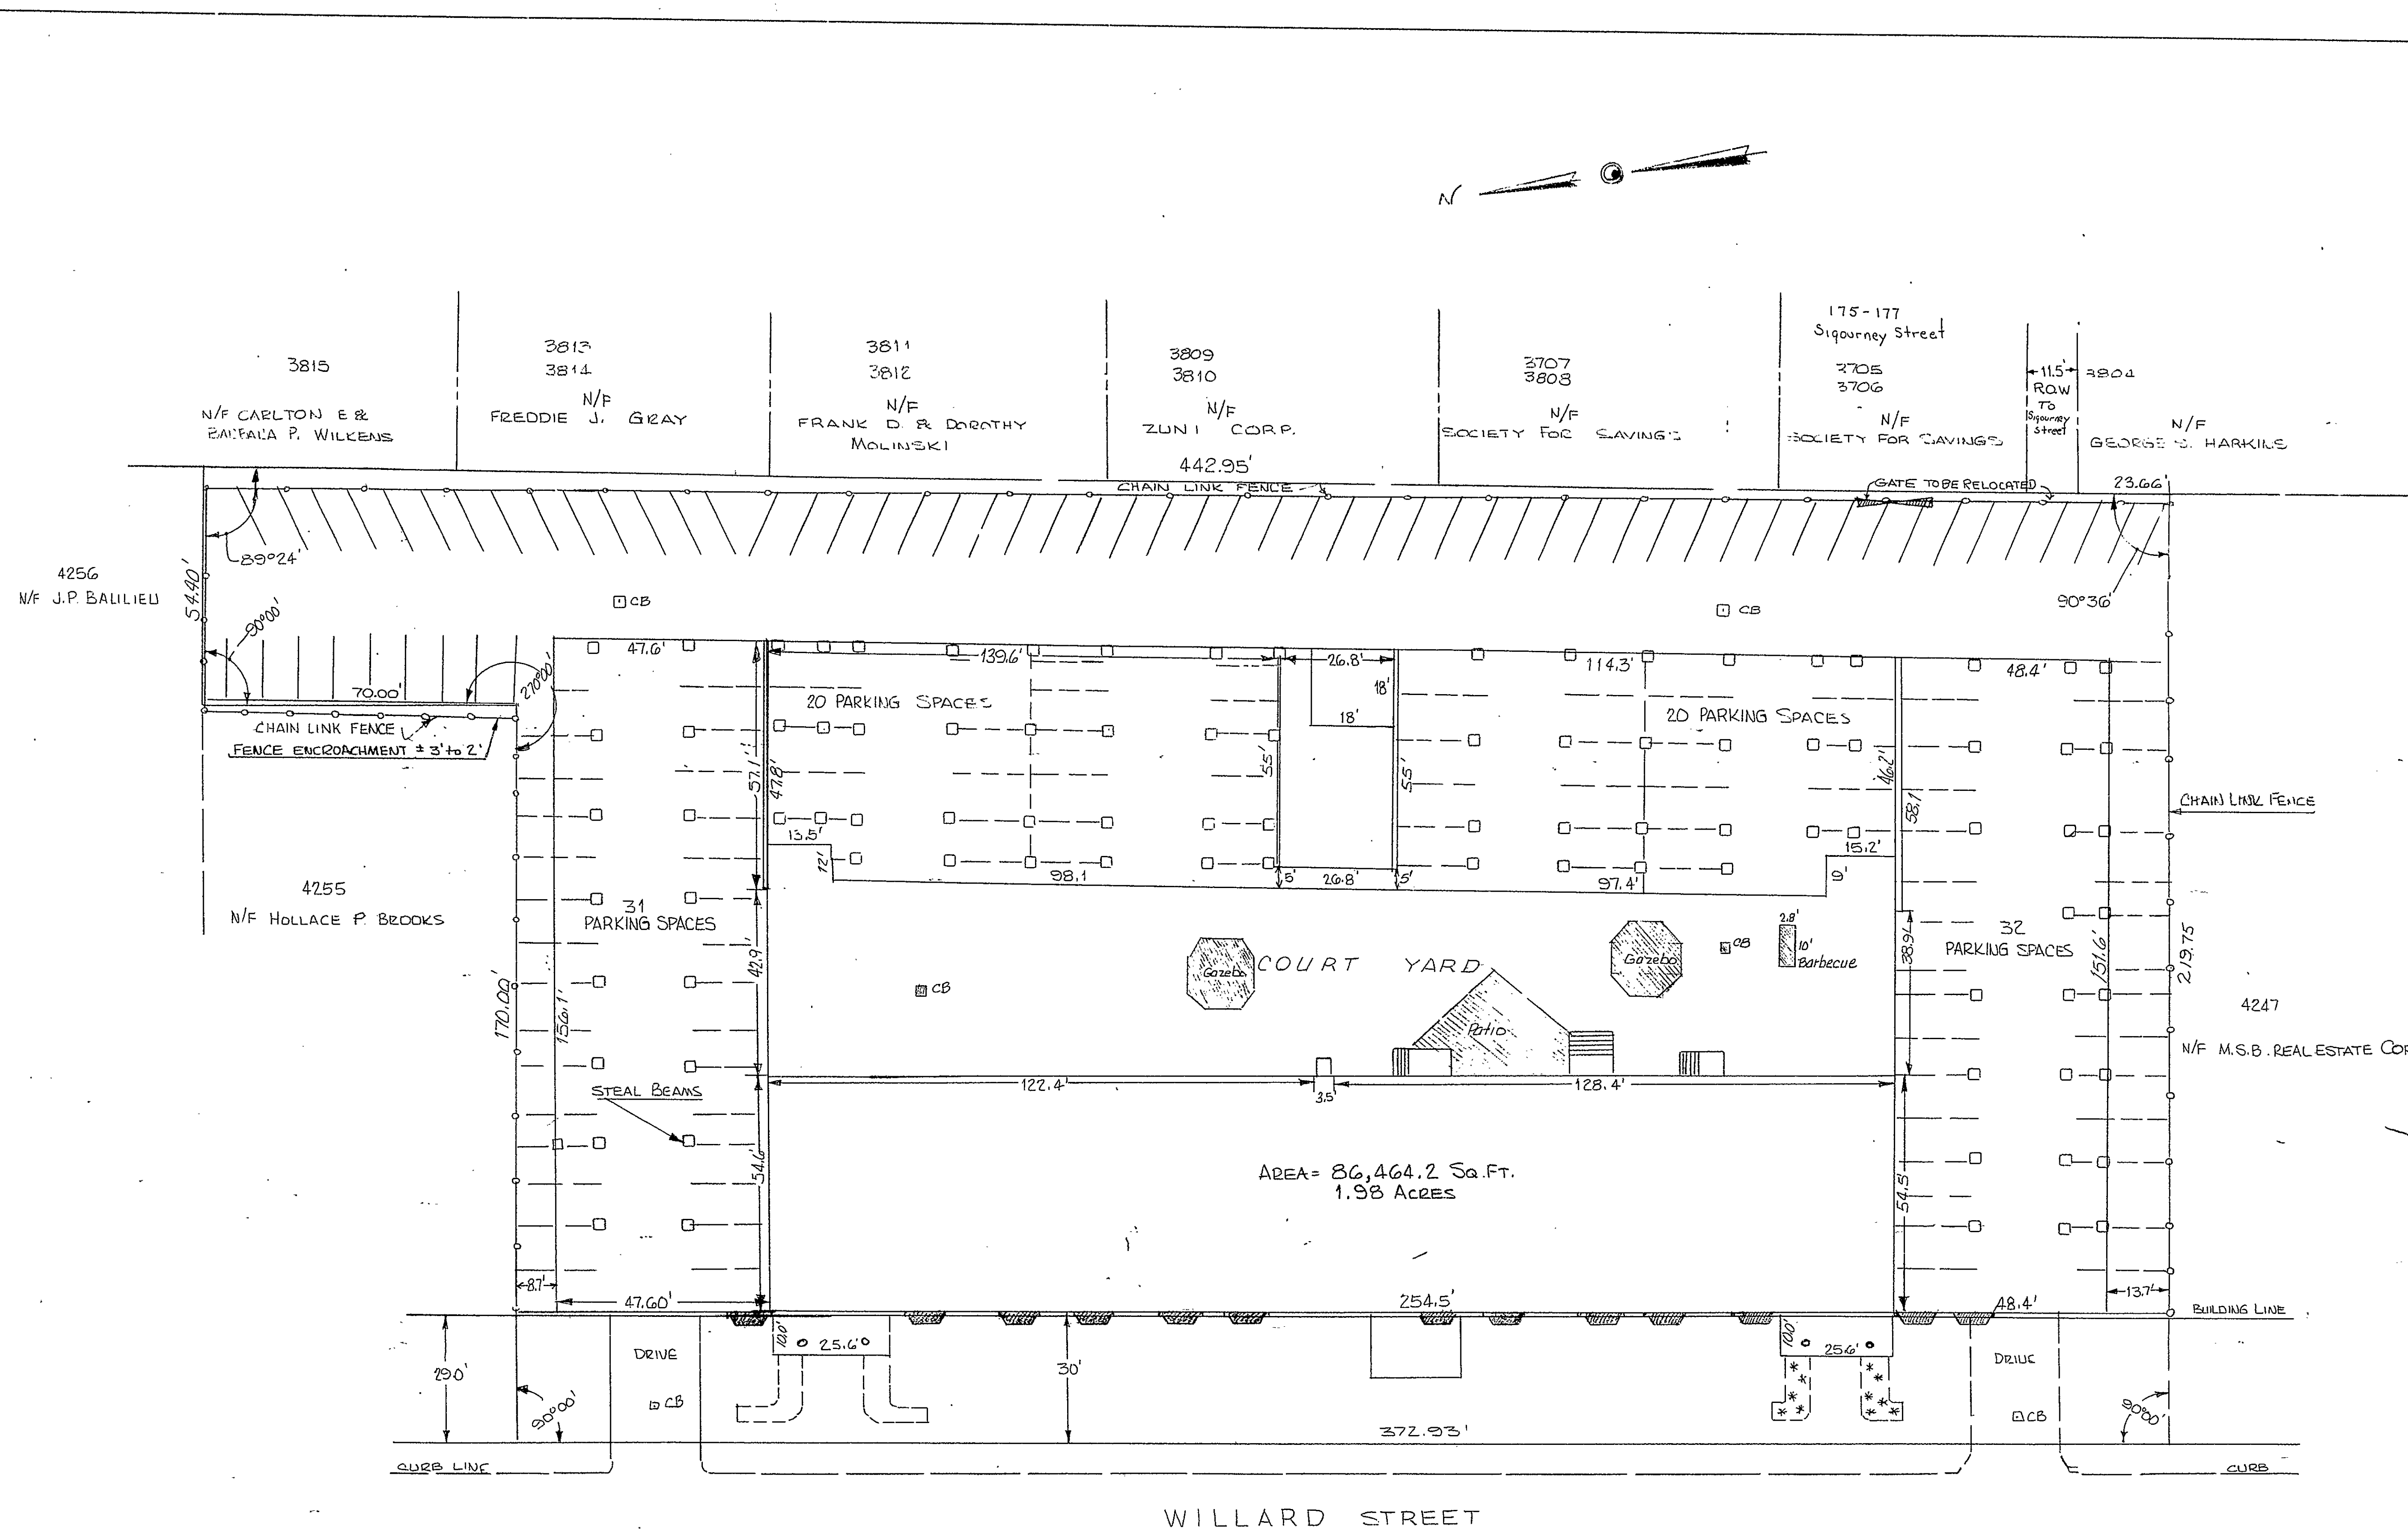

The portion of Willard Street shown on this plan is an established public street of the City of Hartford.
 Apr. 6, 1981
George E. Nye
 City Engineer

PROPERTY OF SOCIETY FOR SAVINGS 34 ~ 50 WILLARD STREET WILLARD SQUARE CONDOMINIUM ASSOC. INC. AS MODIFIED 1-28-81 TOWN OF HARTFORD, CONN.	I HEREBY CERTIFY THAT THIS MAP & SURVEY WERE PREPARED IN ACCORDANCE WITH THE STANDARDS OF CLASS 1 SURVEY AS DEFINED IN THE CODE OF PRACTICE FOR STANDARDS AND ACCURACY OF SURVEY & MAPS ADOPTED DECEMBER 10, 1975 AS AMENDED BY THE CONN. ASSOCIATION OF LAND SURVEYORS, INC.	ALCA SURVEY ASSOCIATES CARL H. JAEGER L.S. 7763 WETHERSFIELD, CONN. <i>Carl H. Jaeger</i> SCALE: 1" = 20' DATE: 11-1979	SHEET 1 OF 1
---	--	--	---------------------

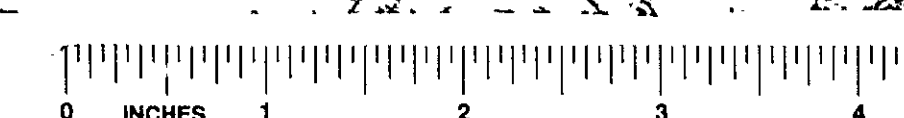

1140
 E&S FILE CORP. BUREAU, CA
 EPH 43