1146-1

The portion of Hungerford Street shown on this plan is an established public street of the City of Hartford.

June 4, 1981 George E. Hepsmer
City Engineer

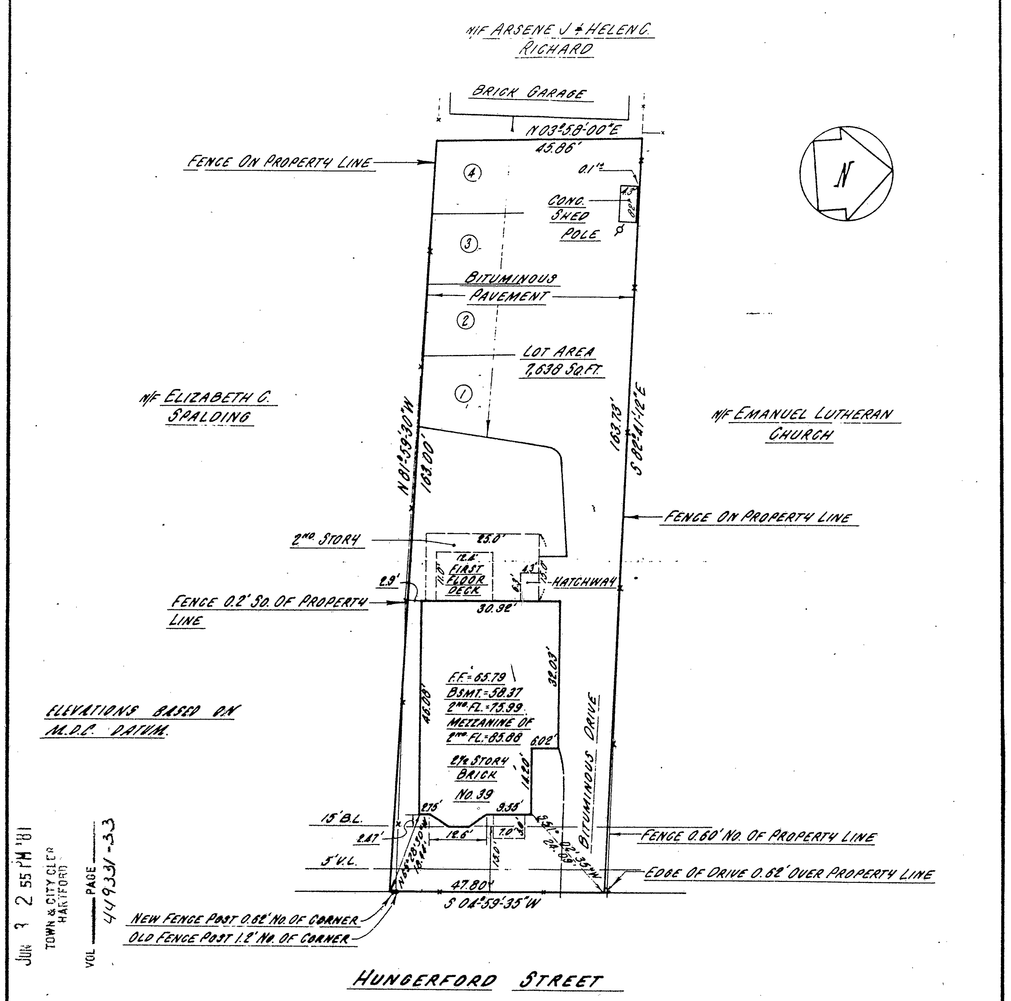

ELEVATIONS BASED ON M.D.C. DATUM.

NOTE:
SIDE YARD NON-CONFORMING UNDER PRESENT ZONING

I hereby certify that this map and survey was prepared in accordance with the standards of a Class A-2 survey as defined in the Code of Practice for Standards of Accuracy of Surveys and Maps adopted December 10, 1975, and as amended by the Connecticut Association of Land Surveyors Inc.

CLOSE, JENSEN & MILLER
Civil Engineers & Surveyors
By John H. Miller

CLOSE, JENSEN & MILLER
CONSULTING ENGINEERS, LAND PLANNERS & SURVEYORS
449 SILAS DEANE HIGHWAY WETHERSFIELD, CONNECTICUT

HUNGERFORD COURT
CONDOMINIUM
39 HUNGERFORD STREET
HARTFORD, CONNECTICUT

REVISIONS

EXHIBIT D TO THE DECLARATION.

DESIGNED	
DRAWN	R.B.B.
CHECKED	J.H.M.
DATE	OCT. 1980
SCALE	1"=20'
SHEET	1 OF 1
FILE NO.	

STATE OF CONNECTICUT JOHN H. MILLER No. 4142 REGISTERED LAND SURVEYOR

RECEIVED BY
JUN 3 2 55 PM '81
TOWN & CITY CLERK HARTFORD
VOL 4493 PAGE 31-33

EASI FILE CORP. IRVINE CA EFH 34 1146

1146