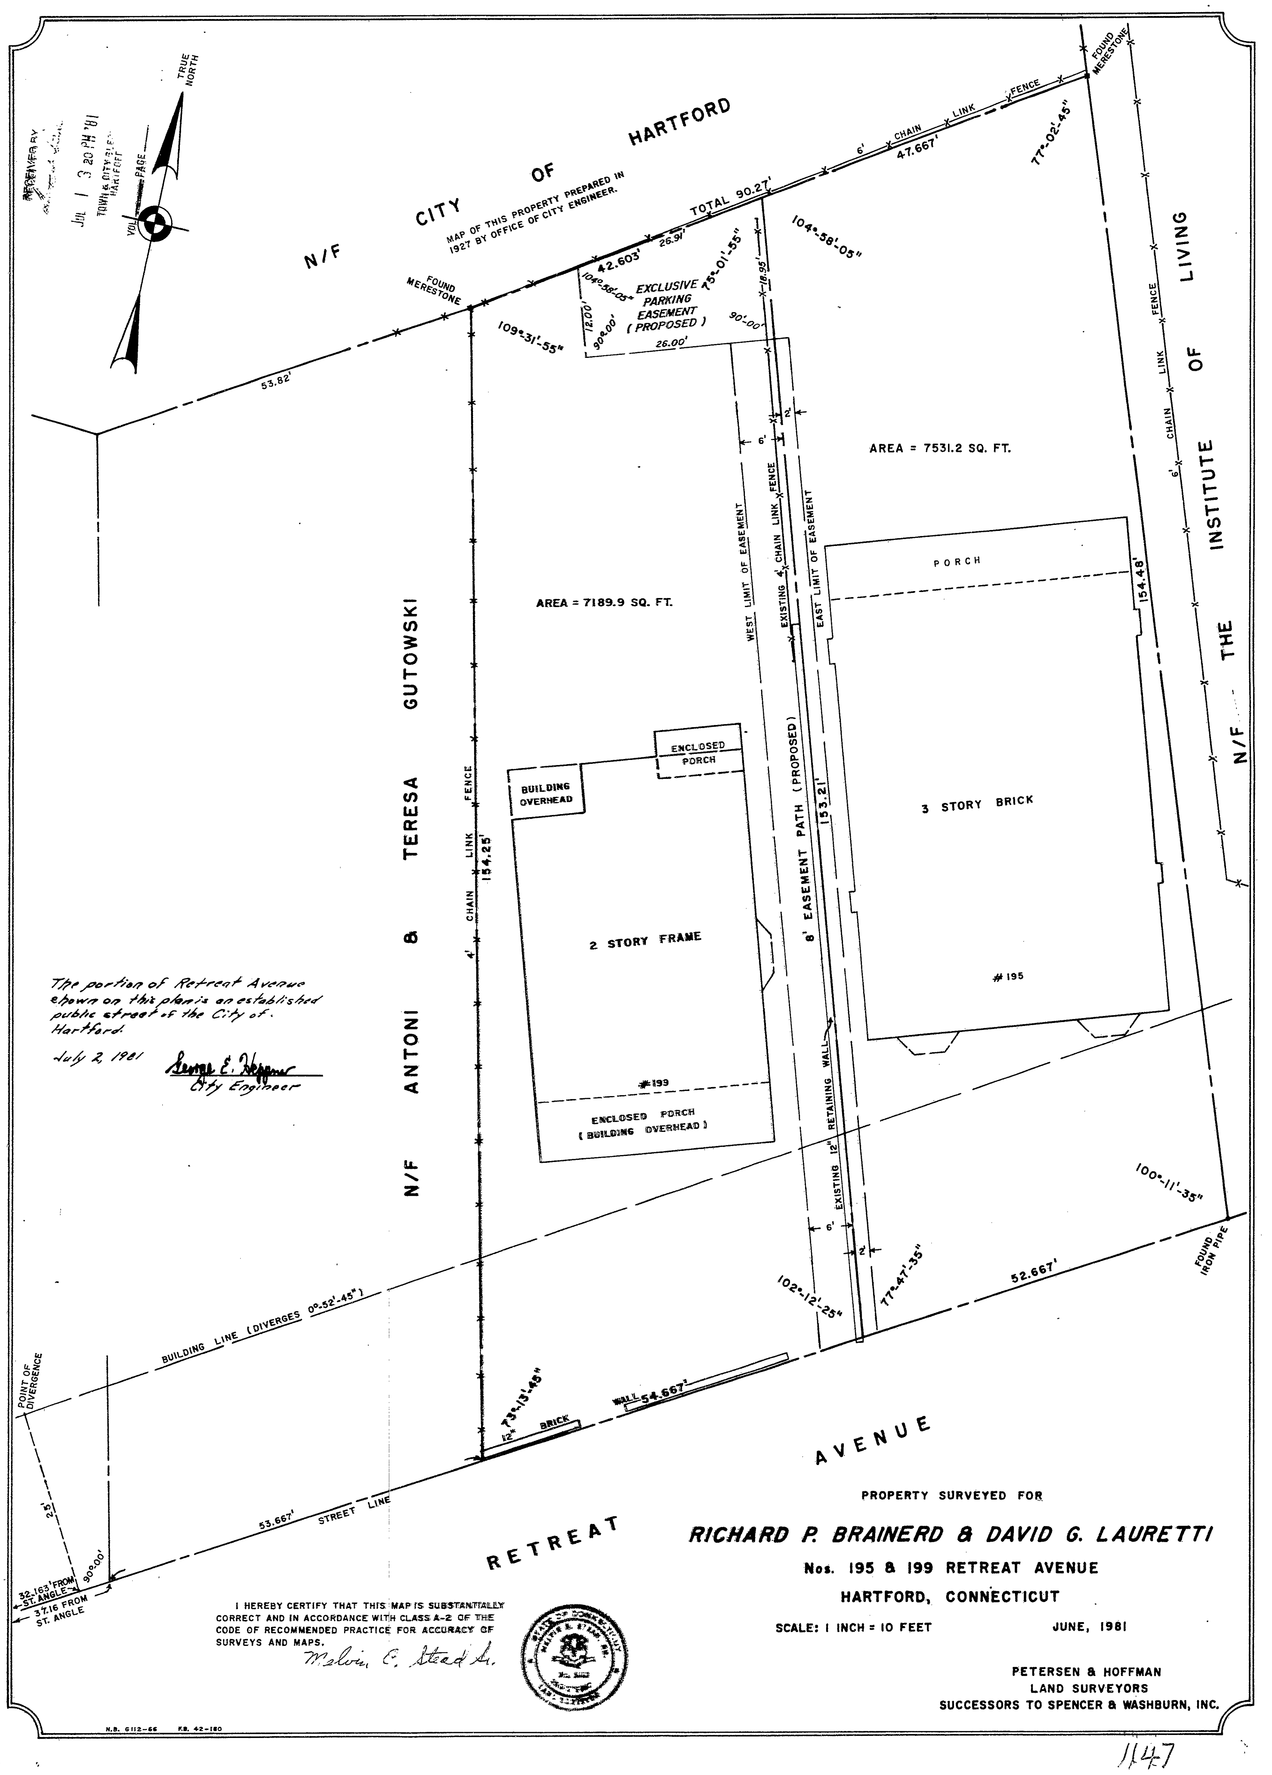

The portion of Retreat Avenue shown on this plan is an established public street of the City of Hartford.

July 2, 1981 George E. Kelsey
City Engineer

PROPERTY SURVEYED FOR

RICHARD P. BRAINERD & DAVID G. LAURETTI

Nos. 195 & 199 RETREAT AVENUE

HARTFORD, CONNECTICUT

SCALE: 1 INCH = 10 FEET JUNE, 1981

I HEREBY CERTIFY THAT THIS MAP IS SUBSTANTIALLY CORRECT AND IN ACCORDANCE WITH CLASS A-2 OF THE CODE OF RECOMMENDED PRACTICE FOR ACCURACY OF SURVEYS AND MAPS.

Melvin E. Stead Jr.

STATE OF CONNECTICUT MELVIN E. STEAD JR. No. 5113 LAND SURVEYOR

PETERSEN & HOFFMAN
LAND SURVEYORS
SUCCESSORS TO SPENCER & WASHBURN, INC.

N.B. 6112-66 F.B. 42-180


1147

1147