


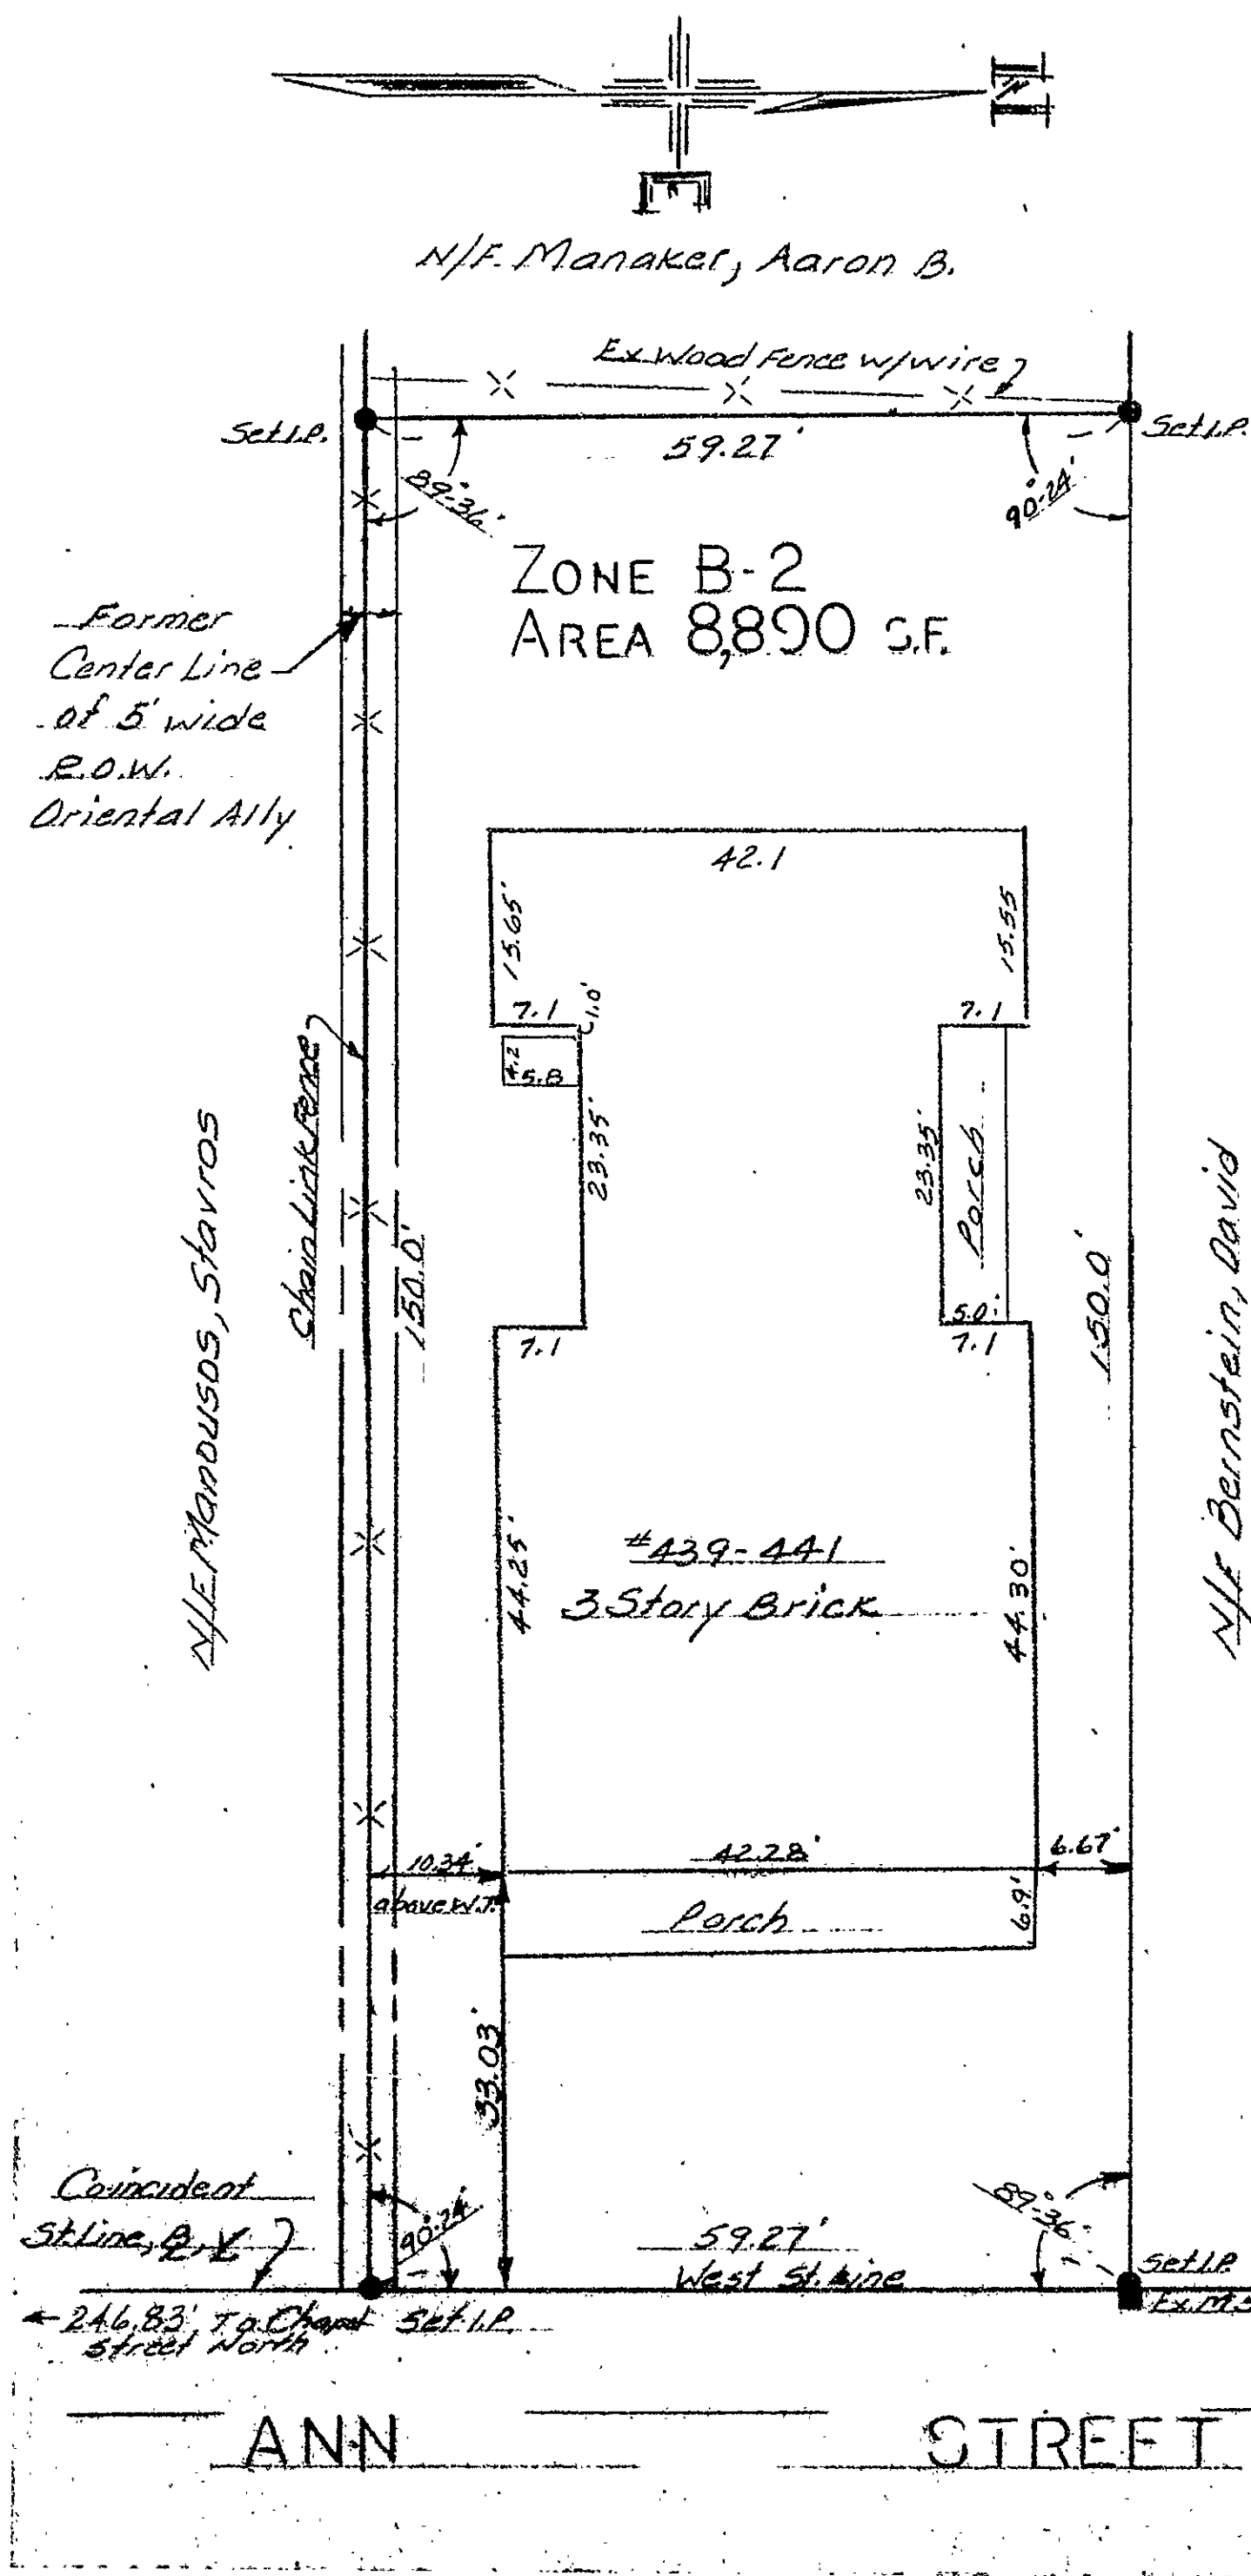


PLOT PLAN
PROPERTY OF
SANTINA SPAGNA
439-441 ANN STREET
HARTFORD, CONN.
SCALE: 1"=20'
MAY 1981

Reference made to map entitled
"MAP OF ORIENTAL ALLEY, City of
Hartford, Department of Engineering,
Showing the present centerline which
by mutual agreement is to become the
division line between adjacent
properties, Scale 1"=20', Nov. 30,
1929."

Building and Lot Non-Conforming to
present zoning regulations, but,
it pre-exist the current adoption
of the zoning regulations.

CERTIFIED SUBSTANTIALLY CORRECT

Robert R. Messier, L.S.
SURVEYOR

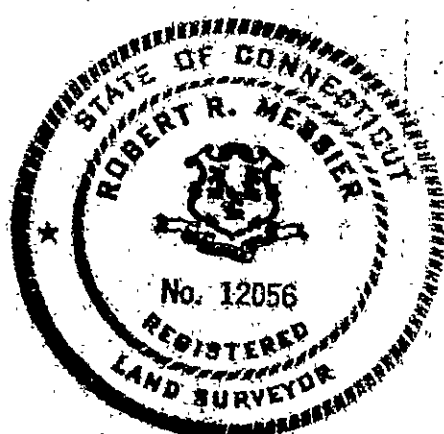

The portion of Ann Street
shown on this plan is an
established public street
of the City of Hartford

June 22, 1981

George E. Higgins
City Engineer

RECEIVED BY
JUL 18 2 23 PM '81
TOWN & CITY CLERK
HARTFORD

1147

