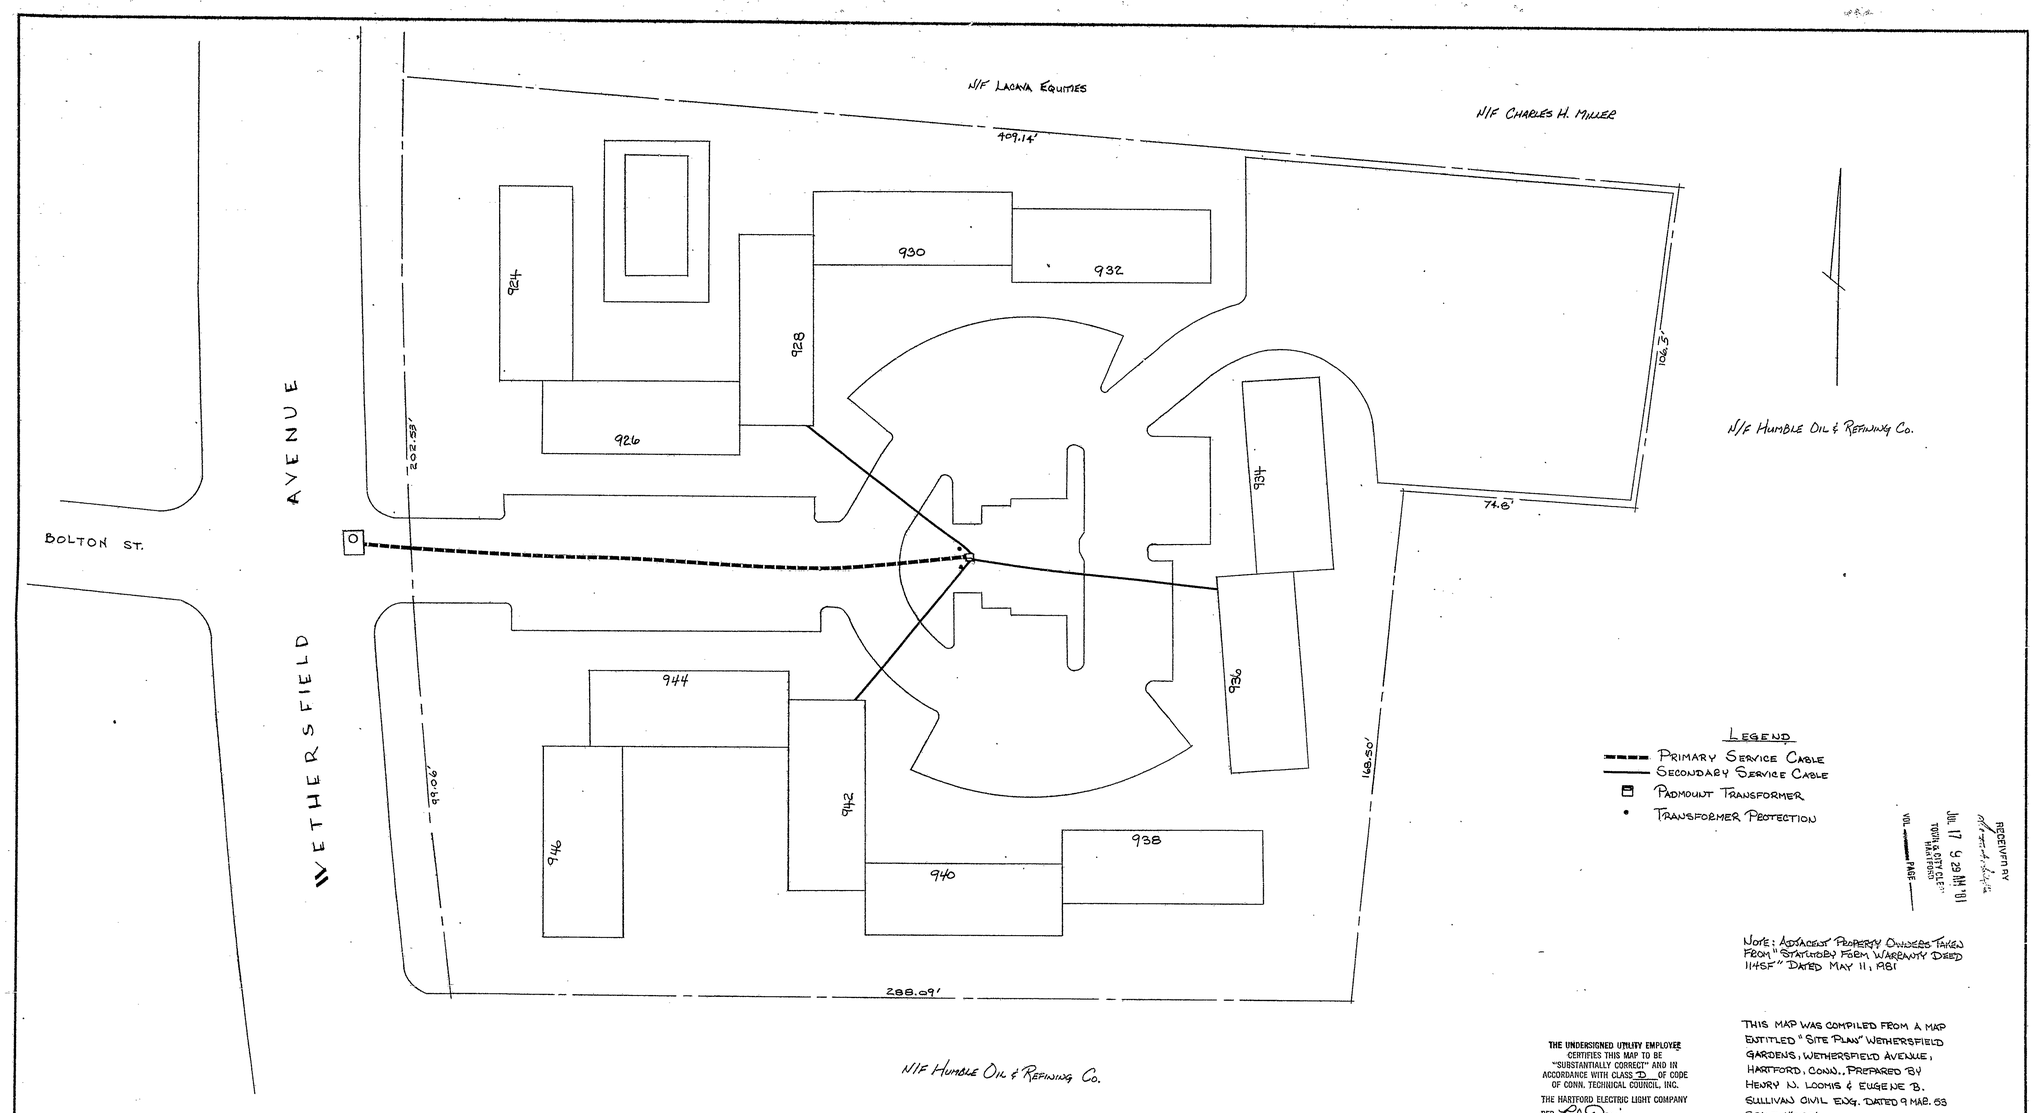

LEGEND

- PRIMARY SERVICE CABLE
- SECONDARY SERVICE CABLE
- PADMOUNT TRANSFORMER
- TRANSFORMER PROTECTION

RECEIVED BY
JUL 17 9 29 AM '81
TOWN & CITY CLERK
HARTFORD
VOL. ____ PAGE ____

NOTE: ADJACENT PROPERTY OWNERS TAKEN FROM "STATCHBY FROM WARRANTY DEED 1145F" DATED MAY 11, 1981

THE UNDERSIGNED UTILITY EMPLOYEE CERTIFIES THIS MAP TO BE "SUBSTANTIALLY CORRECT" AND IN ACCORDANCE WITH CLASS D OF CODE OF CONN. TECHNICAL COUNCIL, INC.

THE HARTFORD ELECTRIC LIGHT COMPANY
PER [signature]

THIS MAP WAS COMPILED FROM A MAP ENTITLED "SITE PLAN" WETHERSFIELD GARDENS, WETHERSFIELD AVENUE, HARTFORD, CONN., PREPARED BY HENRY N. LOOMIS & EUGENE B. SULLIVAN CIVIL ENG. DATED 9 MAR. 53
SCALE 1"=20'

The portions of Wethersfield Avenue and Bolton Street shown on this plan are established public streets of the City of Hartford.

July 17, 1981

[signature]
City Engineer

CHECKED BY RJD
APPROVED BY [illegible]

NO.	DATE	DESCRIPTION	BY

REVISIONS

THE HARTFORD ELECTRIC LIGHT CO.

FACILITIES ON THE PROPERTY OF WETHERSFIELD GARDENS ASSOCIATES LIMITED PARTNERSHIP, 924-946 WETHERSFIELD AVE., HARTFORD, CONNECTICUT.

DATE: 6-30-81 DRAWN BY: RJD
SCALE: 1"=20' NO.: EC-J0613-1052

1156

EAGLE FILE COMP. IRVING CO.
1156
EAGLE

0 INCHES 1 2 3 4