


1158-3

N/F MARLO T.
MARENA

N/F CORINTOS 15 0 0511'80
DI GIACOMO
TOWN & STREETS
HARTFORD

RECEIVED BY
[Signature]

VOL. ~~1158~~ 3537

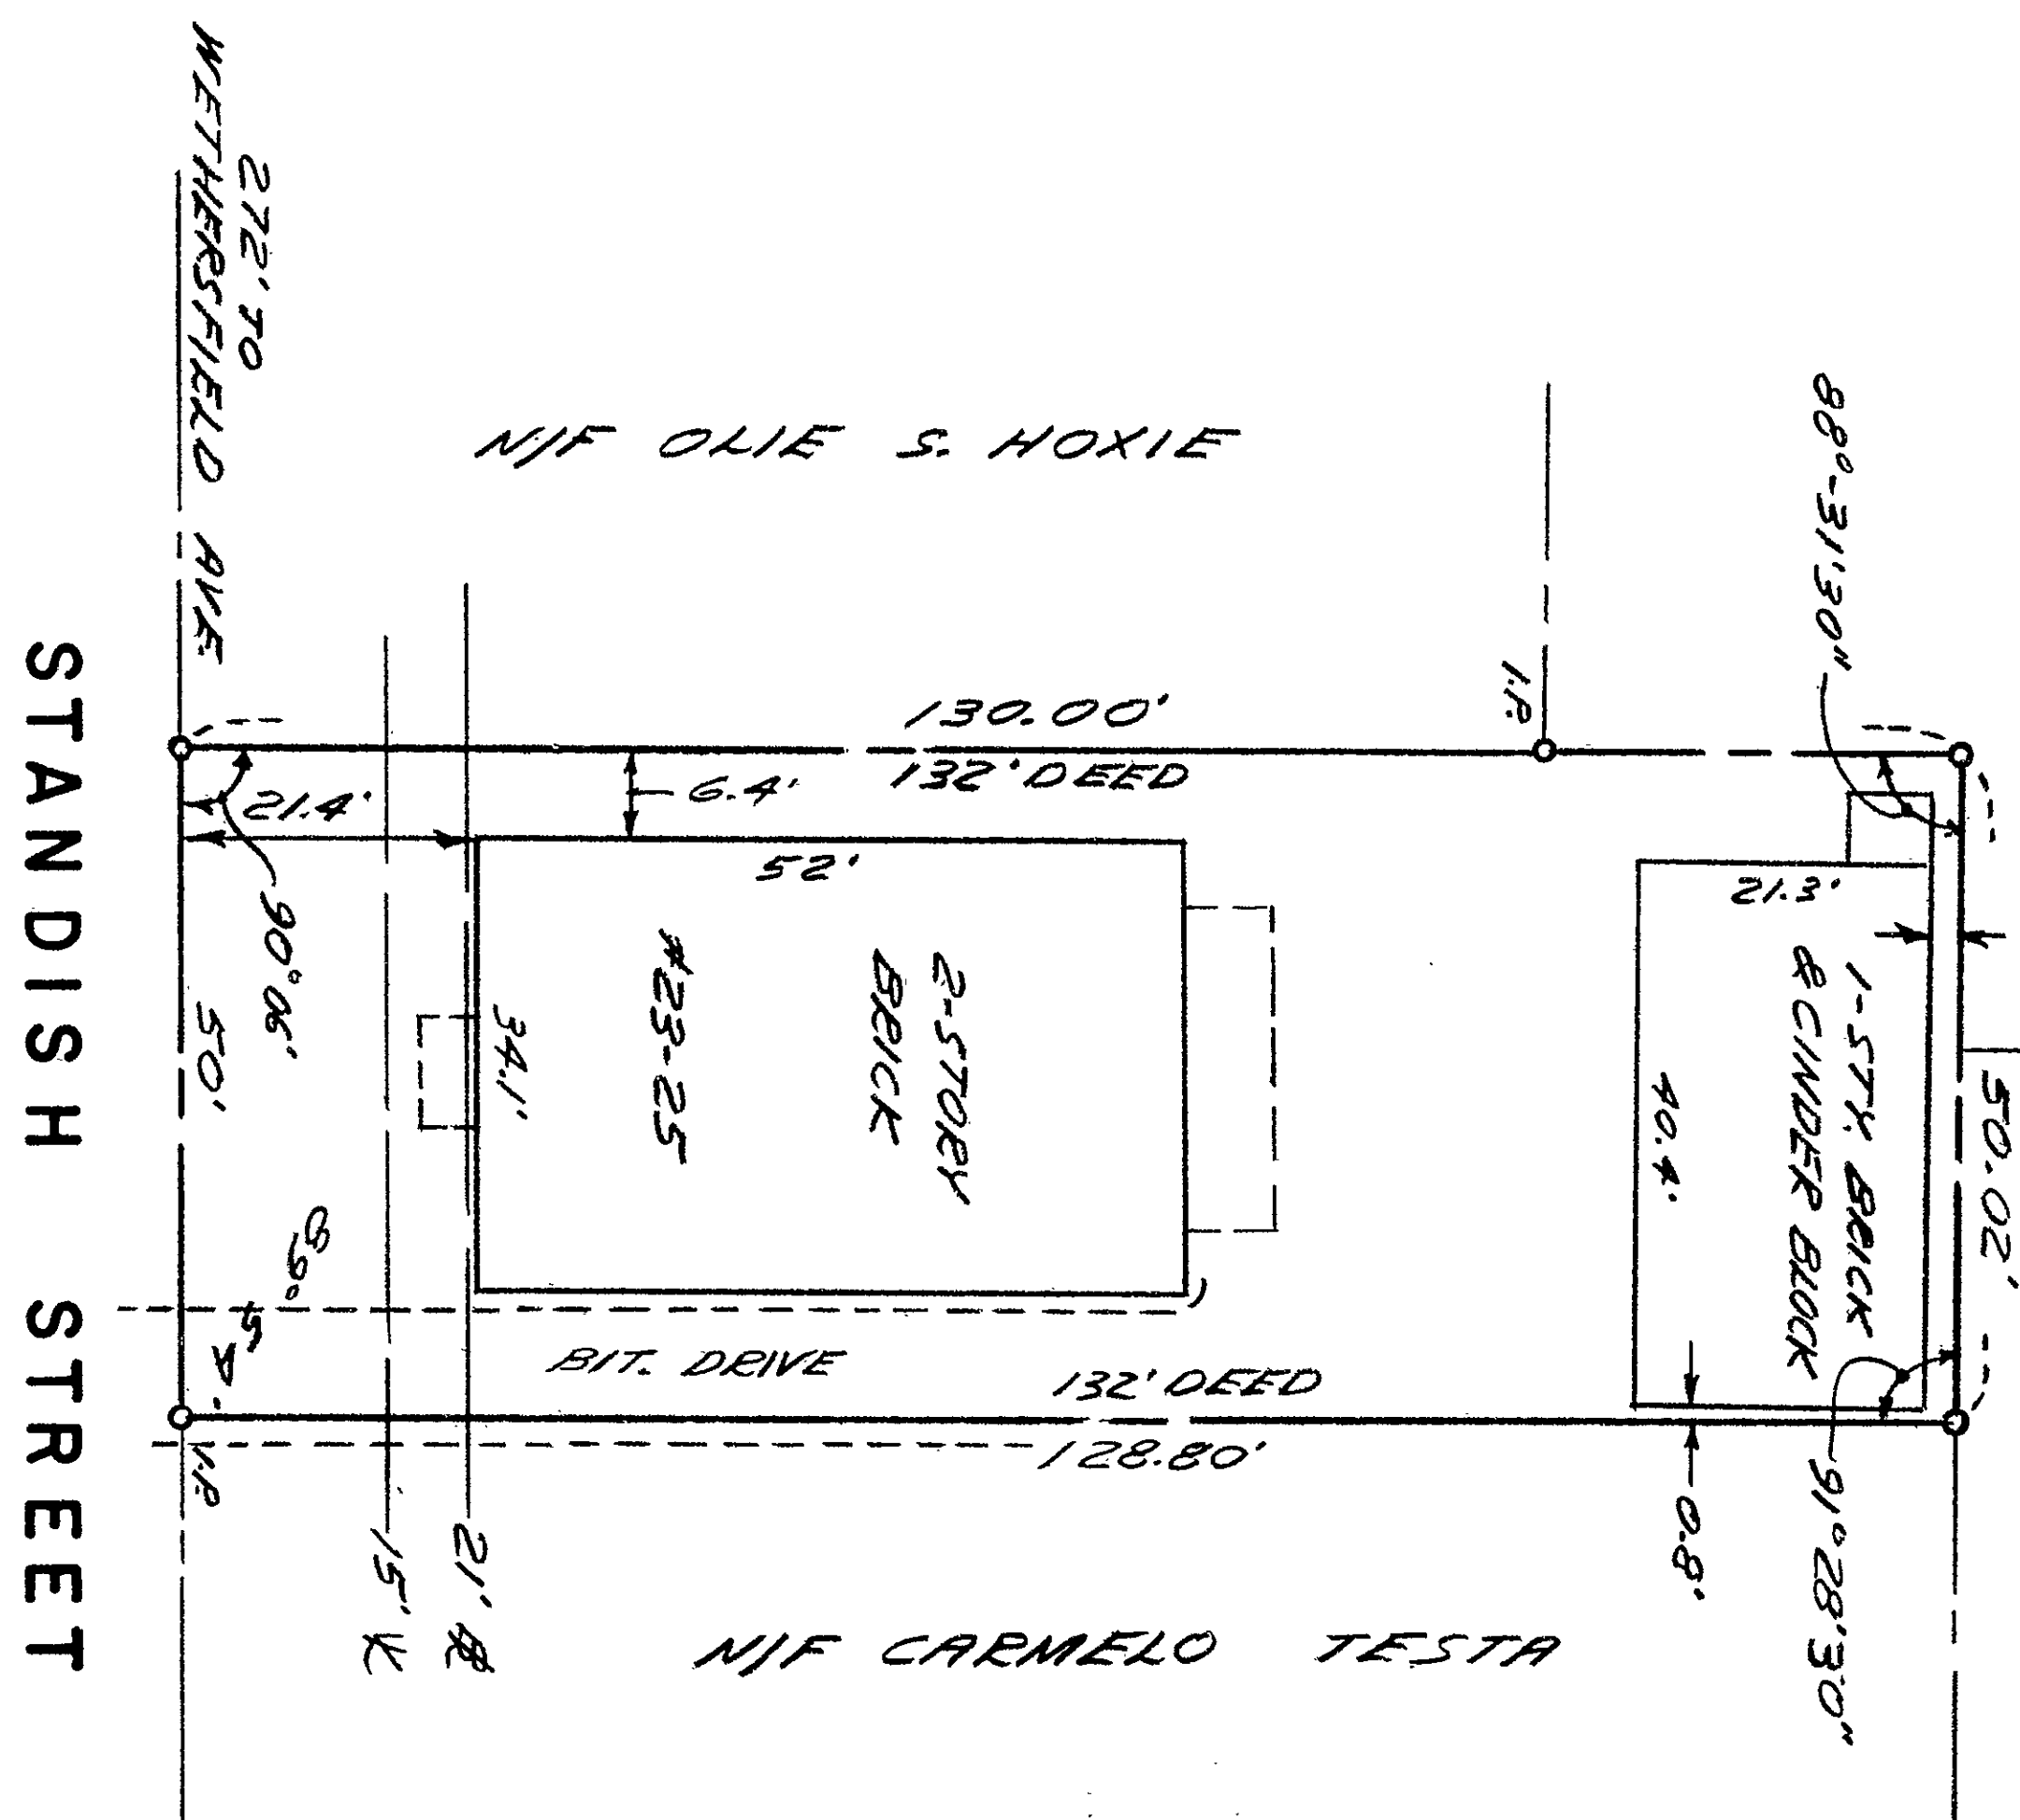

NOTES:

1. LOT ZONE R-3
2. AREA = 6470.58 SQ. FT.

The portion of Standish Street shown on this plan is an established public street of the City of Hartford

September 1981

[Signature]
CITY ENGINEER

I HEREBY CERTIFY THAT THIS MAP AND SURVEY WERE PREPARED IN ACCORDANCE WITH THE STANDARDS OF A CLASS A-2 SURVEY AS DEFINED IN THE CODE OF PRACTICE FOR STANDARDS OF ACCURACY OF SURVEYS AND MAPS, ADOPTED DECEMBER 10, 1975 AS AMENDED BY THE CONNECTICUT ASSOCIATION OF LAND SURVEYORS, INC.

[Signature] 8/16/81
SURVEYOR DATE REGISTRATION NO.

HALLISEY & HERBERT CIVIL ENGINEERS & LAND SURVEYORS 2317 SILAS DEANE HIGHWAY, ROCKY HILL, CONNECTICUT			
PROPERTY OF LENORA FUSCO & RONALD COTE STANDISH STREET HARTFORD, CONNECTICUT		JOB NO. 383	REVISIONS:
DRAWN BY: J.D.		SHEET 1 OF 1	
CHECKED BY: K.H.		DATE: 6 AUG 81	
SCALE: 1" = 20'		SHEET 1 OF 1	

1158

#125



1158
EAST FILE COMP. INVINE CA
EPM 34