

EASI FILE CORP IRVINE CA

EFH 34

35

1159-1


\$35

PROPERTY OF
VICTORIAN ASSOCIATE I
LIMITED PARTNERSHIP
VICTORIAN HEIGHTS CONDOMINIUM
SCALE: 1" = 20' AUG. 21, 1981

I hereby certify that this map and survey were prepared in accordance with the standards of a Class A-2 survey as defined in the Code of Practice for Standards of Accuracy of Surveys and Maps, adopted December 10, 1975, as amended by the Connecticut Association of Land Surveyors, Inc.

Lot Area = 20,713.65'²
Lot Coverage = 1,360'² = 6.57%

Michael Dante
LAND SURVEYOR

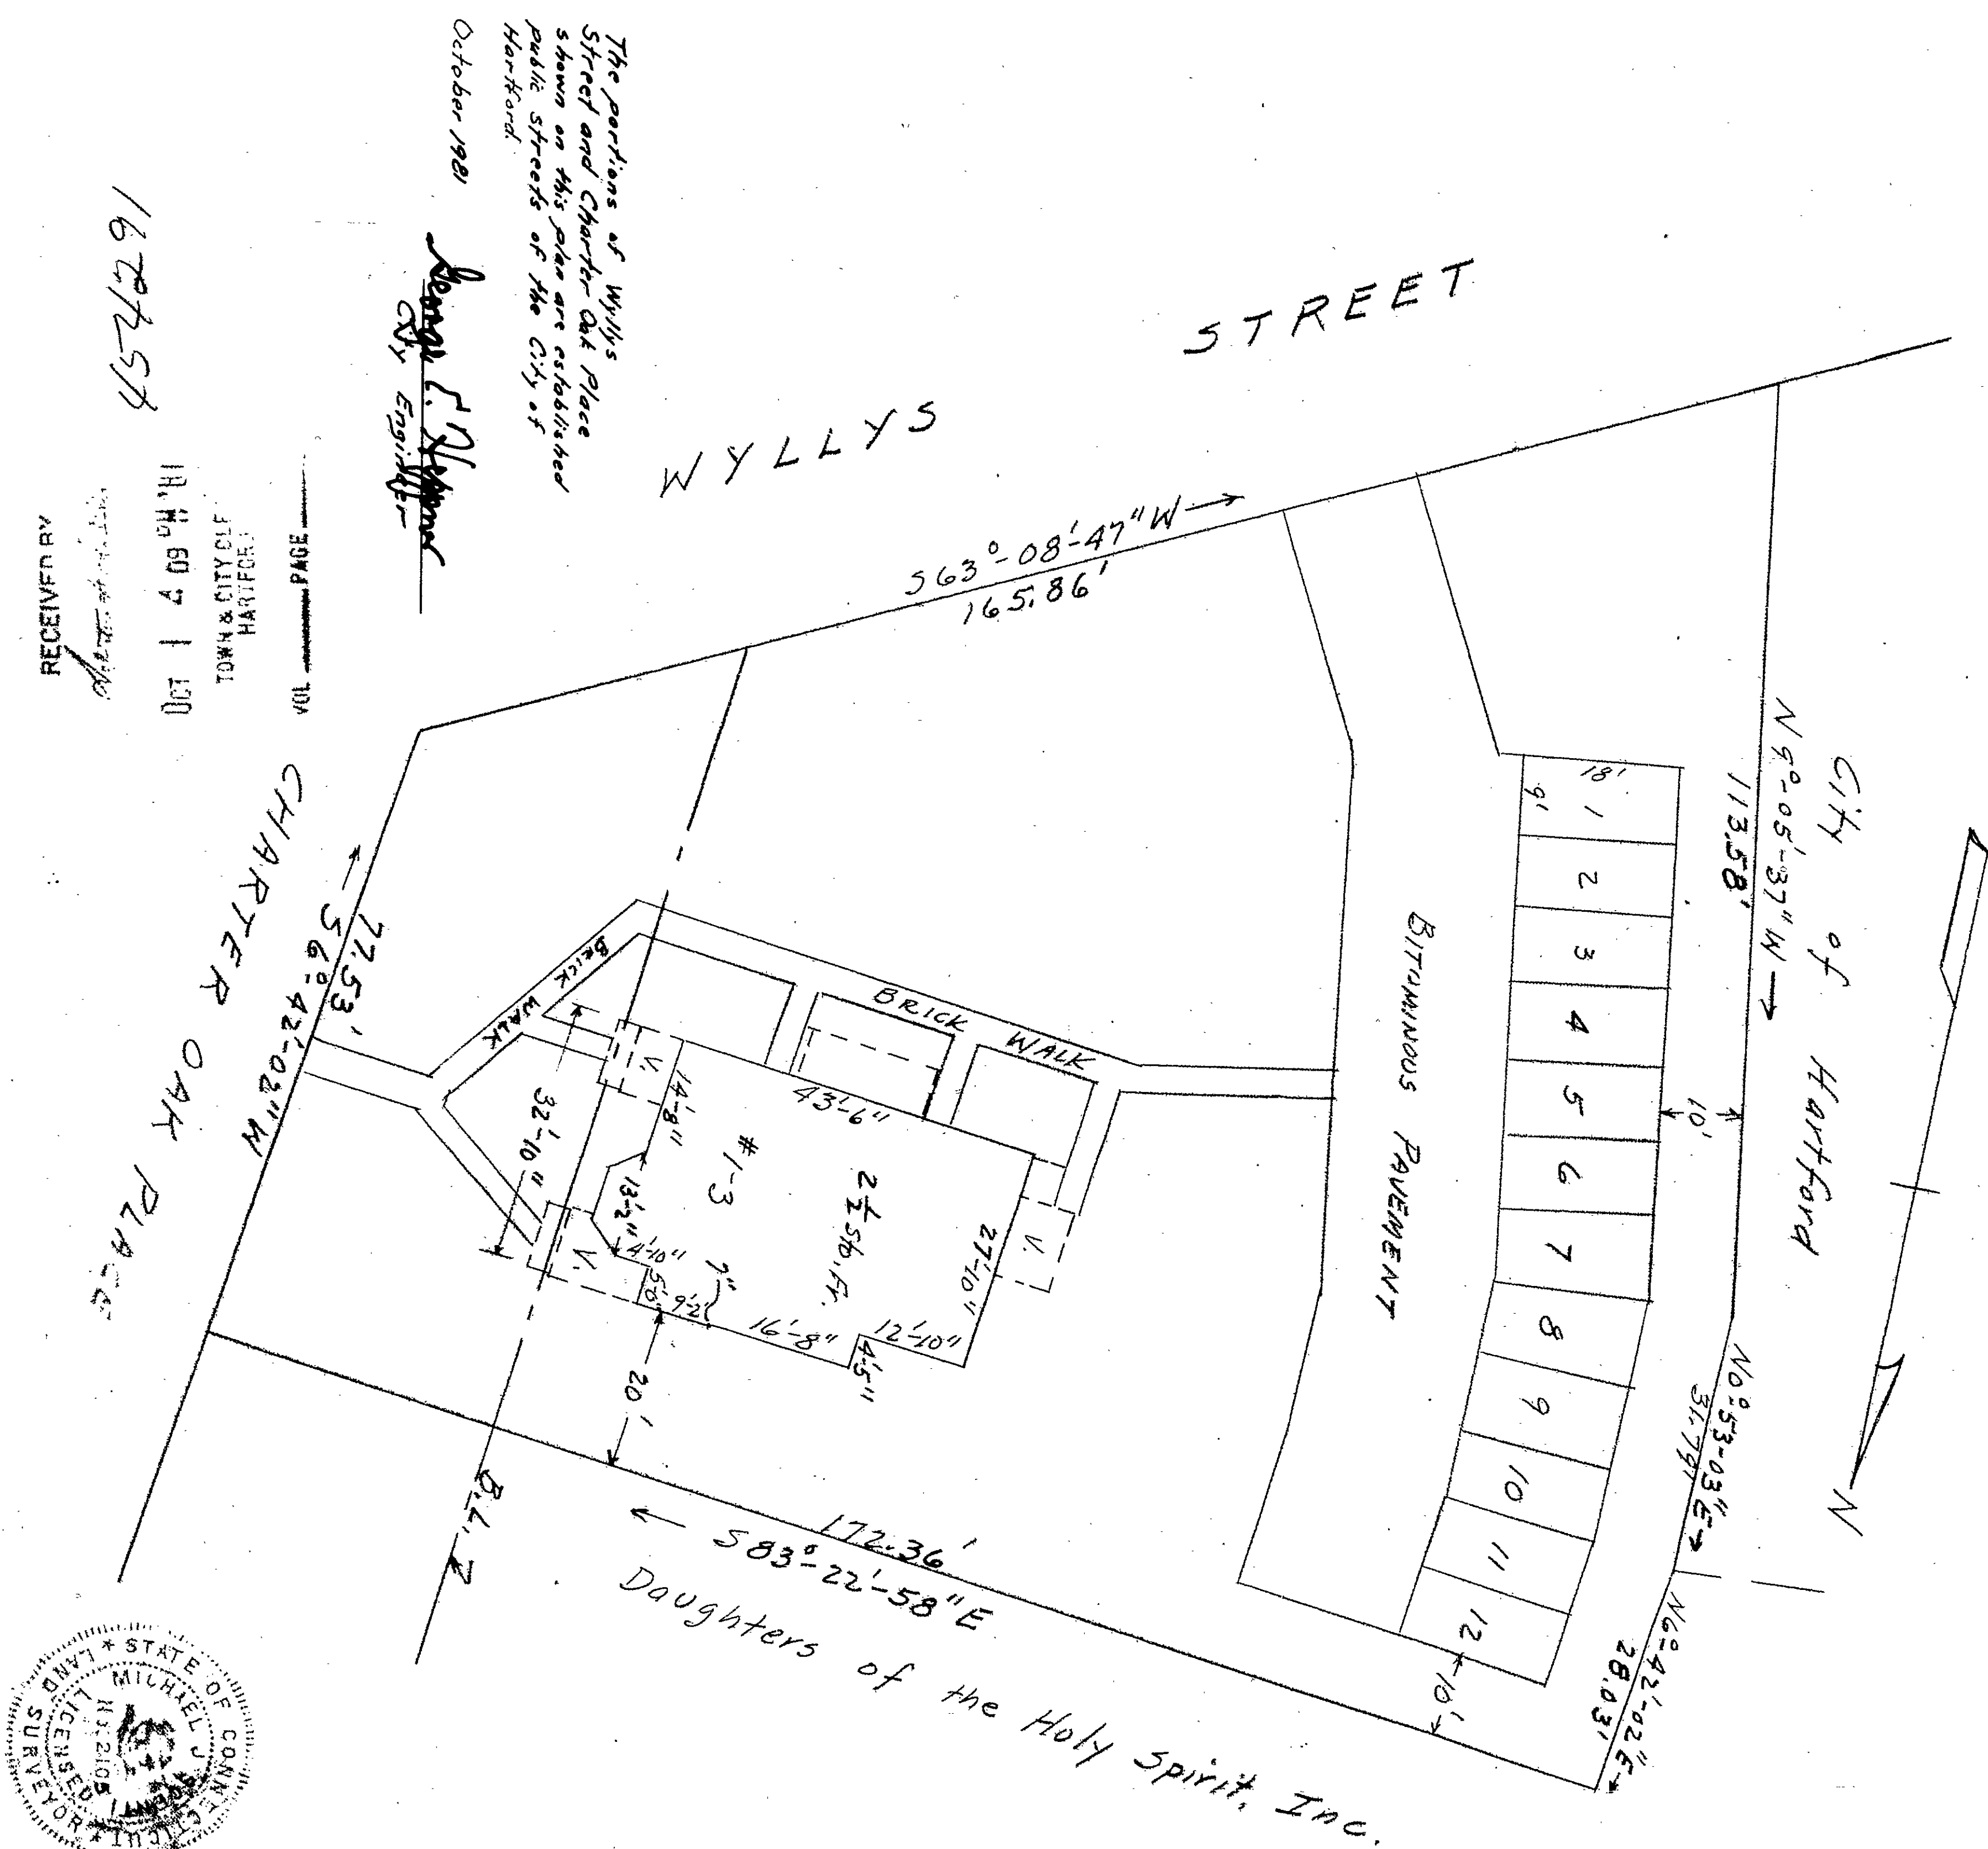

RECEIVED R'

Oct 14 69 PM 'H
TOWN & CITY CLERK
HARTFORD

COL	PAGE

162257

