1159-3

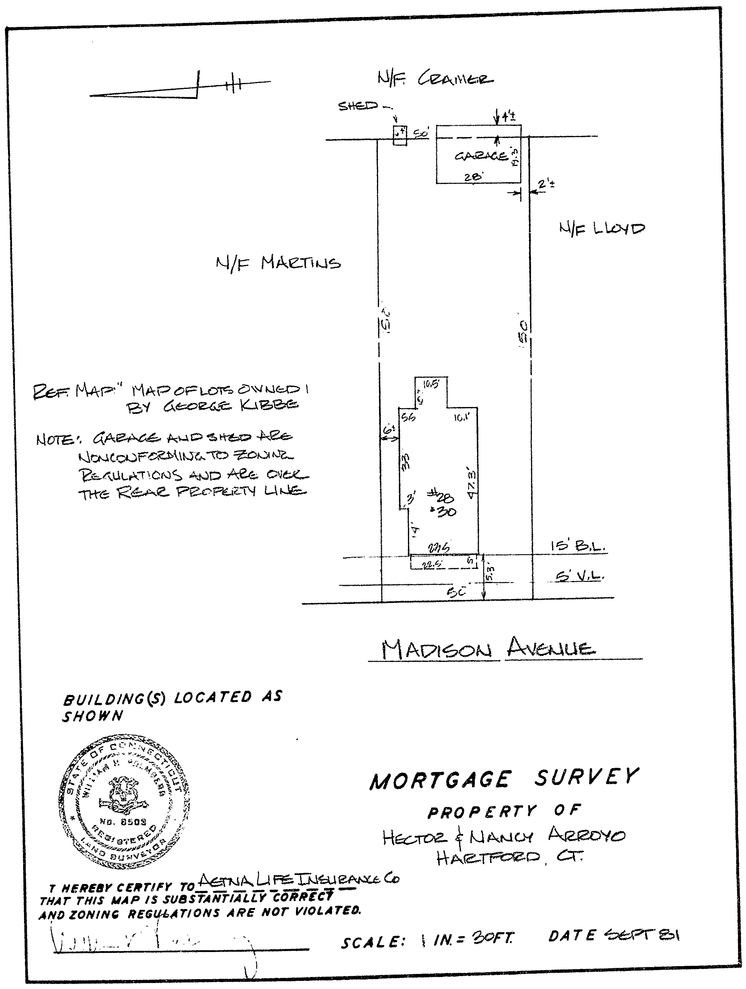

The portion of Madison Avenue shown on this plan is an established public street of the City of Hartford.

October 1981

George E. Happer
City Engineer

RECEIVED BY
OCT 7 11 35 AM '81
TOWN & CITY CLERK
HARTFORD
VOL. PAGE

EASI-FILE CORP. IRVINE CA
1159
EFH-14

1159

34