


1160

**1160-2**

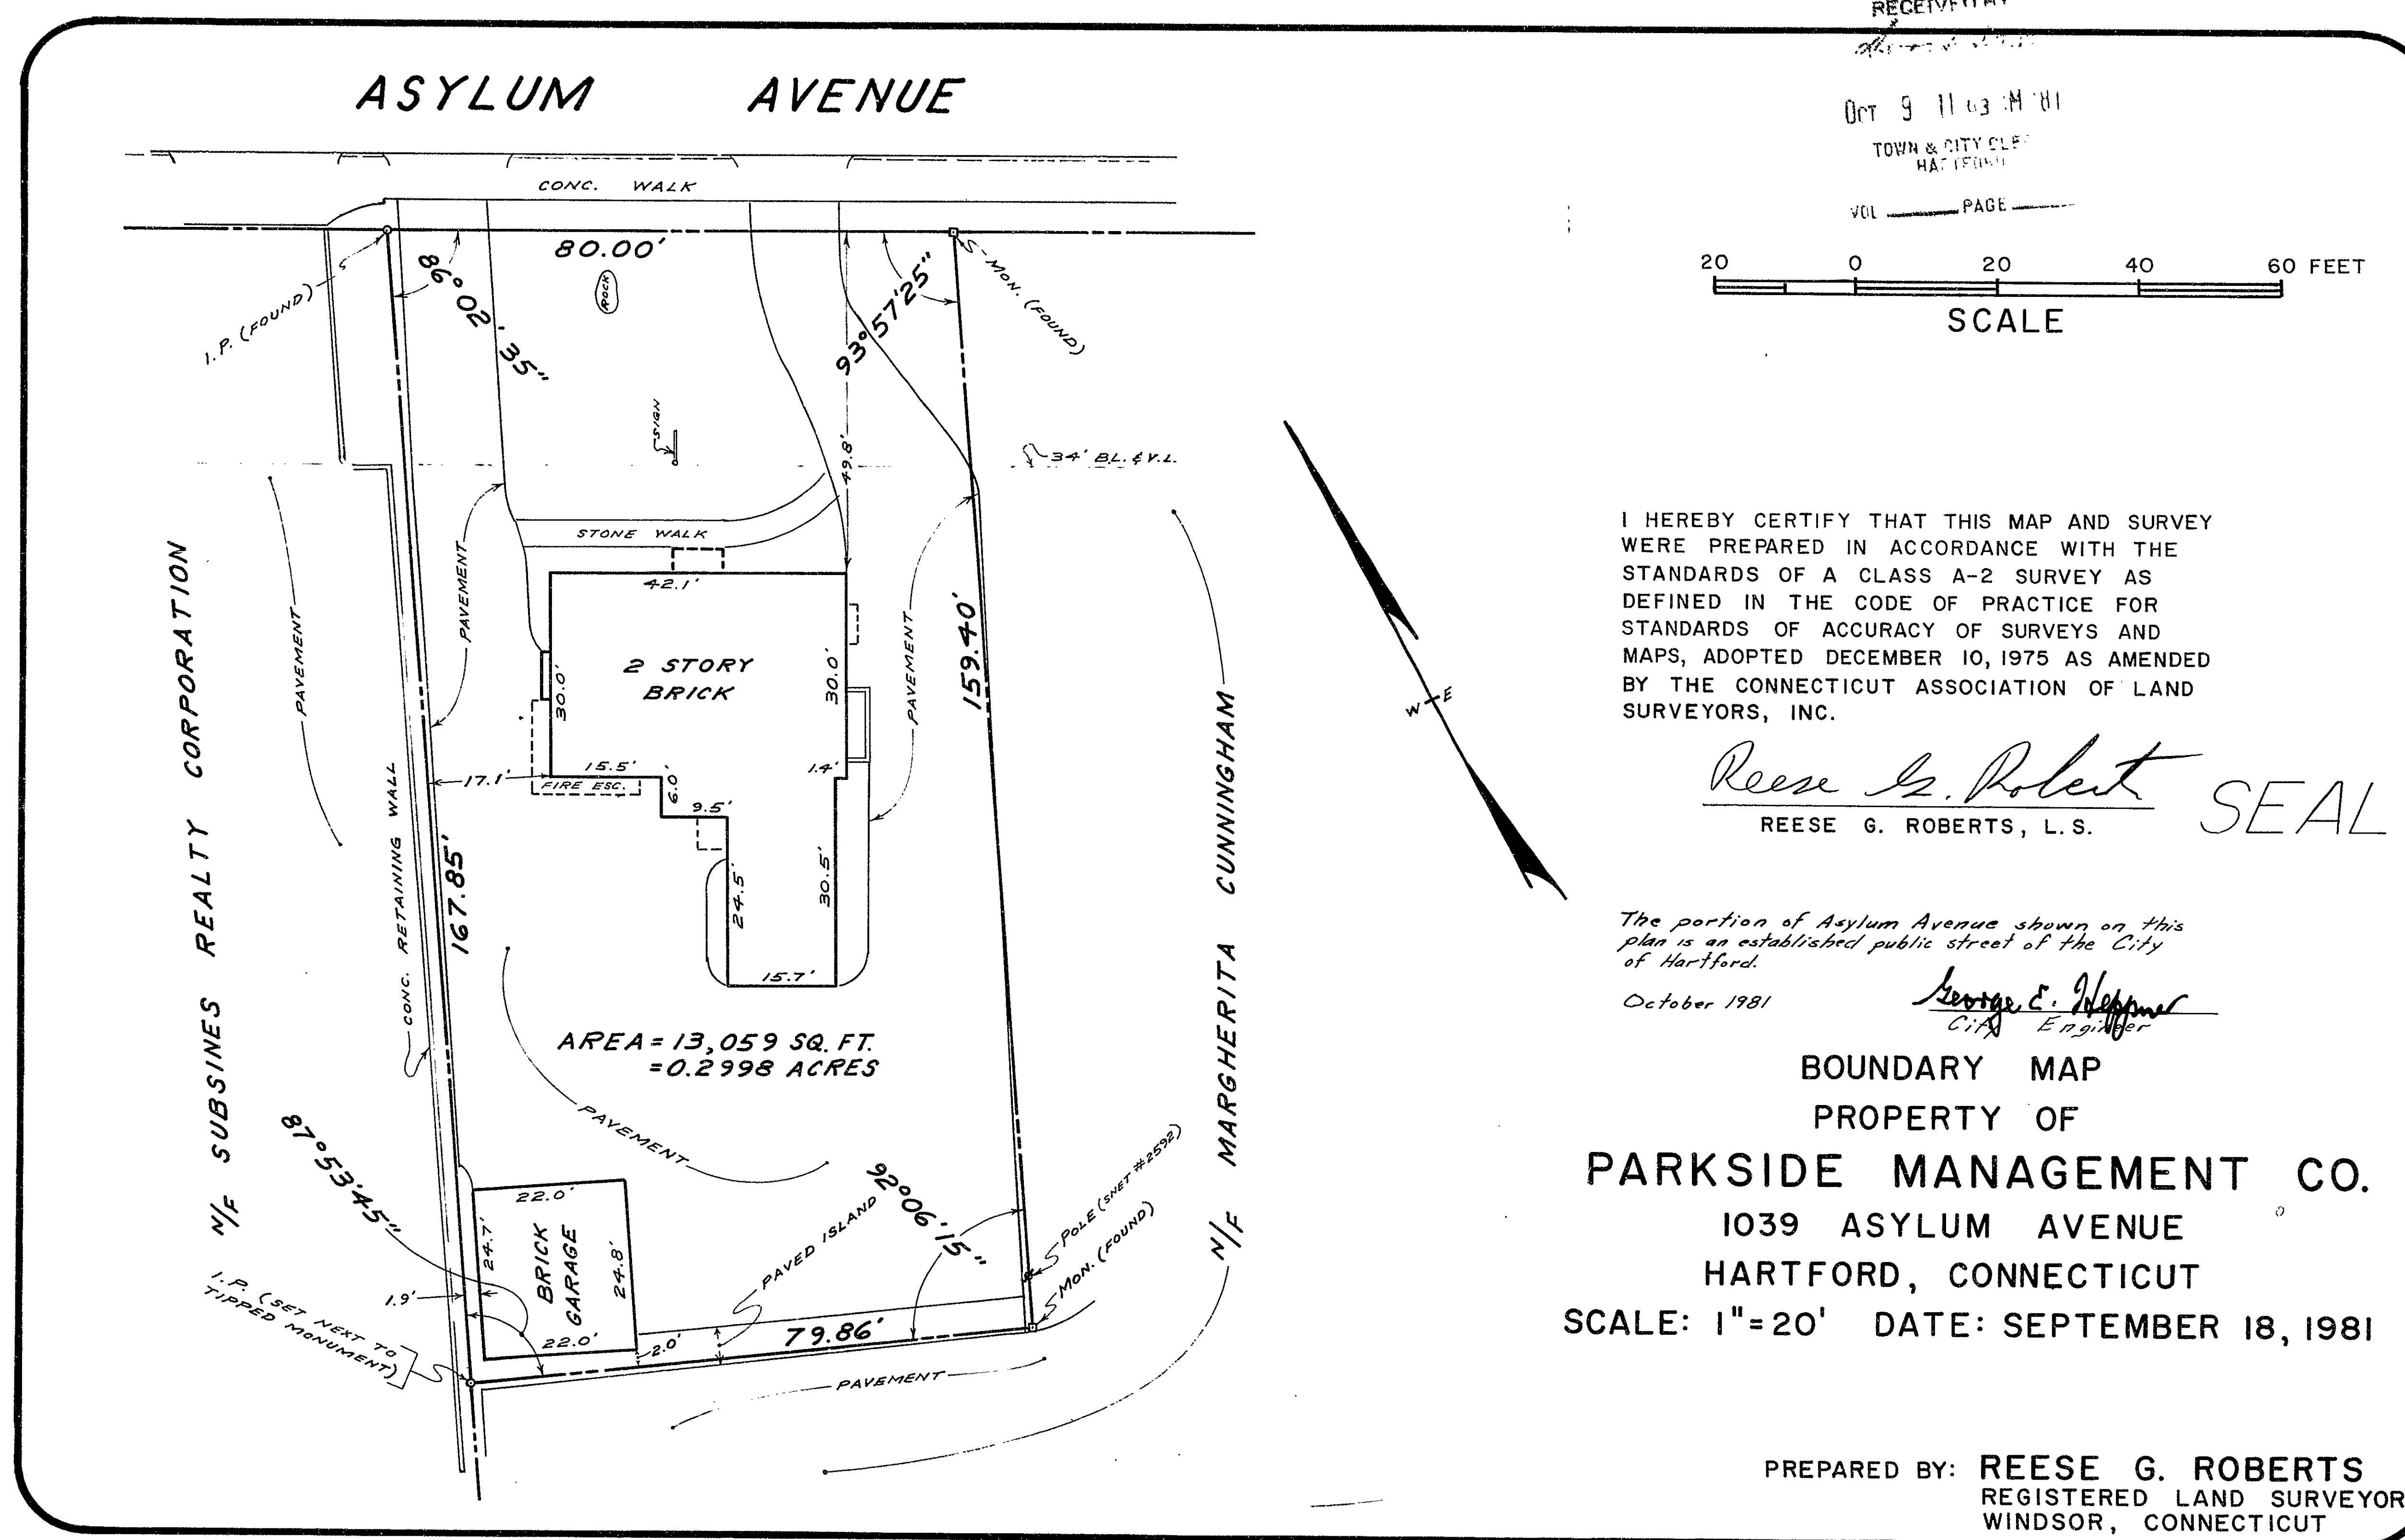

PREPARED BY: **REESE G. ROBERTS**  
REGISTERED LAND SURVEYOR  
WINDSOR, CONNECTICUT

# 40



1160