


RECEIVED BY
SEP 15 2 30 PM '81
TOWN & CITY CLERK
HARTFORD
VOL. _____ PAGE _____
453478

1. Reference is made to a plan entitled "Block 9 Charter Oak South Green Project Section I-Corr R-112, Block bounded by Governor St, Charter Oak Ave, Charter Oak Pl and Wyllys St. Scale 1"=40' Date: October 1977 by City of Hartford, Connecticut Department of Public Works Bureau of Engineering Services.

	R-02 District	
	#14	#16
Lot Area	9,840.401 S.F.	14,889.188 S.F.
Bldg Area	1500 S.F.	1560 S.F.
Bldg covers % Lot	15.24%	10.48%

James J. O'Donoghue
Surveyor

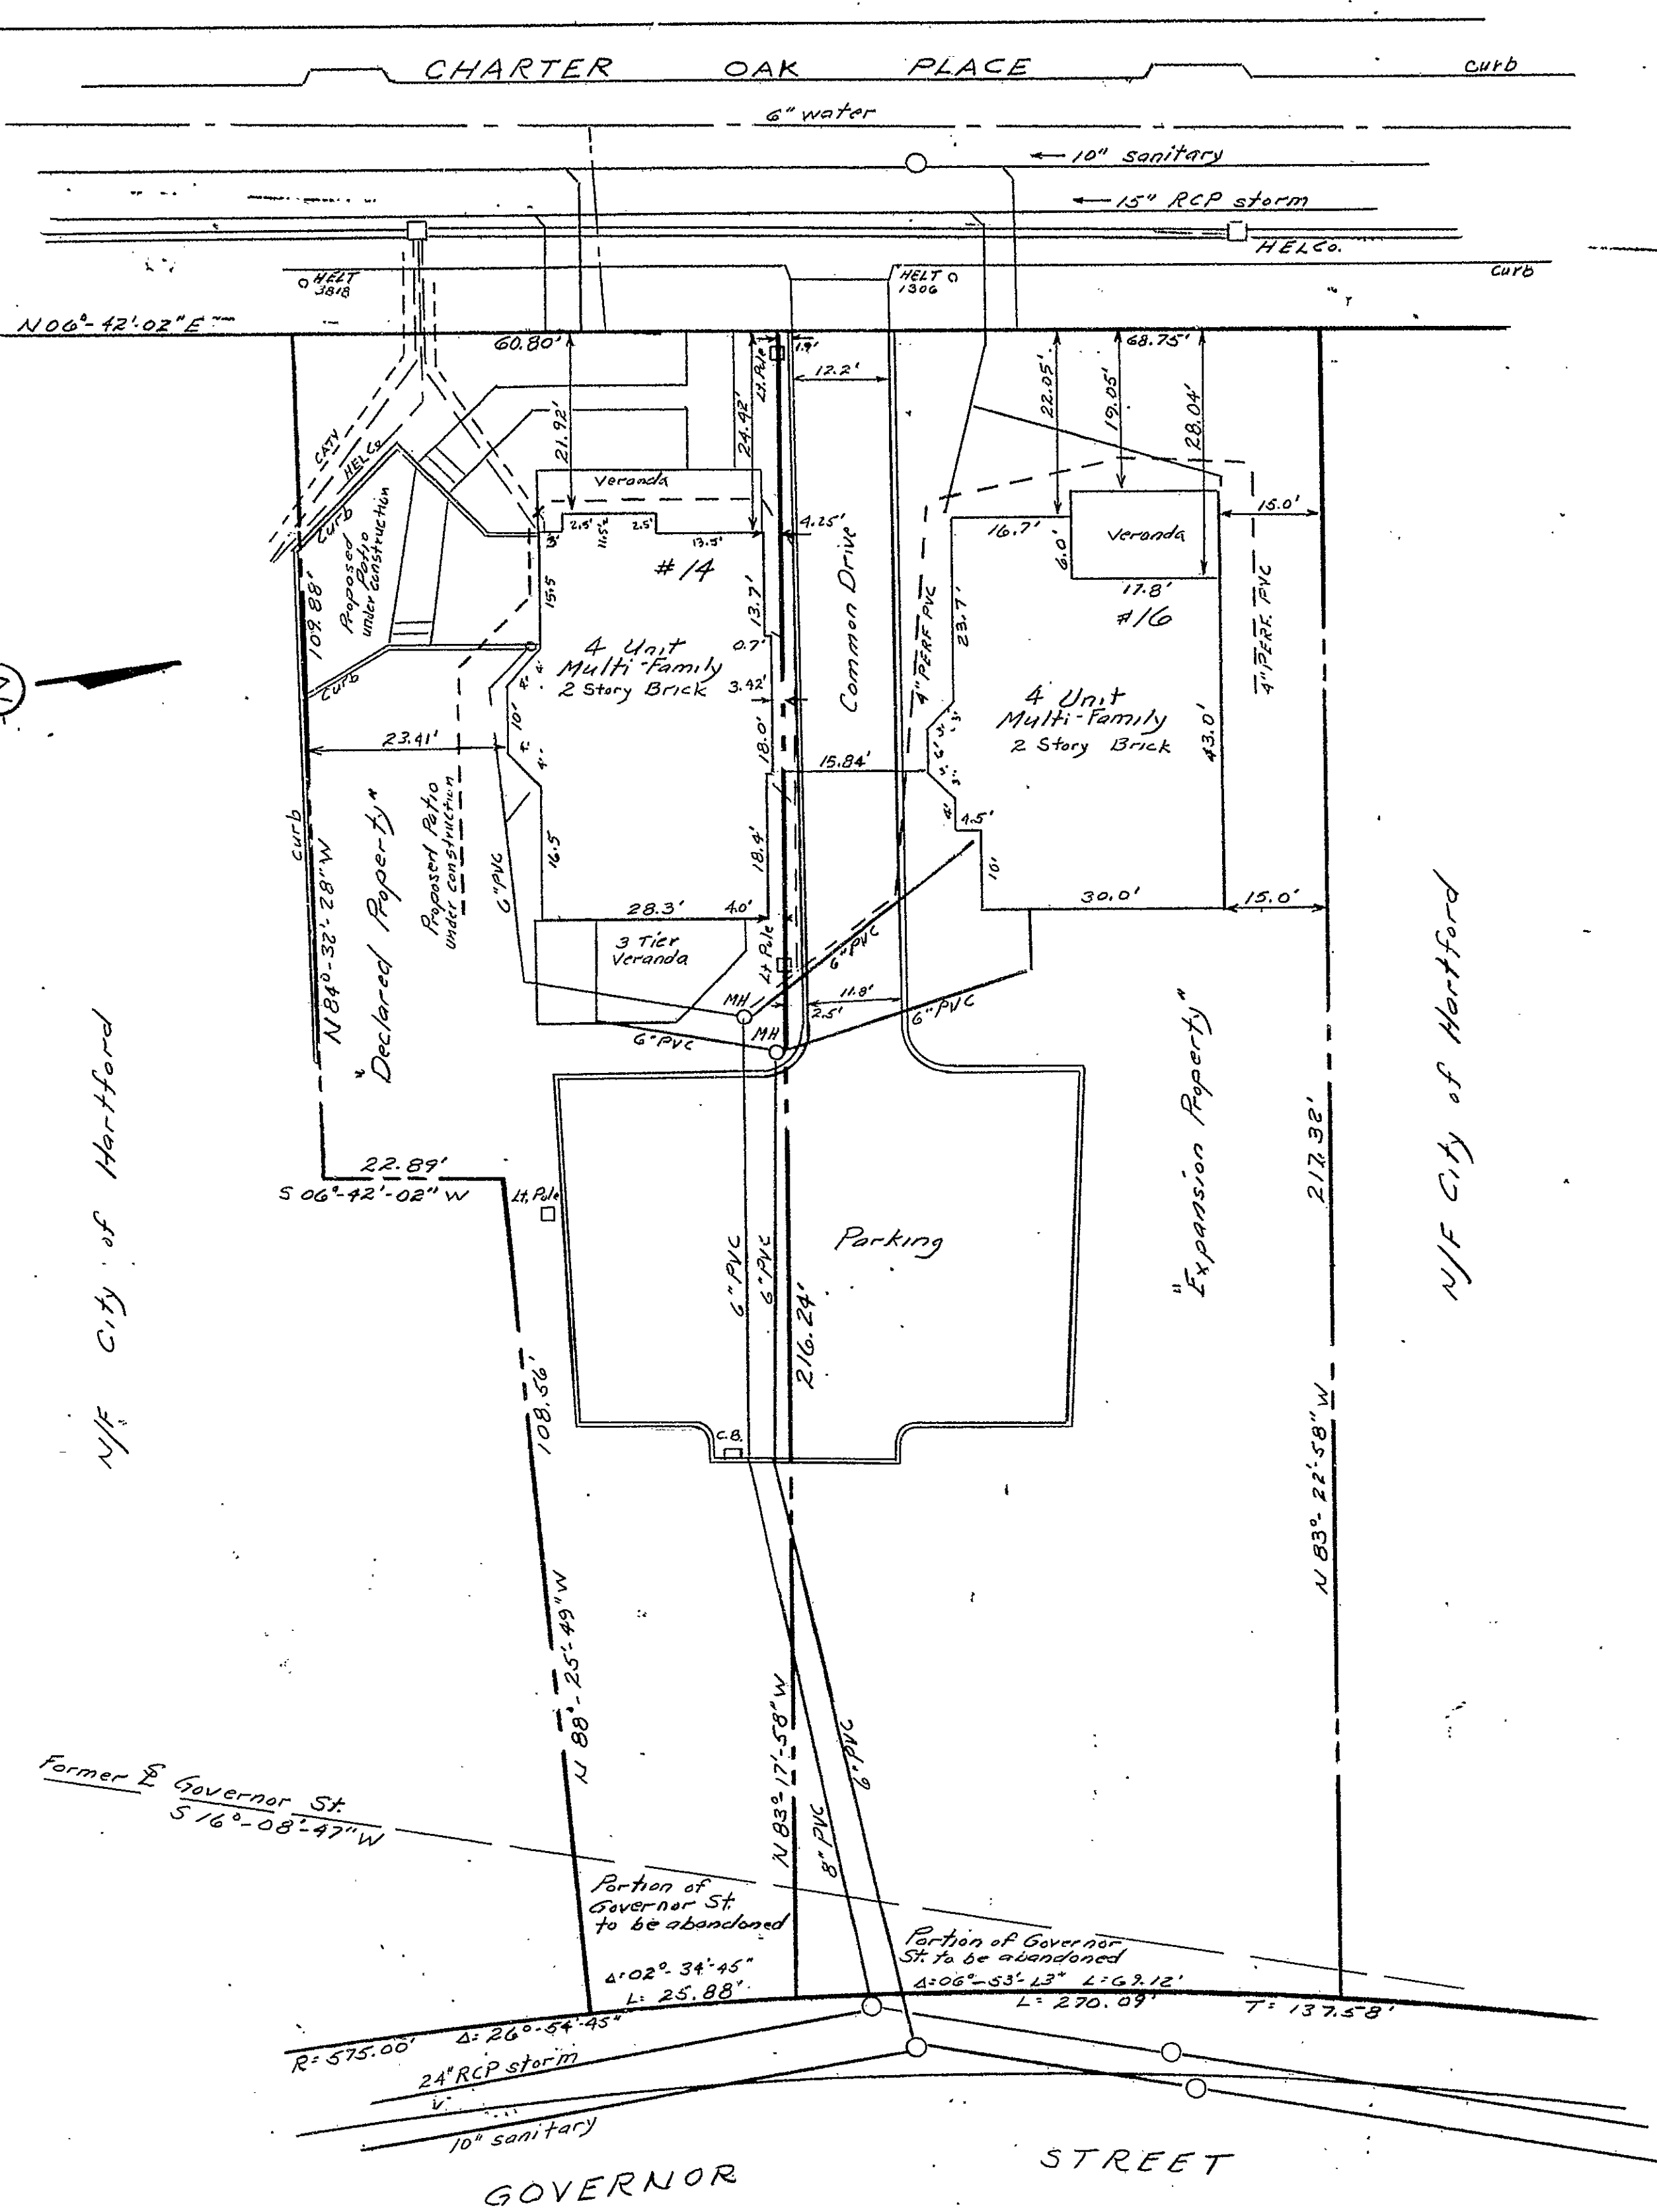

The portions of Charter Oak Place and Governor Street shown on this plan are established public streets of the City of Hartford.
Sept. 1981
George F. Schuman
City Engineer

Land of
COREHAB ASSOCIATES
"14-16 Charter Oak Place
An Expandable Condominium"
Scale 1"=20'
March 1981

1164

