


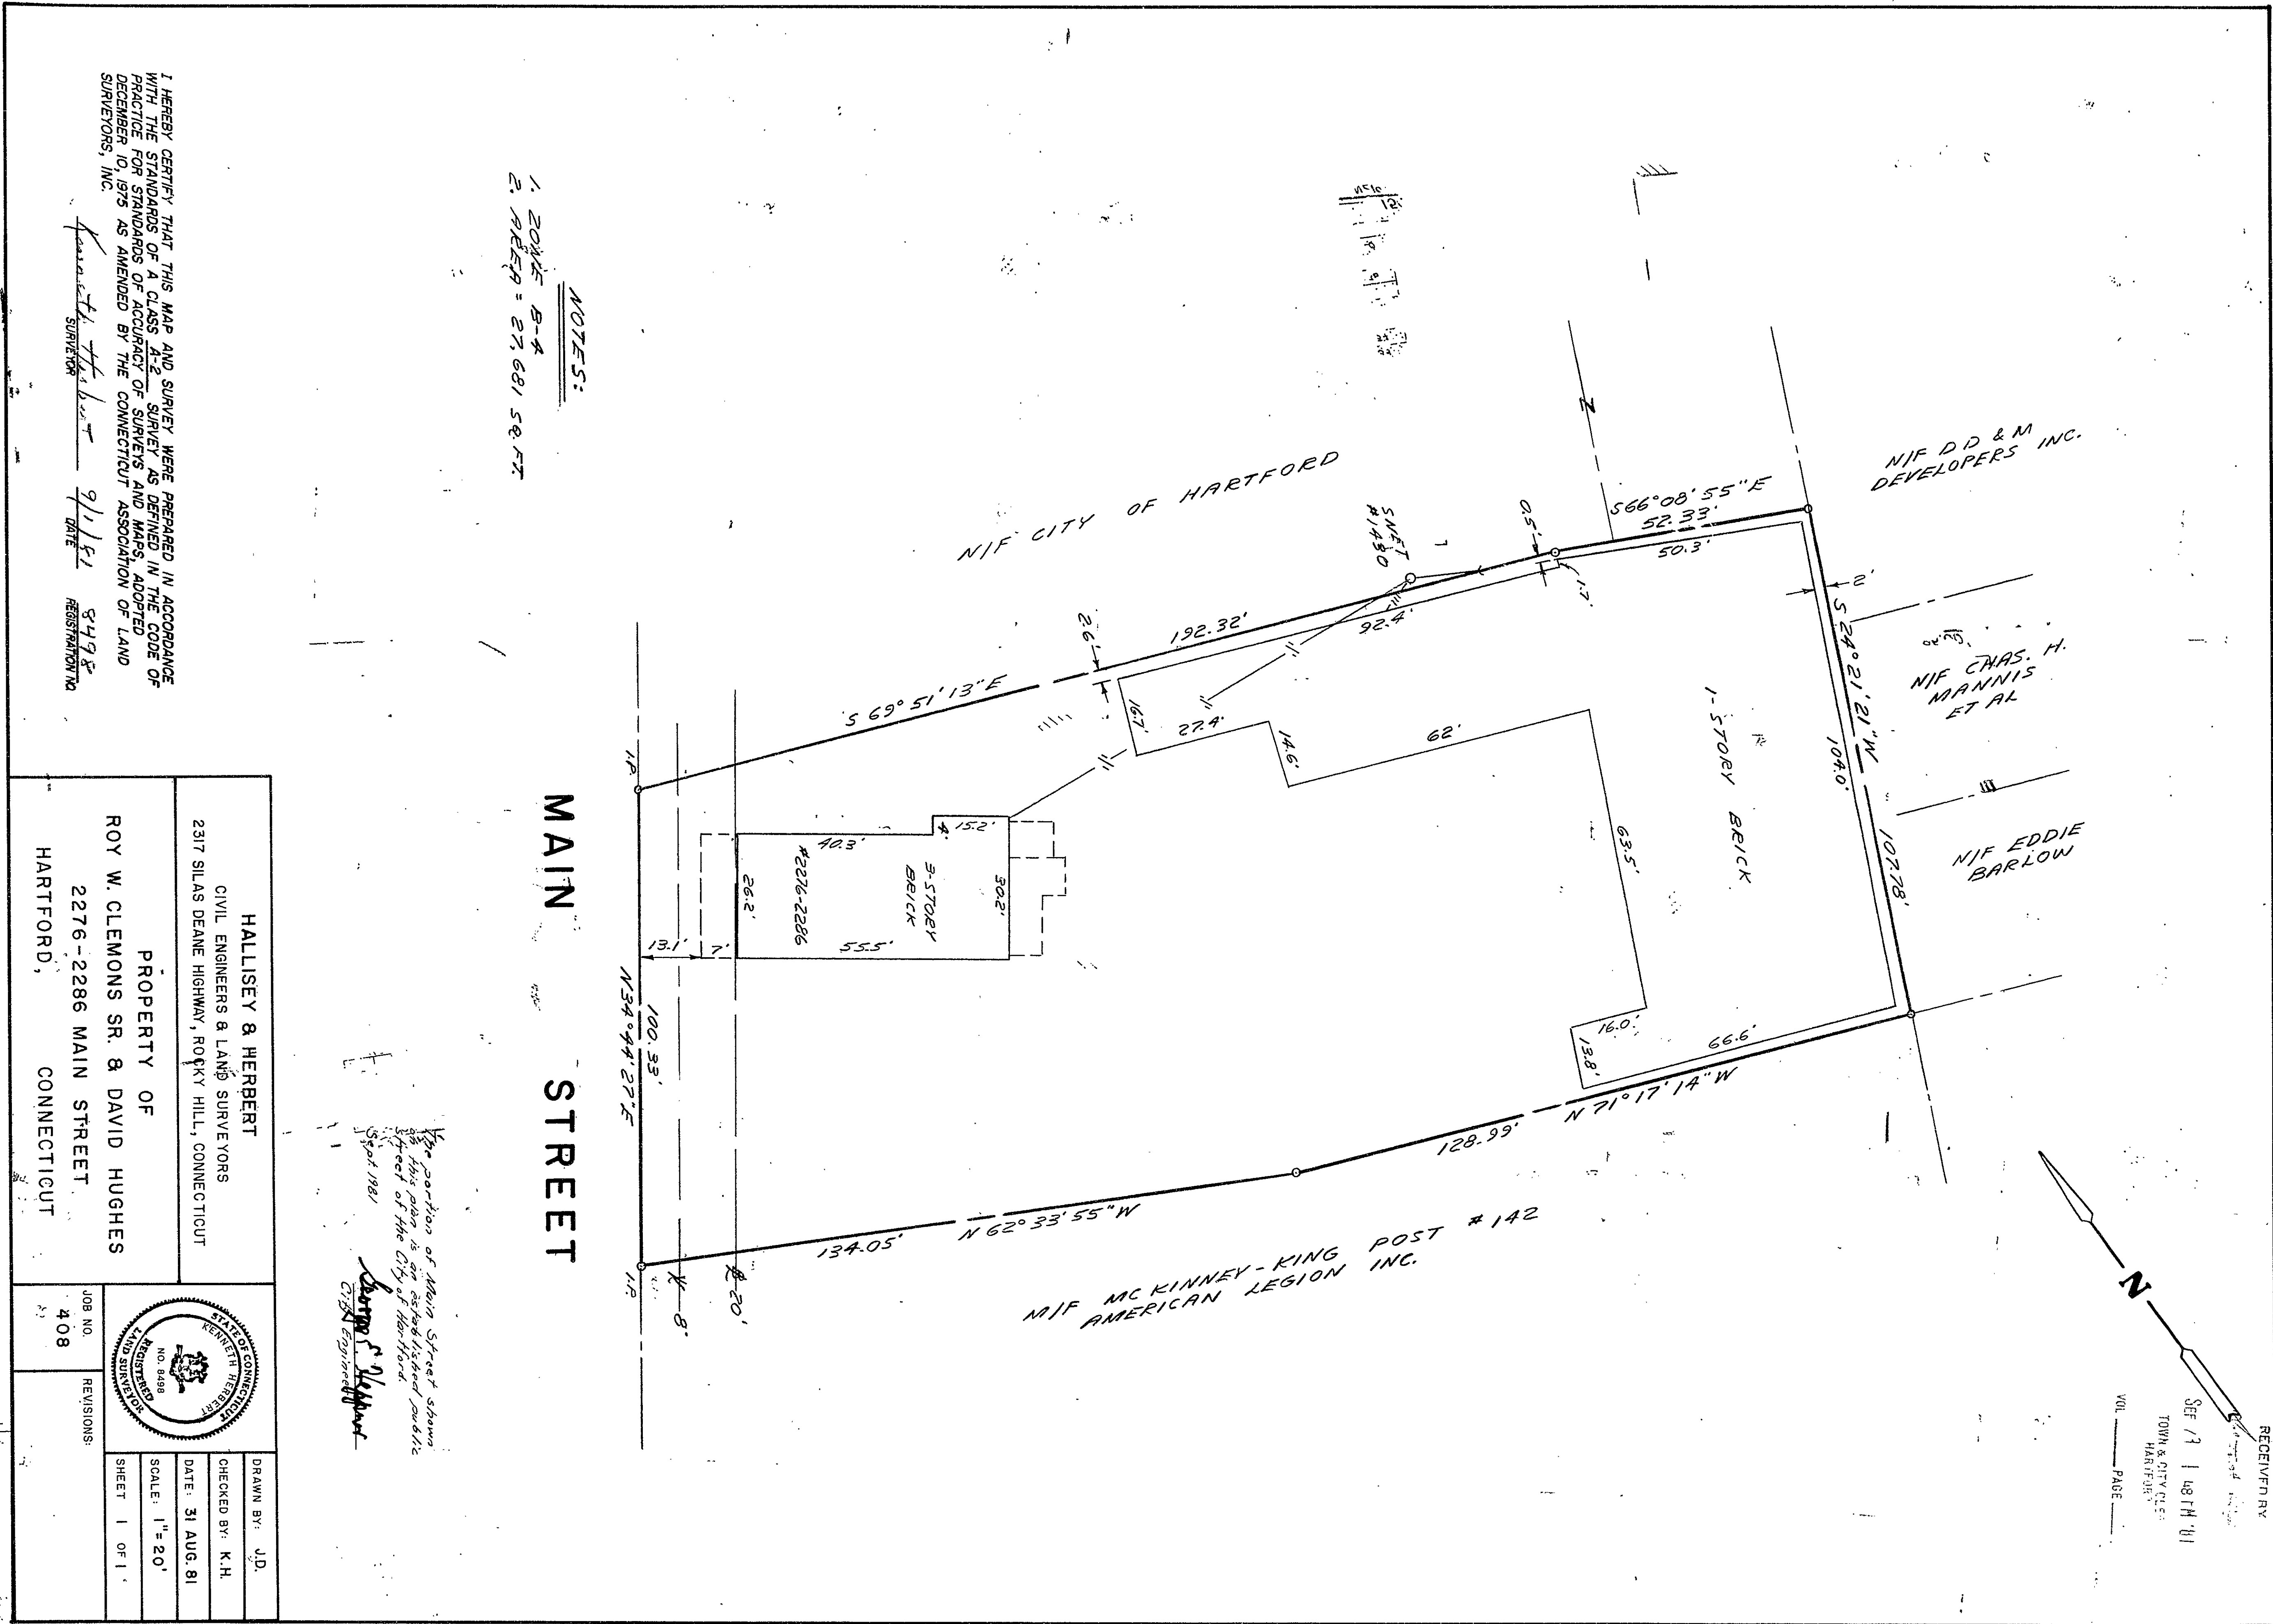

NOTES:  
1. ZONE B-4  
2. AREA = 27,681 SQ. FT.

I HEREBY CERTIFY THAT THIS MAP AND SURVEY WERE PREPARED IN ACCORDANCE WITH THE STANDARDS OF A CLASS A-2 SURVEY AS DEFINED IN THE CODE OF PRACTICE FOR STANDARDS OF SURVEYS AND MAPS, ADOPTED BY THE CONNECTICUT ASSOCIATION OF LAND SURVEYORS, INC.

Surveyed by: *[Signature]* DATE: 9/1/81 REGISTRATION NO. 5498

|   |                  |
|---|------------------|
| HALLISEY & HERBERT<br>CIVIL ENGINEERS & LAND SURVEYORS<br>2317 SILAS DEANE HIGHWAY, ROCKY HILL, CONNECTICUT |                  |
| PROPERTY OF<br>ROY W. CLEMENS SR. & DAVID HUGHES<br>2276-2286 MAIN STREET<br>HARTFORD, CONNECTICUT          |                  |
| JOB NO.<br>408                                                                                              | REVISIONS        |
|   |                  |
| DRAWN BY: J.D.                                                                                              | CHECKED BY: K.H. |
| DATE: 31 AUG. 81                                                                                            | SCALE: 1" = 20'  |
| SHEET 1 OF 1                                                                                                |                  |

The portion of Main Street shown hereon is an established public Street of the City of Hartford.  
State Reg. # 5498  
*[Signature]*  
Civil Engineer

