



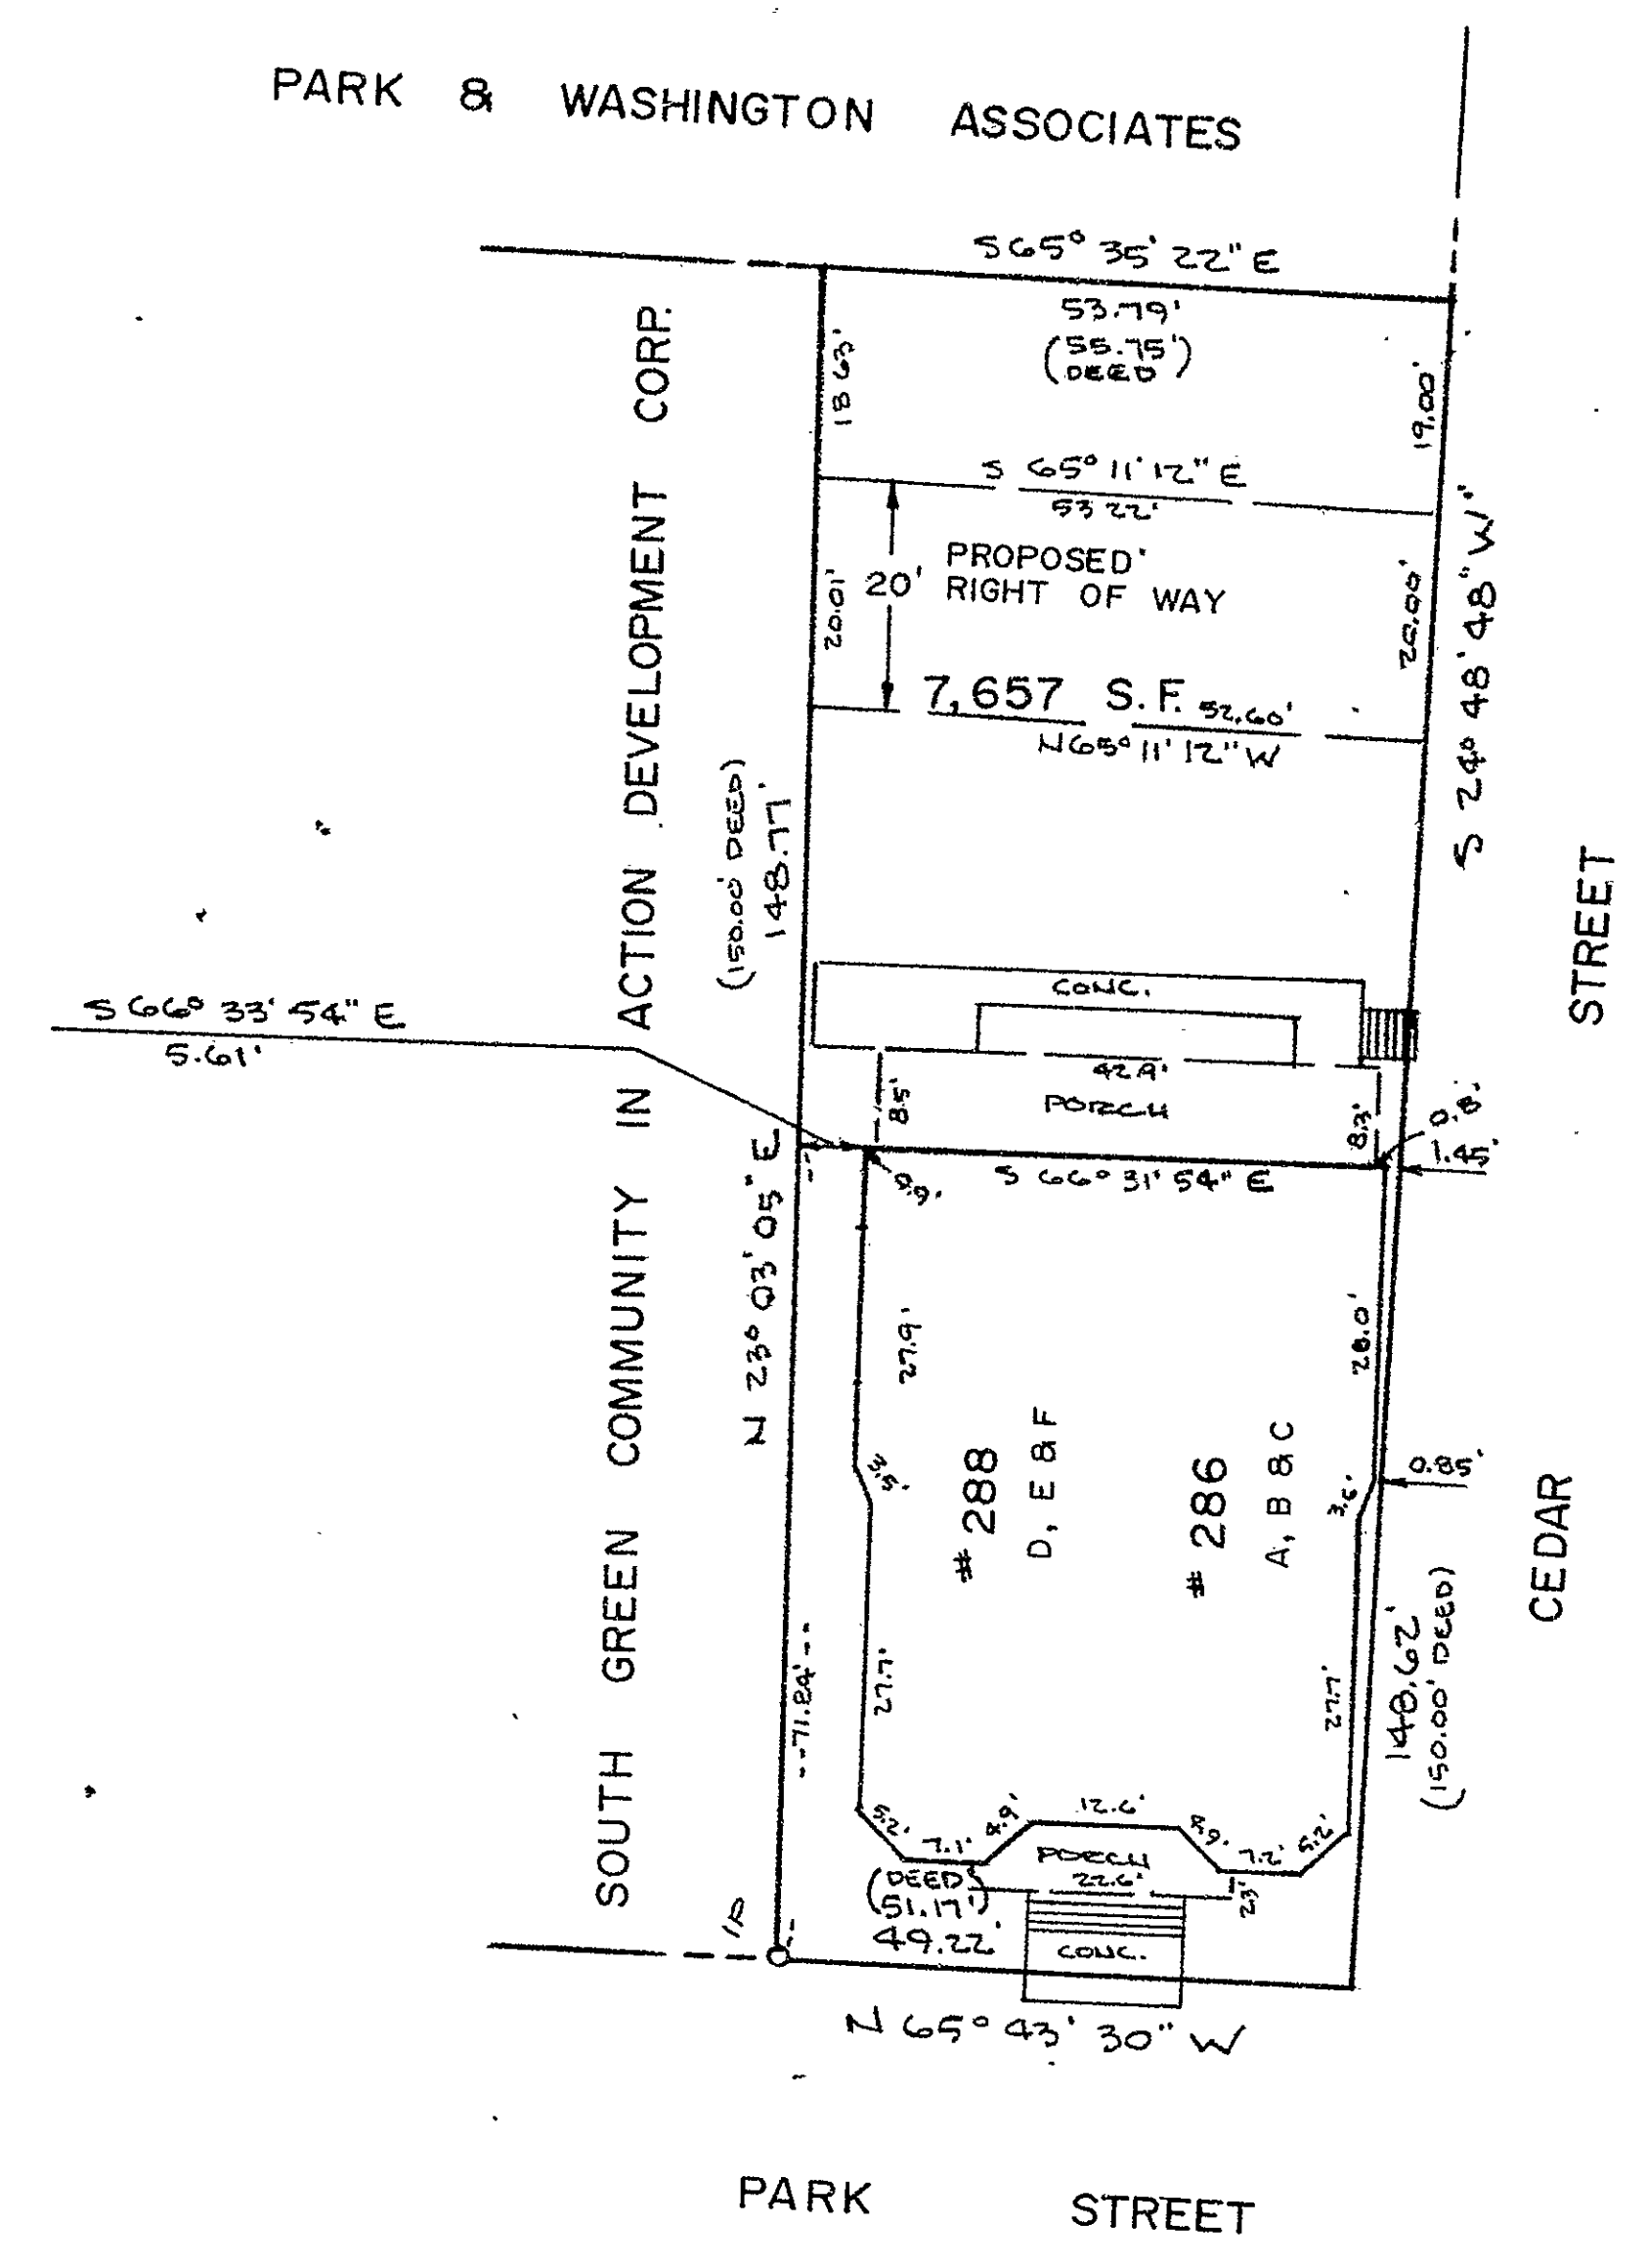

BUILDING LOCATION PLAN
EXHIBIT IO
TRIUNFO CONDOMINIUM
HARTFORD, CONN.


I hereby certify that this map and survey were prepared in accordance with the standards of a Class A-2 survey as defined in the Code of Practice for Standards of Accuracy of Surveys and Maps, adopted December 10, 1973 as amended by the Connecticut Association of Land Surveyors, Inc.

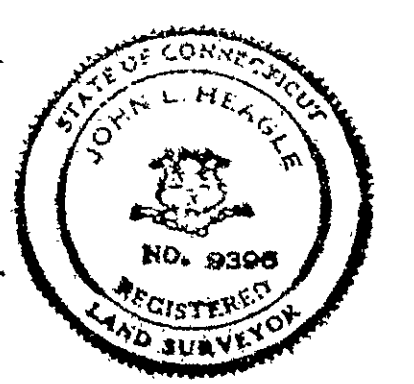

The portions of Park Street and Cedar Street shown on this plan are established public streets of the City of Hartford.
September 1981
George E. Heagle
Civil Engineer

MEGSON & HEAGLE
CIVIL ENGINEERS & LAND SURVEYORS
GLASTONBURY, CONN.
DATE: 9-2-81 SCALE: 1" = 20' MAP NO. 193-81-2

SHEET 1 OF 2 SHEETS

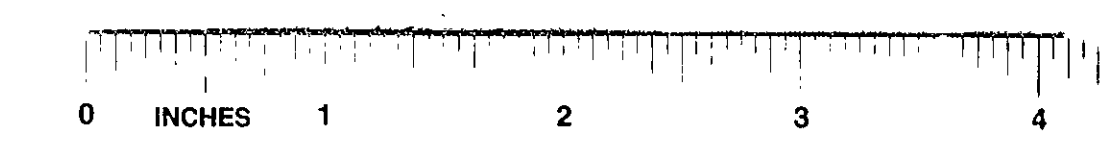

5911
EAST FILE CORP. IRVING, CA
EPH 1A

DE H