

#1

452071

RECEIVED

AUG 10 2 1981

1000 500 1000

1000 500 1000

The portion of Lawrence Street shown on this plan is an established public street of the City of Hartford.

August 1981


James E. Hargis
City Engineer

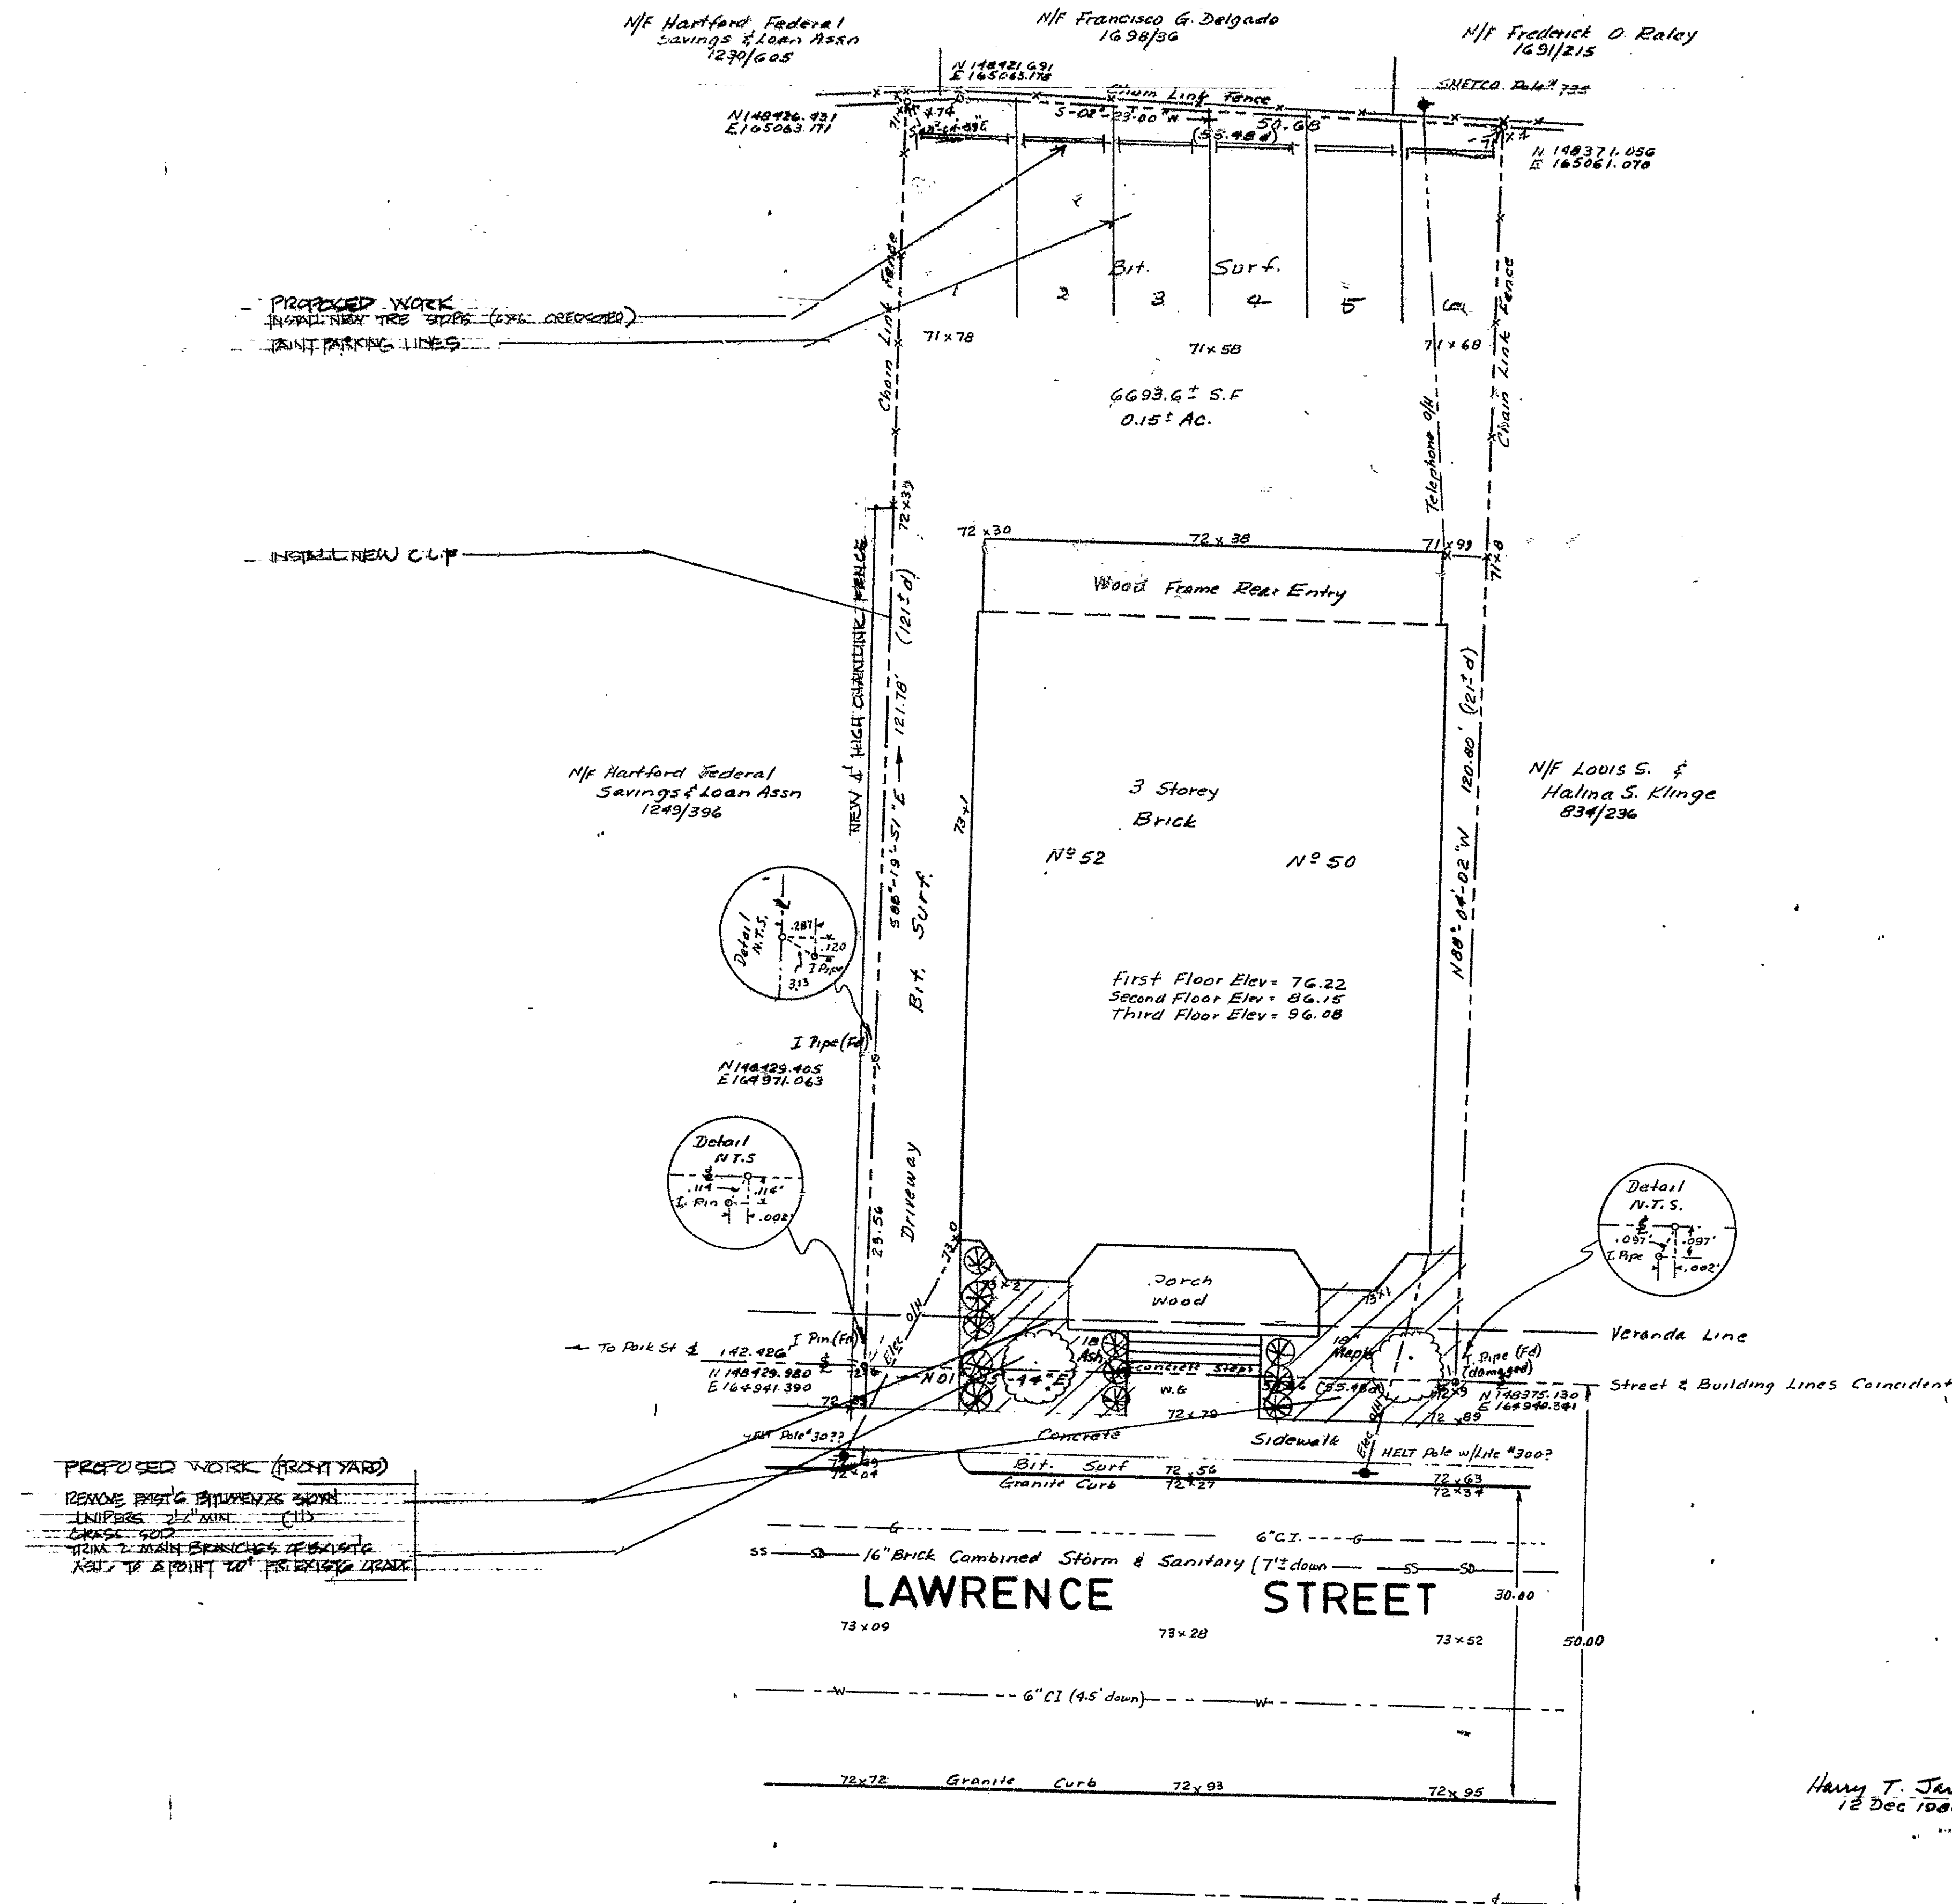

Notes:

1. Horizontal Data is based upon the Metropolitan District Commission System.
2. Vertical Data is based upon the Metropolitan District Commission System.
3. MDC datum is 2.08' higher than CGS datum.
4. The center line; data revisions 25 Mar 81.

Scale: 1" = 10'

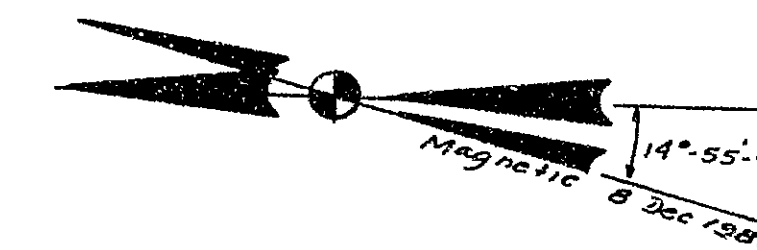

A-2

Harry T. Jansz
12 Dec 1980

"I HEREBY CERTIFY TO HARTFORD NATIONAL BANK AND TRUST CO. AND TO THE TITLE INSURANCE CO. THAT THIS SURVEY AND THE BOUNDARY AND MEASUREMENTS SHOWN HEREON ARE CORRECT WITHIN THE STANDARDS OF CLASS A-2 OF THE CODE OF THE TOWN OF HARTFORD, CONNECTICUT, AND THAT THE TITLE LINES AND LINE OF ACTUAL POSSESSION ARE THE SAME; THAT THE BUILDINGS ARE LOCATED AS SHOWN AND DO NOT ENCROACH OVER OR UPON STREET, TITLE OR BUILDING LINES; THAT THERE ARE NO VIOLATIONS OF ZONING ORDINANCES, RESTRICTIONS OR OTHER RULES AND REGULATIONS IN RESPECT TO THE LOCATION OF THE SAID BUILDINGS AND THAT THERE ARE NO EASEMENTS OR ENCROACHMENTS AFFECTING THIS PROPERTY APPARENT FROM CAREFUL INSPECTION OF THE SAME OTHER THAN THOSE SHOWN AND DEPICTED HEREON."

Harry T. Jansz N° 7570

80 XII-83

0 INCHES 1 2 3 4