


RECEIVED BY
SEP 19 11 23 AM '79
TOWN & CITY CLERK
HARTFORD
VOL. _____ PAGE _____

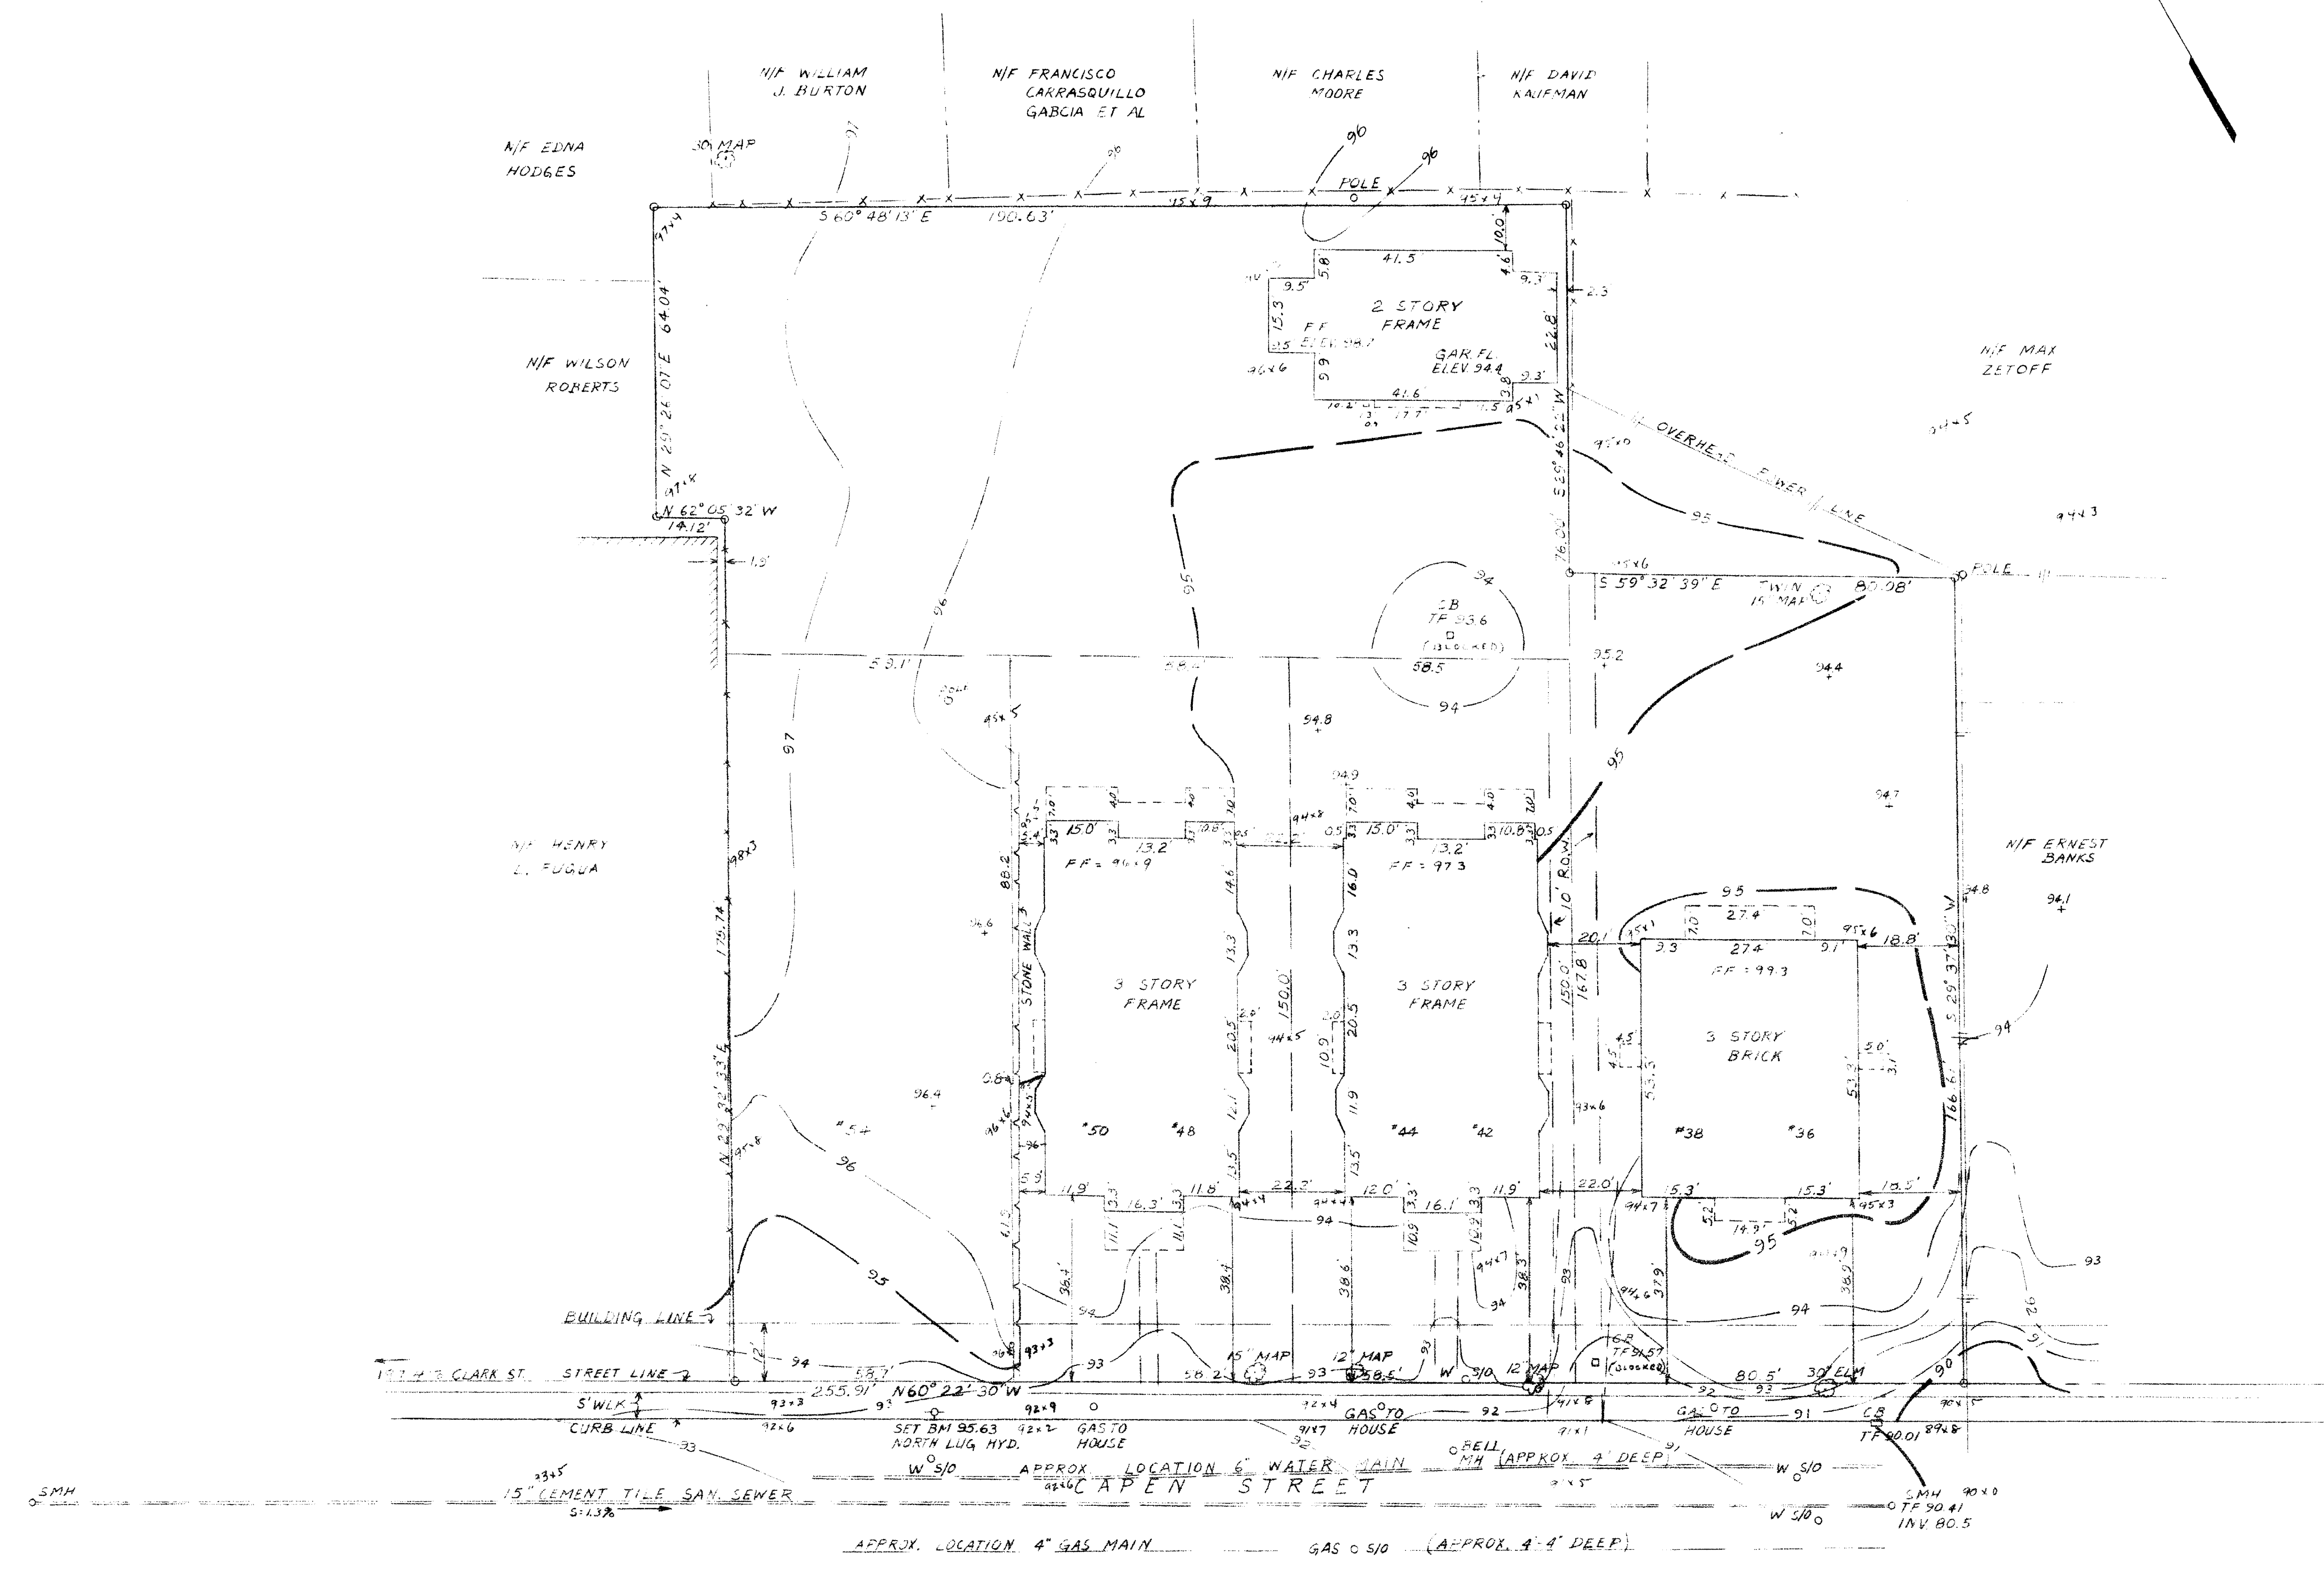


- NOTES
1. LOT ZONE R-3
 2. LOT AREA 57,030 S.F.
 3. ELEVATIONS BASED ON MDC DATUM
 4. UTILITIES RECORD ARE INCOMPLETE
LOCATIONS SHOWN ARE APPROXIMATE

The portion of Capen Street shown on this plan is an established public street of the City of Hartford.
September 1979
George E. Herbert
City Engineer

I HEREBY CERTIFY THAT THIS MAP AND SURVEY WERE PREPARED IN ACCORDANCE WITH THE STANDARDS OF A CLASS A-2 SURVEY AS DEFINED IN THE CODE OF PRACTICE FOR STANDARDS OF ACCURACY OF SURVEYS AND MAPS, ADOPTED DECEMBER 10, 1975 AS AMENDED BY THE CONNECTICUT ASSOCIATION OF LAND SURVEYORS, INC.
George E. Herbert SURVEYOR
DATE 4/30/79
REGISTRATION NO. 8498

HALLISEY & HERBERT CIVIL ENGINEERS & LAND SURVEYORS 2317 SILAS DEANE HIGHWAY, ROCKY HILL, CONNECTICUT		DRAWN: WD CHECKED: KH DATE: 29 NOV 1979 SCALE: 1" = 20' SHEET: 1 OF 1
PROPERTY OF PUBLIC HOUSING CORP. OF HARTFORD *36-54 CAPEN ST. HARTFORD, CONN.		
JOB NO. 164	REVISIONS	

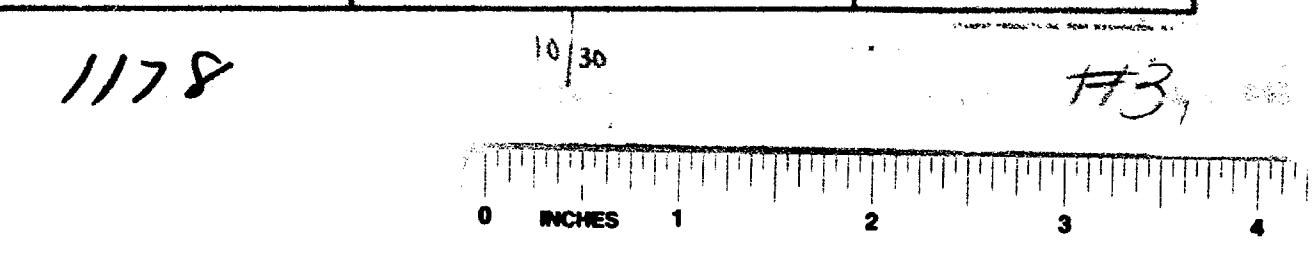

1178