


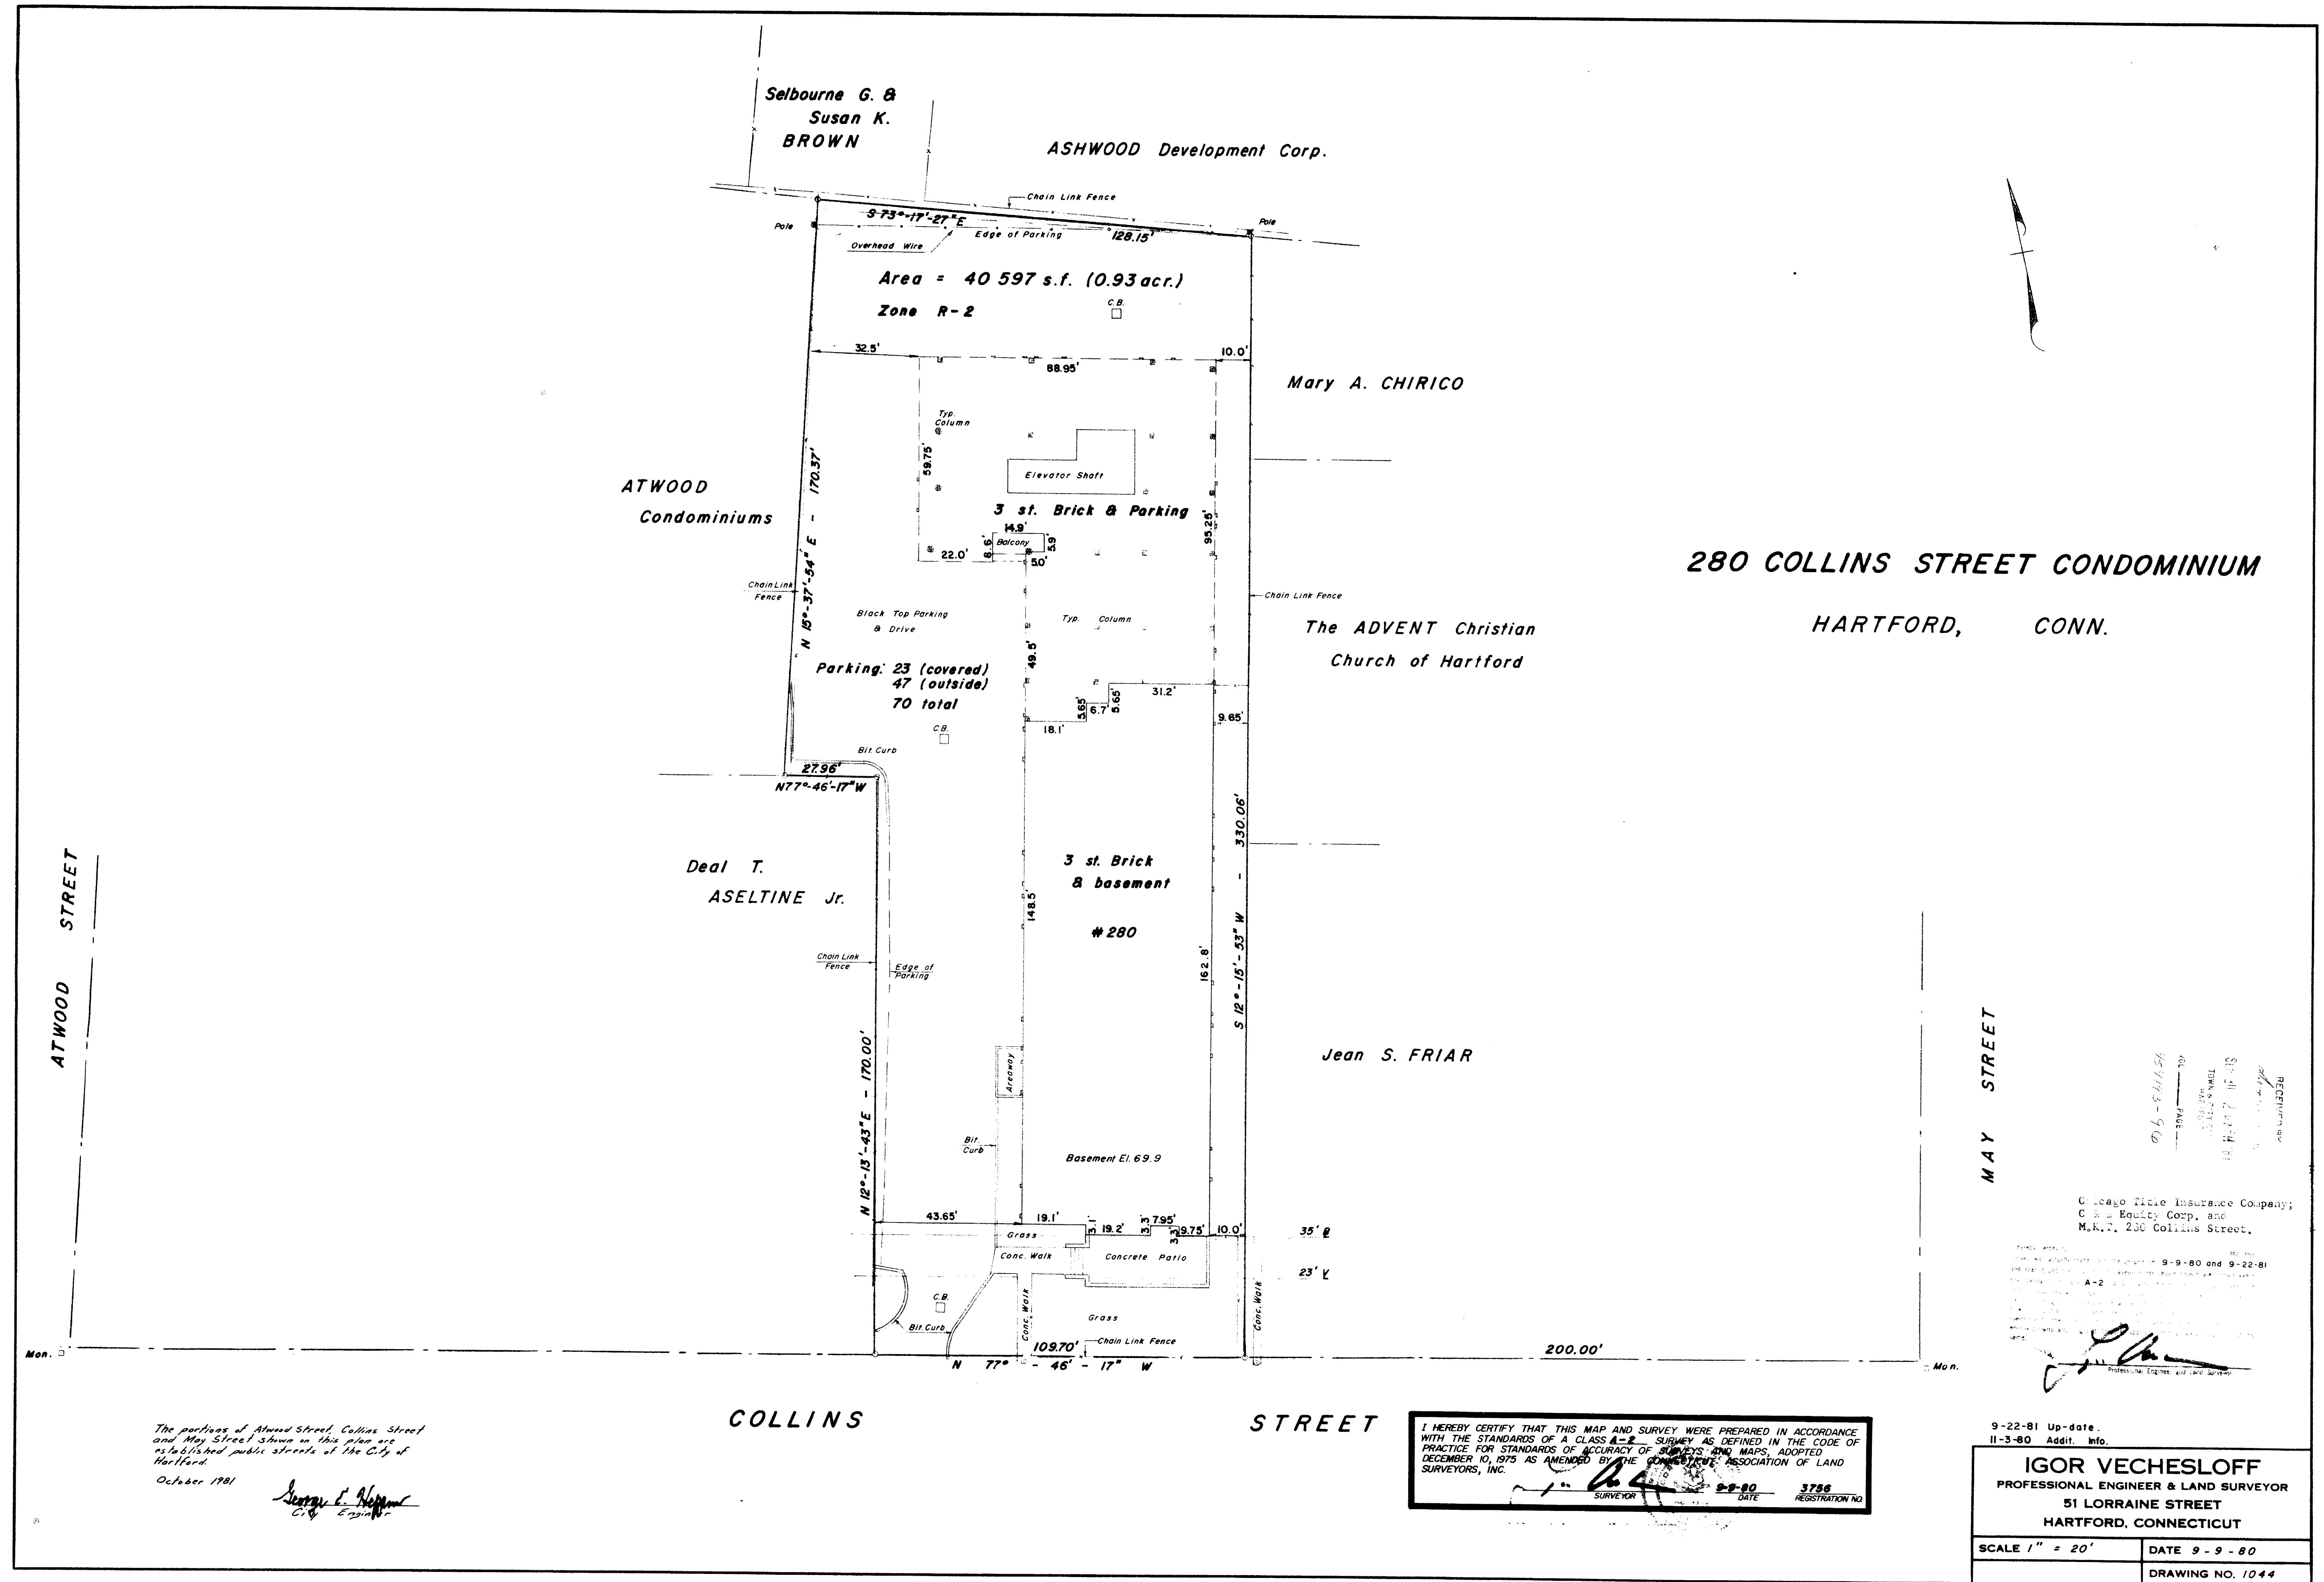

The portions of Atwood Street, Collins Street and May Street shown in this plan are established public streets of the City of Hartford.
October 1981
City Engineer


Chicago Title Insurance Company;
C. & E. Equity Corp. and
M.R.T., 280 Collins Street.

9-22-81 Up-date.
11-3-80 Addit. Info.
IGOR VECHELOFF
PROFESSIONAL ENGINEER & LAND SURVEYOR
51 LORRAINE STREET
HARTFORD, CONNECTICUT
SCALE 1" = 20' DATE 9-9-80
DRAWING NO. 1044

1179

1179

