

967 13 4 13 24 PM '81
TOWN & CITY CLERK
HARTFORD, CT
PAGE 454665

NOTARIAL PUBLIC
STATE OF CONNECTICUT
JACK M. KOSLOFF
6-1-81
I, JACK M. KOSLOFF, Notary Public for the State of Connecticut, do hereby certify that the foregoing is a true and correct copy of the original as the same appears to me.


Certified to be an accurate copy of portions of the original as the same appears to me.
JACK M. KOSLOFF, Notary Public
Date 6-1-81

Unit Floor Plans (Schematic)
To the Declaration of Condominium
By
Dated
Recorded Vol. Page
Hartford Land Records

Scale 1" = 32'-0"

ADNA CONDOMINIUM
CONDOMINIUM

design group one
architects-hartford, conn.
SHEET 17 OF 17
STATE OF CONNECTICUT
REGISTERED ARCHITECT

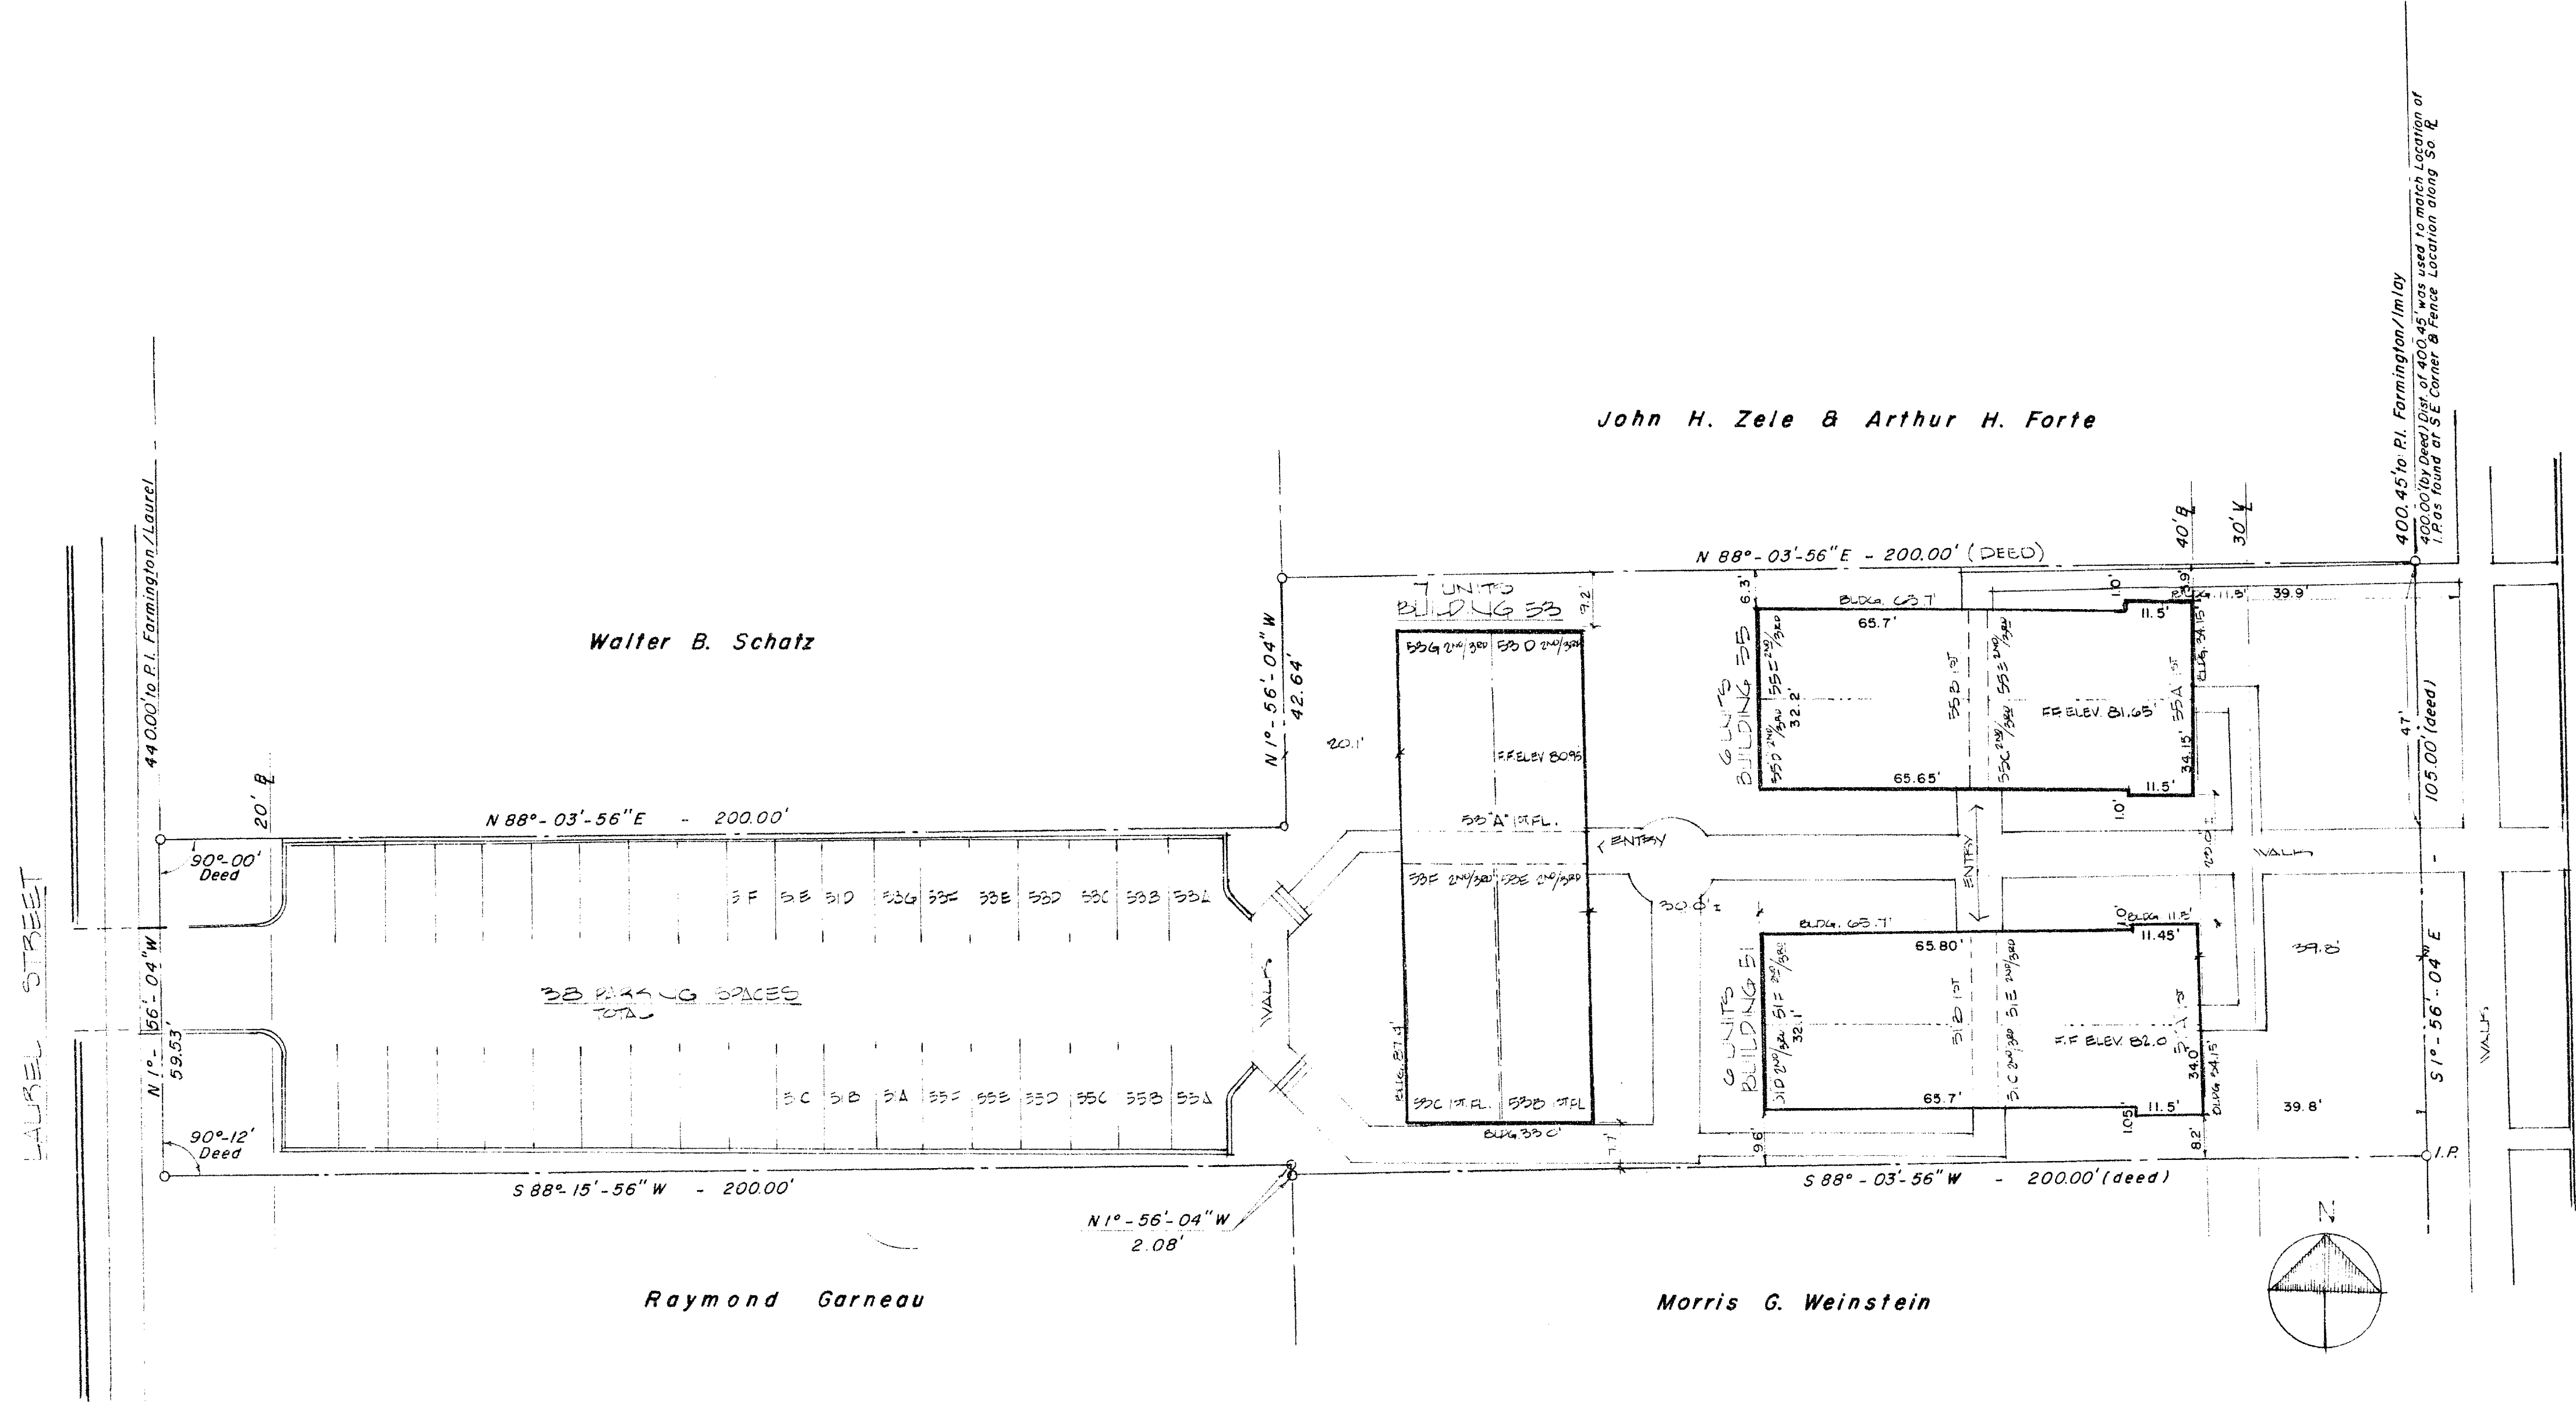

Zone: R-1
Area = 32 976 s.f.
(0.757ac.)

The portions of Laurel Street and Inlay Street shown on this plan are established public streets of the City of Hartford.


I HEREBY CERTIFY THAT THIS MAP AND SURVEY WERE PREPARED IN ACCORDANCE WITH THE STANDARDS OF A CLASS A-2 SURVEYOR AS DEFINED IN THE CODE OF PRACTICE FOR STANDARDS OF ACCURACY OF SURVEYING AND MAPS, ADOPTED DECEMBER 10, 1975 AS AMENDED BY THE CONNECTICUT ASSOCIATION OF LAND SURVEYORS, INC.
SURVEYOR
DATE 15-80
REGISTRATION NO. 3756