
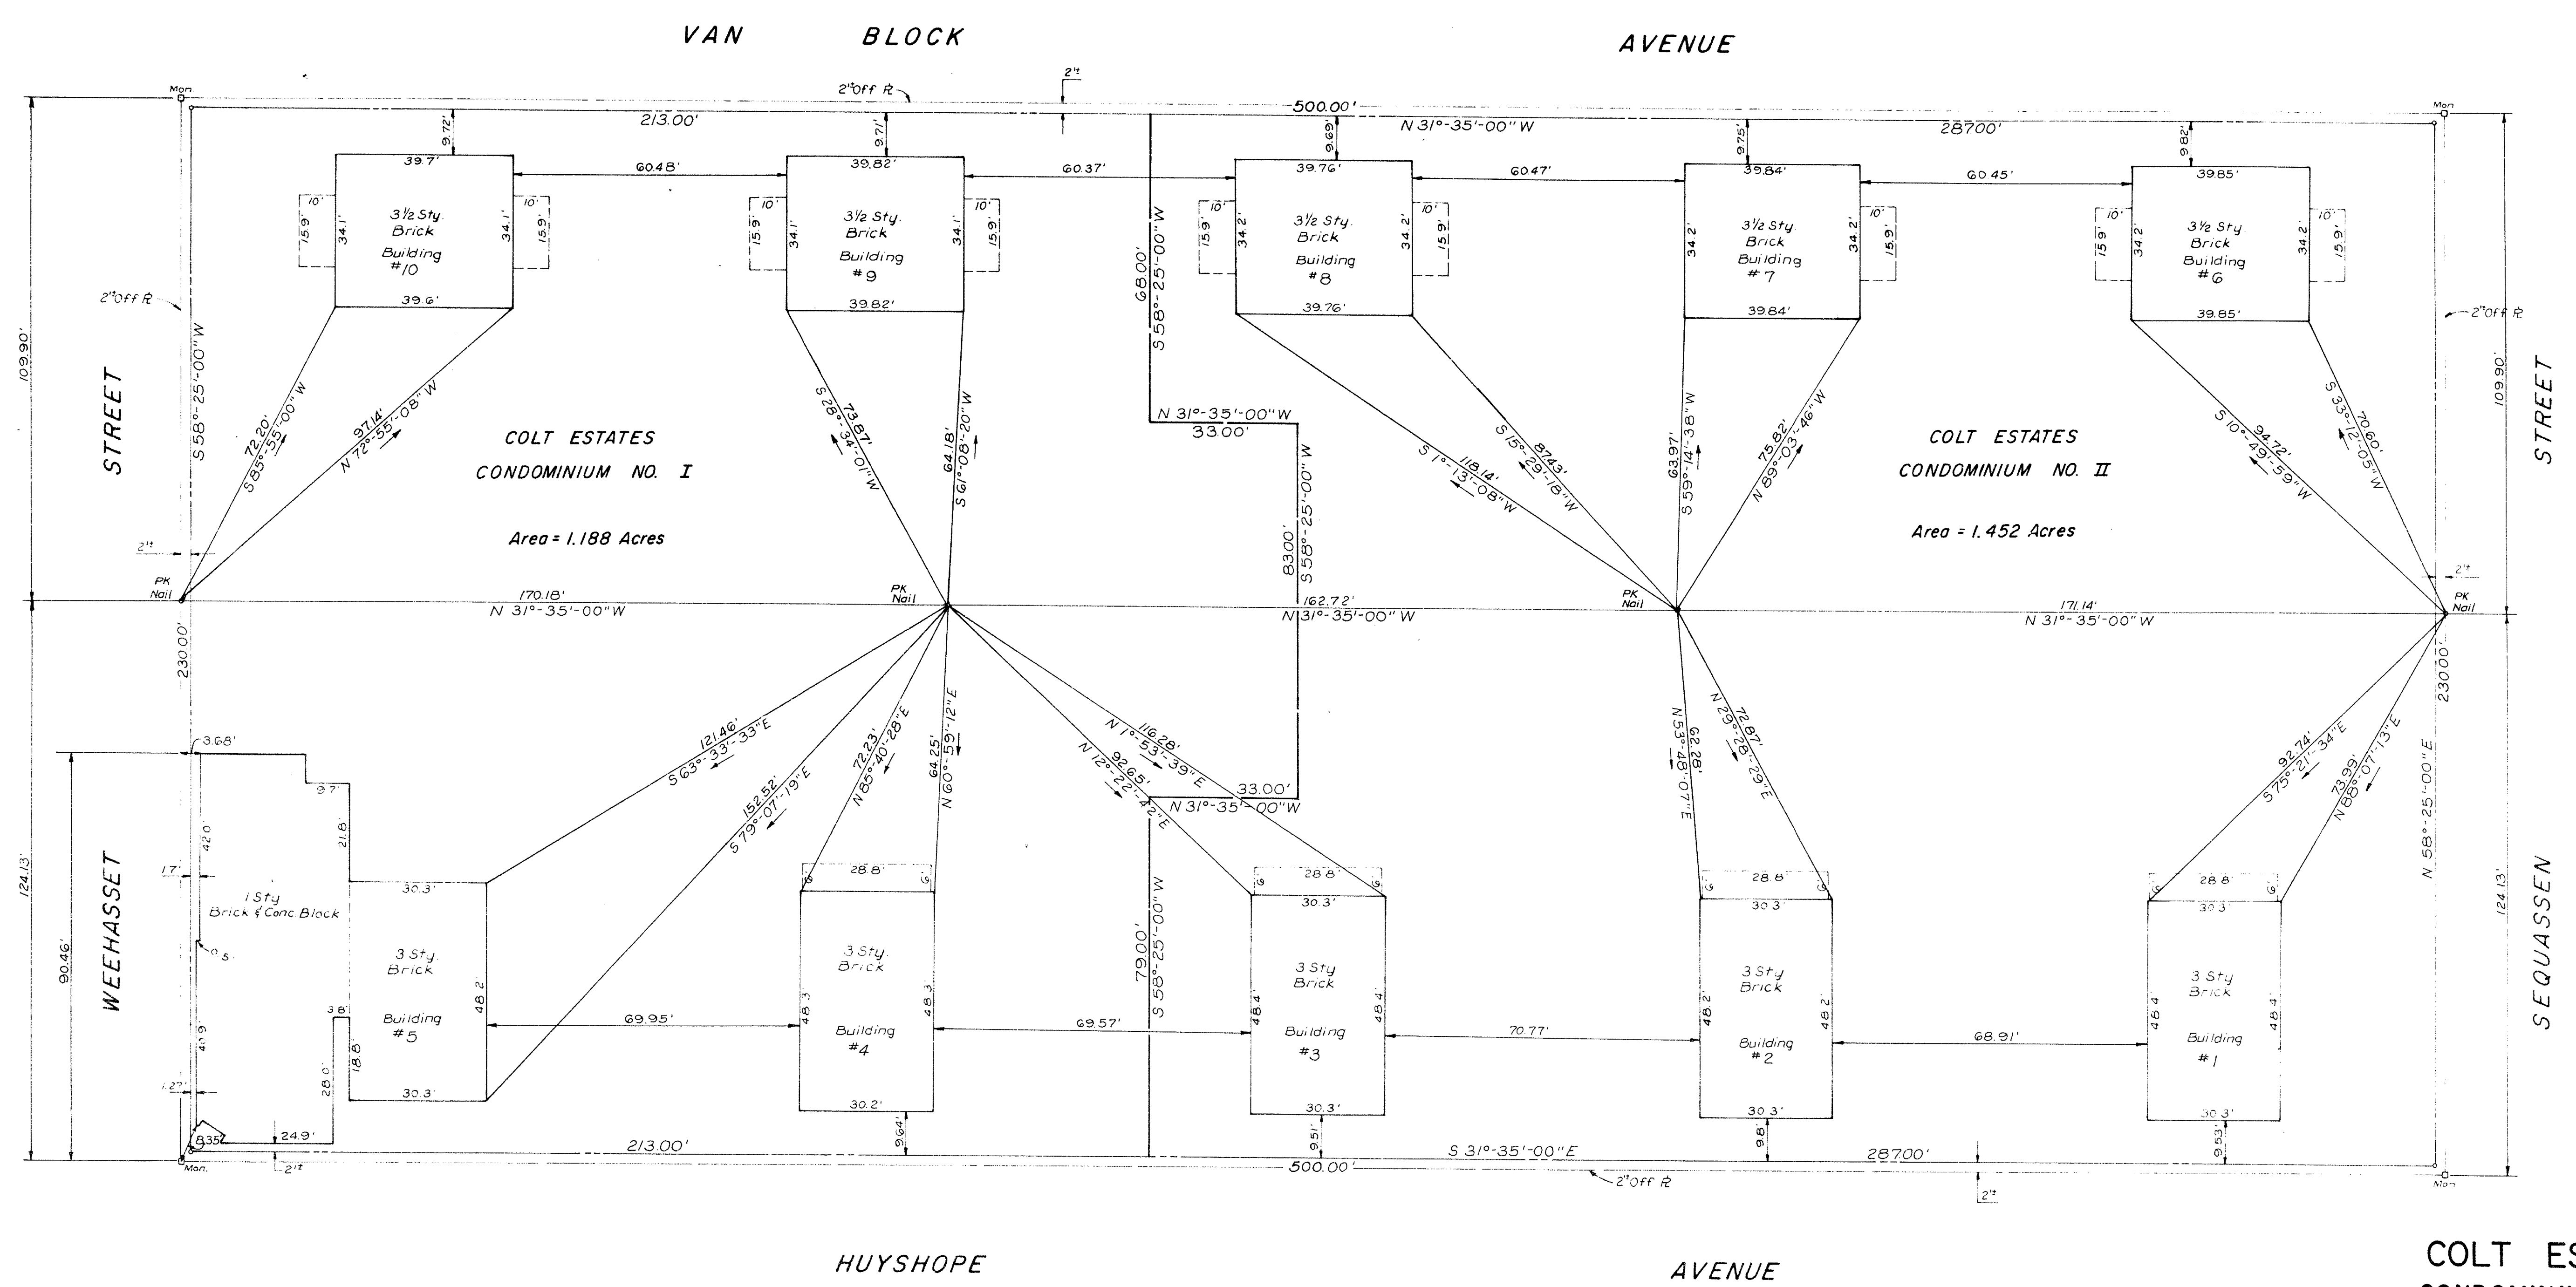


RECEIVED
SEP 11 4 05 PM '81
TOWN & CITY CLERK
HARTFORD
VOL PAGE

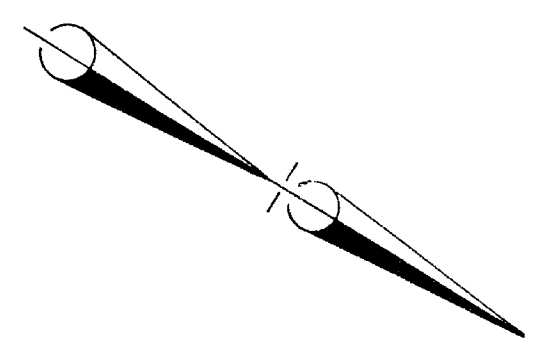

The portions of Van Block Avenue, Sequassen Street, Huyshope Avenue and Weehasset Street shown on this plan are established public streets of the City of Hartford.
September 1981
George C. Hoffman
City Engineer

COLT ESTATES
CONDOMINIUM NO. I
AND
COLT ESTATES
CONDOMINIUM NO. II
PROPERTY OF
SZENTKUTI ASSOCIATES
VAN BLOCK AVENUE, HUYSHOPE AVENUE,
SEQUASSEN STREET & WEEHASSET STREET
HARTFORD, CONNECTICUT

SCALE 1"=10'
SEPT 1980
Revised
Nov 24, 1980
Feb 10, 1981
March 16, 1981

JAMES J. LUZZI

James J. Luzzi Sept. 10, 80

TOTAL AREA = 2.640 ACRES

1185
1185-2

1185

