


The portions of Van Block Avenue, Sequassen Street, Hayslope Avenue and Weehasset Street shown on this plan are established public streets of the City of Hartford.

September 1981

WILLIAM PETCHLER ARCHITECT

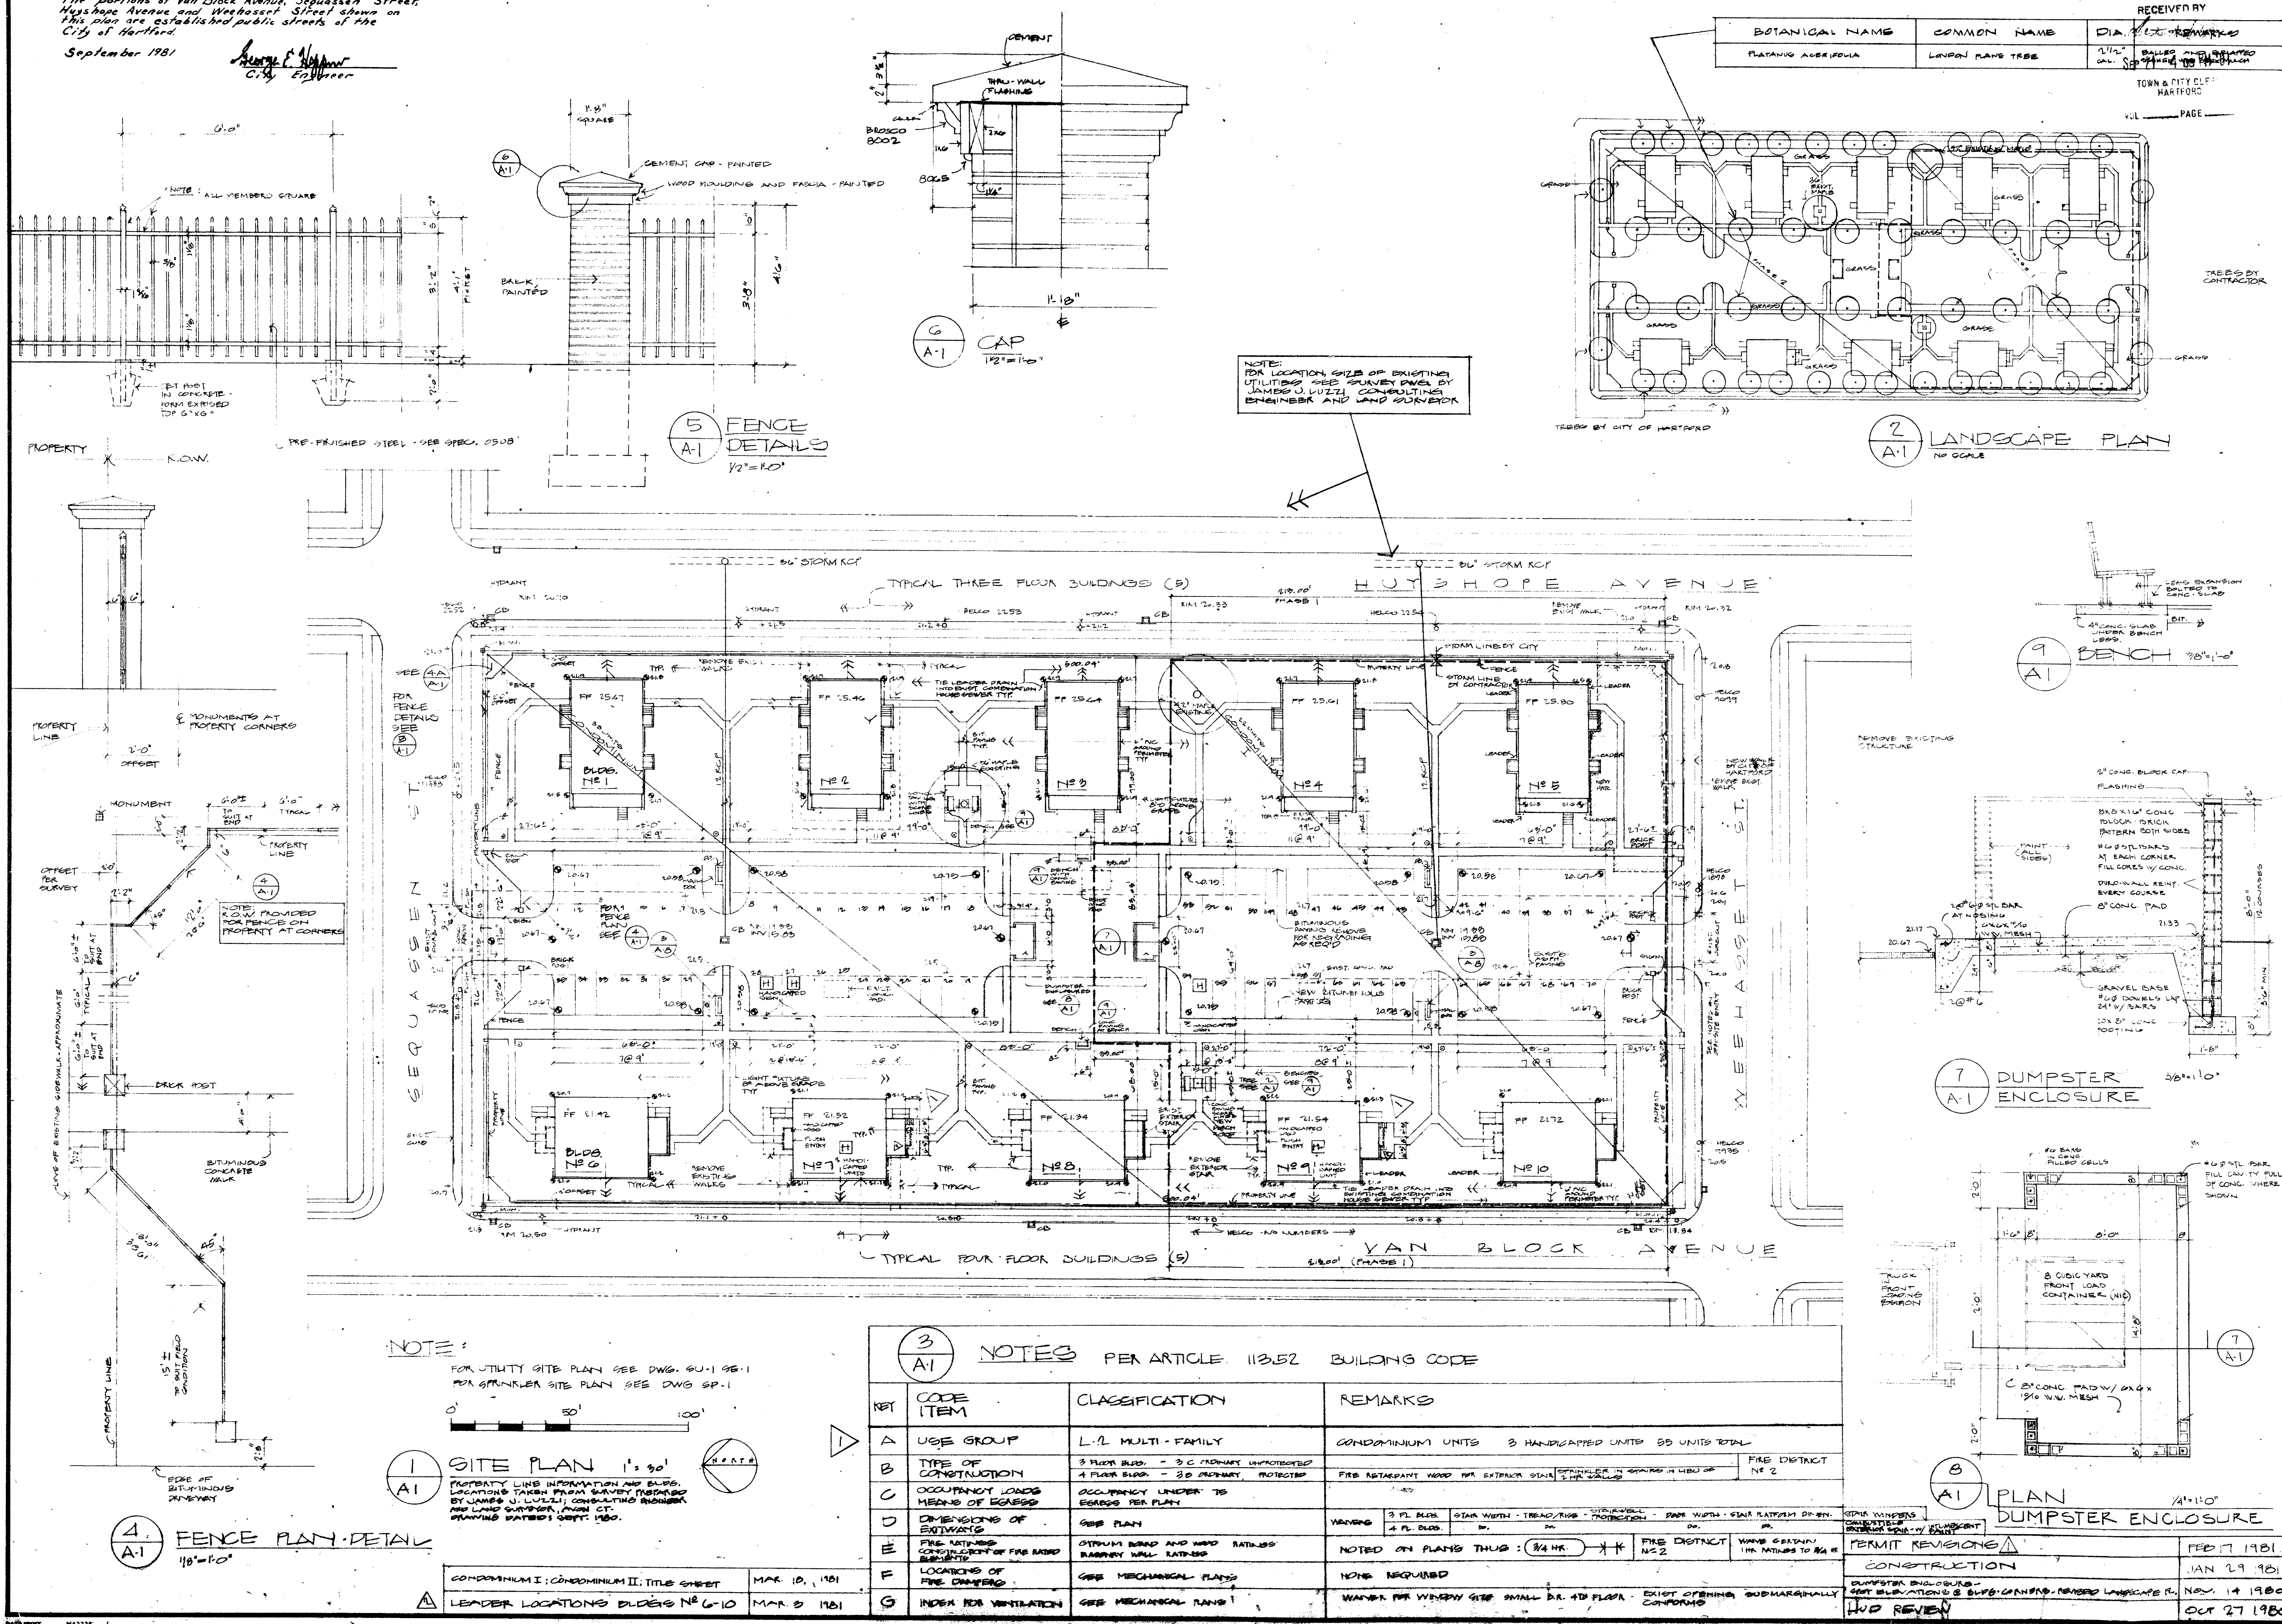

REVISIONS	BY

AS WILLOW STREET, NEW HAVEN, CONNECTICUT 06511 TEL. 203-787-6887
WILLIAM PETCHLER ARCHITECT

SITE PLAN

COLT ESTATES
HARTFORD, CT 06103
GENERAL CONTRACTOR
REAL ESTATE DEVELOPMENT

DATE
CHECKED
DRAWN
JOB
SHEET
OF SHEETS

A1

1185

1185