


1187-2

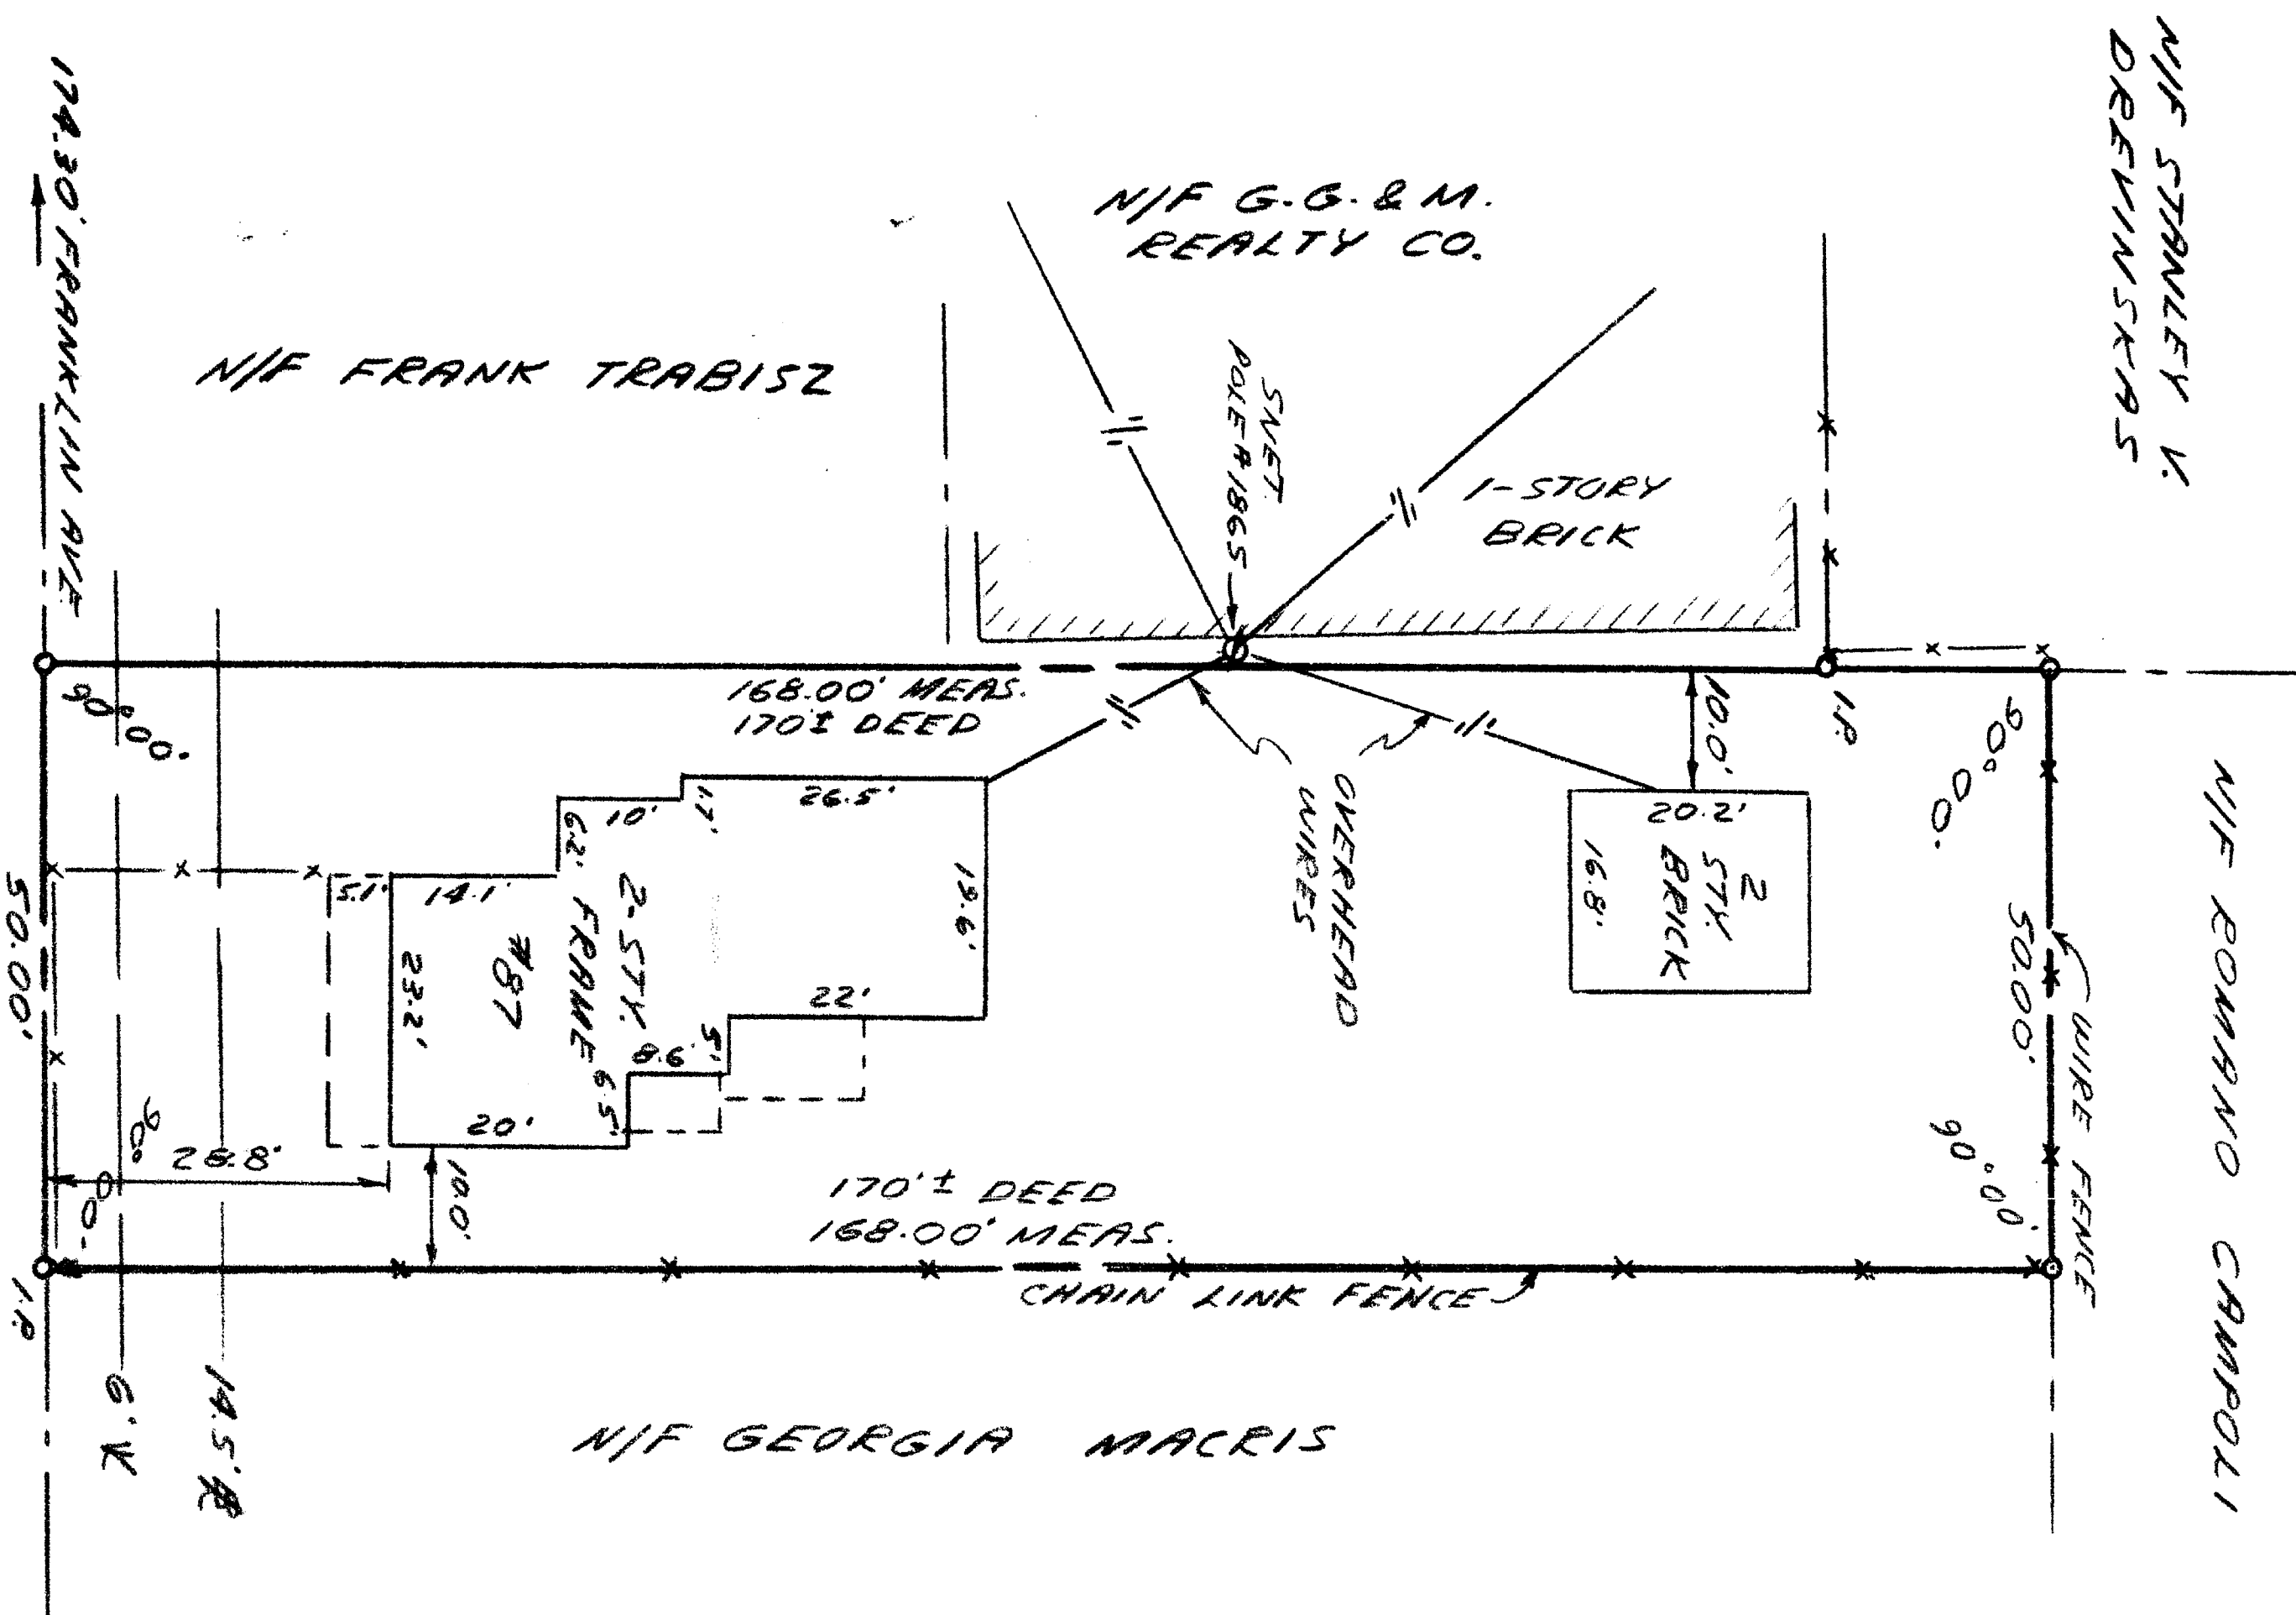

BENTON STREET

- NOTES**
1. LOT ZONE R-2
 2. LOT AREA 8400 SQ. FT.
 3. BUILDING NON CONFORMING UNDER PRESENT ZONING

NORTH AMERICAN BANK & TRUST CO.,
CHARLES J. & VERDIE V. HANEY, NEW YORK

I HEREBY CERTIFY TO U.S. LIFE TITLE INS. CO. OF NEW YORK THAT THIS SURVEY WAS ACCURATELY MADE UPON THE GROUND ON 10-21-81 AND THAT IT AND THE BOUNDS AND MEASUREMENTS SHOWN THEREON ARE CORRECT WITHIN THE STANDARDS OF CLASS A-2 AS DEFINED IN THE CODE OF PRACTICE FOR STANDARDS OF ACCURACY ADOPTED BY THE CONN. ASSOCIATION OF LAND SURVEYORS AND THAT THE BUILDINGS SHOWN, TITLE LINES AND LINES OF ACTUAL POSSESSION ARE CORRECT. THE BUILDINGS ARE LOCATED AS SHOWN AND DO NOT ENCROACH OVER OR UPON ADJACENT LOTS OR BUILDING LINES, THERE ARE NO VIOLATIONS OF ZONING REGULATIONS AND NO ENCROACHMENTS AFFECTING THIS PROPERTY APPARENT FROM A CAREFUL REVISION OF THE CASE.

This portion of Benton Street shown on this plan is an established public street of the City of Hartford.
Nov 1981
George S. Hagan
City Engineer

HALLISEY & HERBERT CIVIL ENGINEERS & LAND SURVEYORS 2317 SILAS DEANE HIGHWAY, ROCKY HILL, CONNECTICUT			
PROPERTY OF CHARLES J. & VERDIE V. HANEY 87 BENTON STREET HARTFORD, CONNECTICUT		JOB NO. 440	REVISIONS

1187

1187