


1189-5

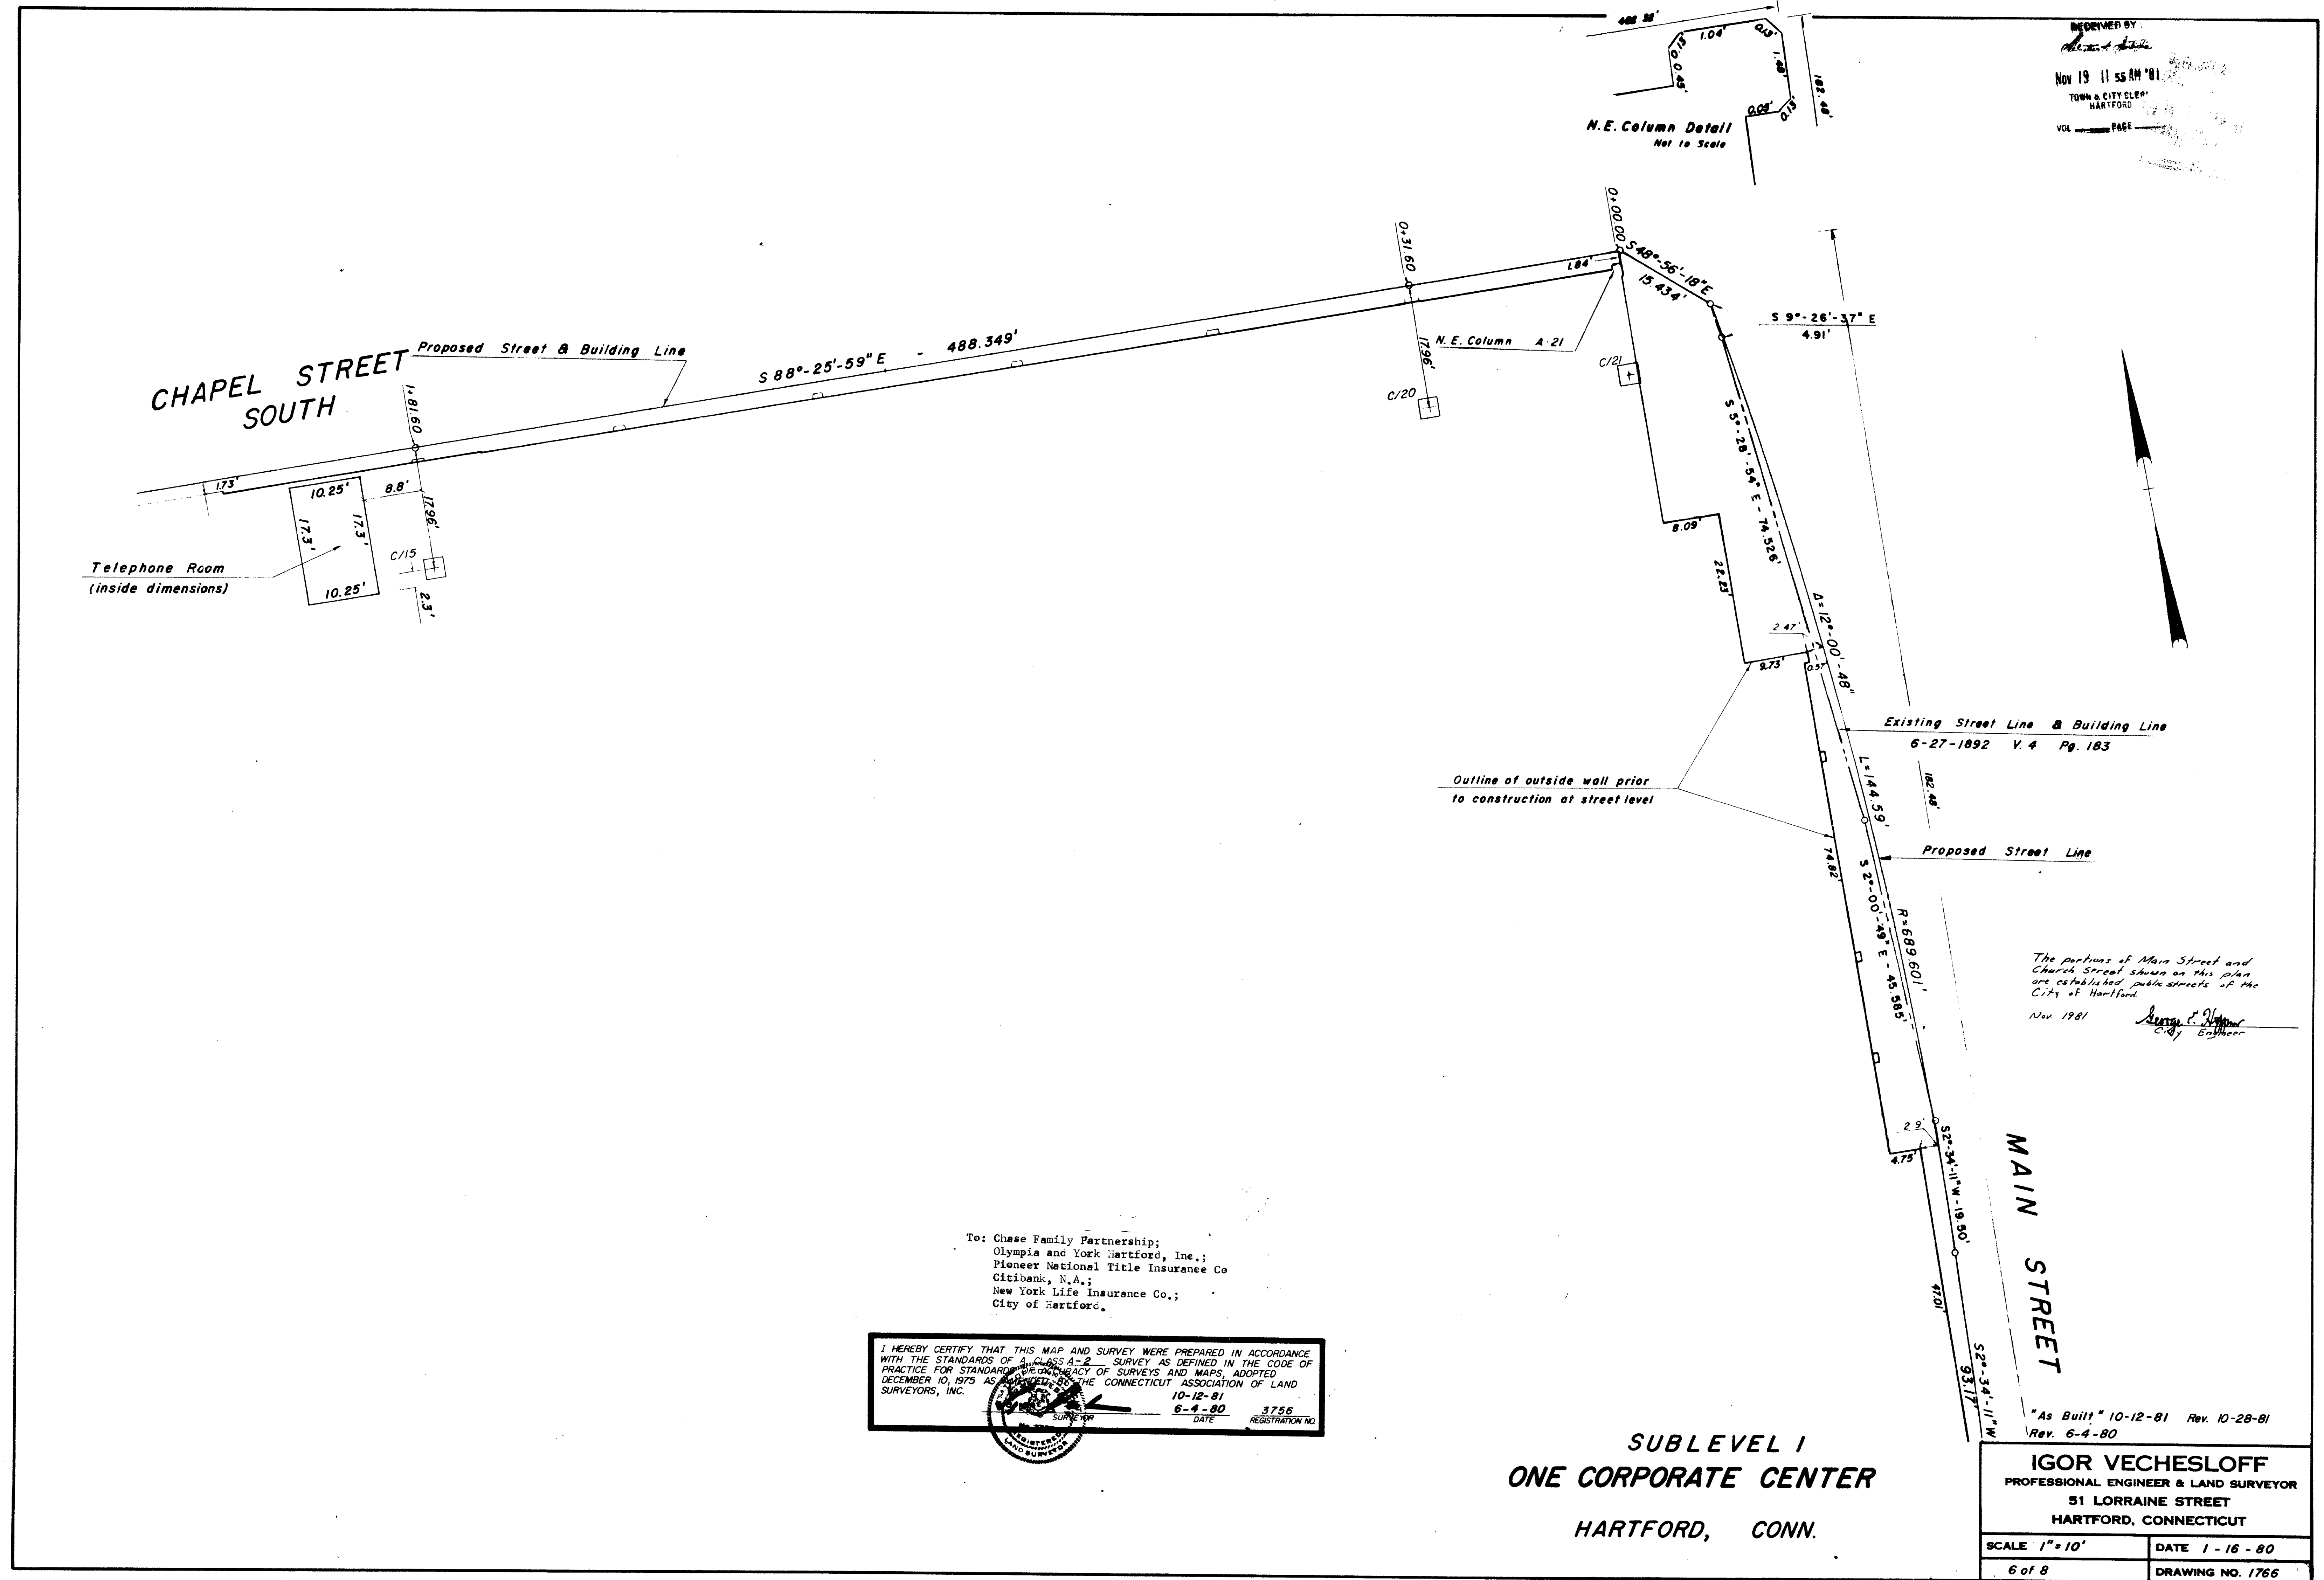

To: Chase Family Partnership;
Olympia and York Hartford, Inc.;
Pioneer National Title Insurance Co
Citibank, N.A.;
New York Life Insurance Co.;
City of Hartford.

I HEREBY CERTIFY THAT THIS MAP AND SURVEY WERE PREPARED IN ACCORDANCE WITH THE STANDARDS OF A CLASS A-2 SURVEY AS DEFINED IN THE CODE OF PRACTICE FOR STANDARD PRACTICE OF SURVEYS AND MAPS ADOPTED DECEMBER 10, 1975 AS AMENDED BY THE CONNECTICUT ASSOCIATION OF LAND SURVEYORS, INC.

10-12-81
6-4-80
3756
DATE
REGISTRATION NO.

SUBLEVEL 1
ONE CORPORATE CENTER
HARTFORD, CONN.

IGOR VECHELOFF
PROFESSIONAL ENGINEER & LAND SURVEYOR
51 LORRAINE STREET
HARTFORD, CONNECTICUT

SCALE 1"=10'
6 of 8

DATE 1-16-80
DRAWING NO. 1766

