1189-6

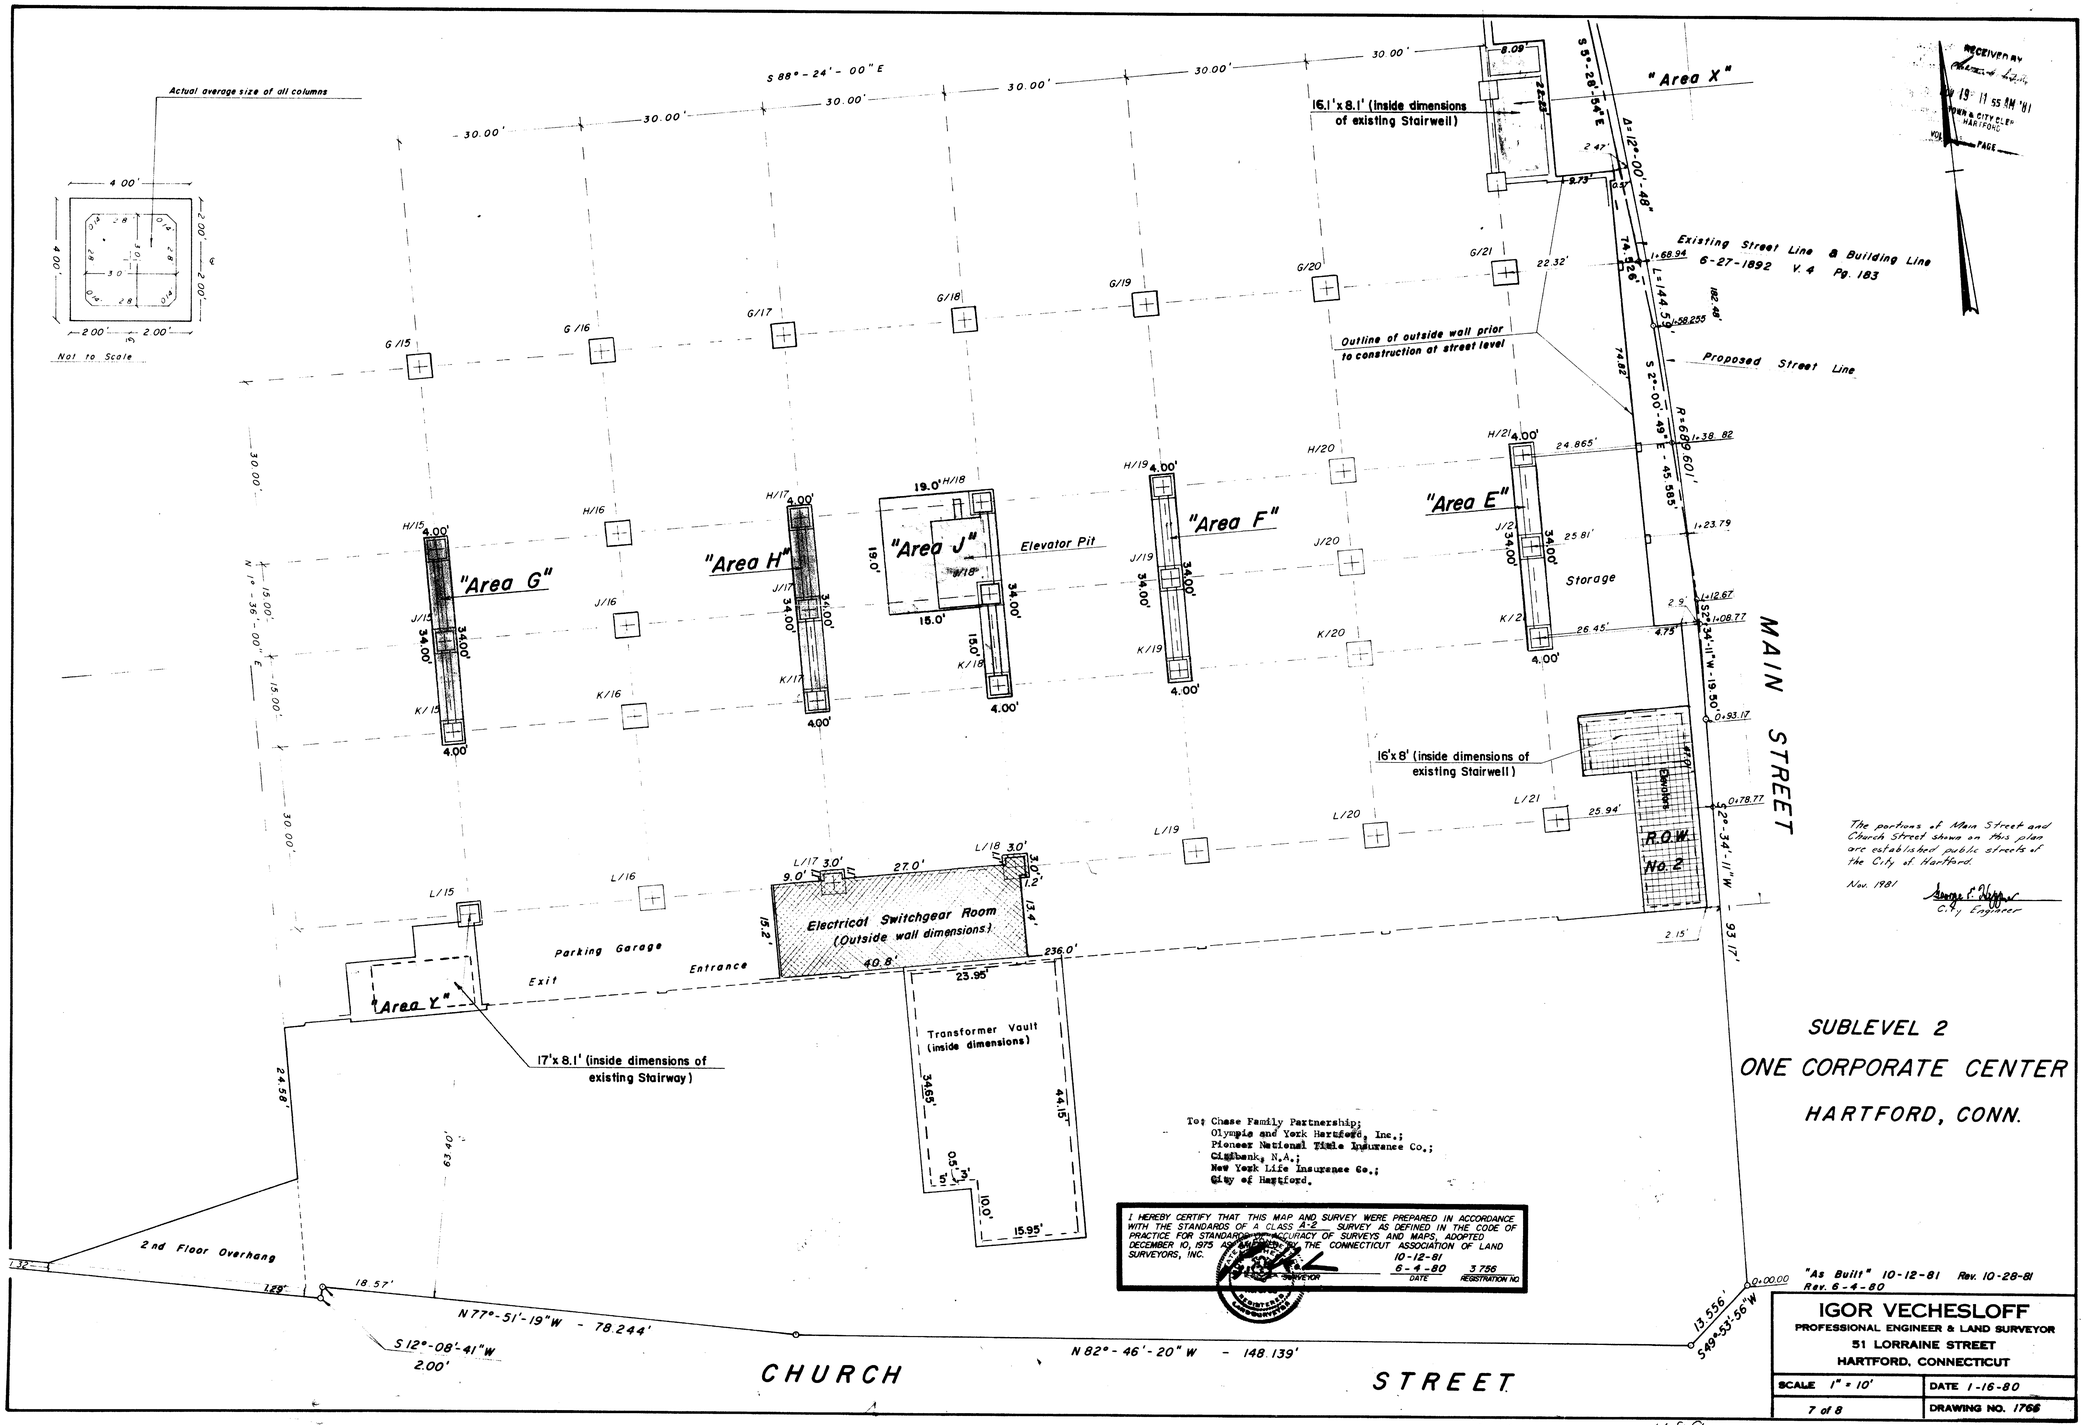
Actual average size of all columns
Not to Scale
"Area X"
16.1'x 8.1' (inside dimensions of existing Stairwell)
Existing Street Line & Building Line 6-27-1892 V. 4 Pg. 183
Proposed Street Line
Outline of outside wall prior to construction at street level
"Area E"
Storage
"Area F"
"Area G"
"Area H"
"Area J"
Elevator Pit
16'x 8' (inside dimensions of existing Stairwell)
Elevator
R.O.W. No. 2
MAIN STREET
Electrical Switchgear Room (Outside wall dimensions)
Parking Garage
Entrance
Exit
"Area Y"
17'x 8.1' (inside dimensions of existing Stairway)
Transformer Vault (inside dimensions)
2nd Floor Overhang
CHURCH STREET
N 77°-51'-19"W - 78.244'
N 82°-46'-20" W - 148.139'
S 12°-08'-41"W 2.00'
S 49°-53'-56"W 13.556'
"As Built" 10-12-81 Rev. 10-28-81 Rev. 6-4-80
The portions of Main Street and Church Street shown on this plan are established public streets of the City of Hartford.
Nov. 1981
City Engineer
SUBLEVEL 2
ONE CORPORATE CENTER
HARTFORD, CONN.
To: Chase Family Partnership;
Olympia and York Hartford, Inc.;
Pioneer National Title Insurance Co.;
Citibank, N.A.;
New York Life Insurance Co.;
City of Hartford.
I HEREBY CERTIFY THAT THIS MAP AND SURVEY WERE PREPARED IN ACCORDANCE WITH THE STANDARDS OF A CLASS A-2 SURVEY AS DEFINED IN THE CODE OF PRACTICE FOR STANDARDS OF ACCURACY OF SURVEYS AND MAPS, ADOPTED DECEMBER 10, 1975 AS MODIFIED BY THE CONNECTICUT ASSOCIATION OF LAND SURVEYORS, INC.
10-12-81
6-4-80
DATE
3756
REGISTRATION NO.
IGOR VECHESLOFF
PROFESSIONAL ENGINEER & LAND SURVEYOR
51 LORRAINE STREET
HARTFORD, CONNECTICUT
SCALE 1" = 10'
DATE 1-16-80
7 of 8
DRAWING NO. 1768

1189