


1189-7

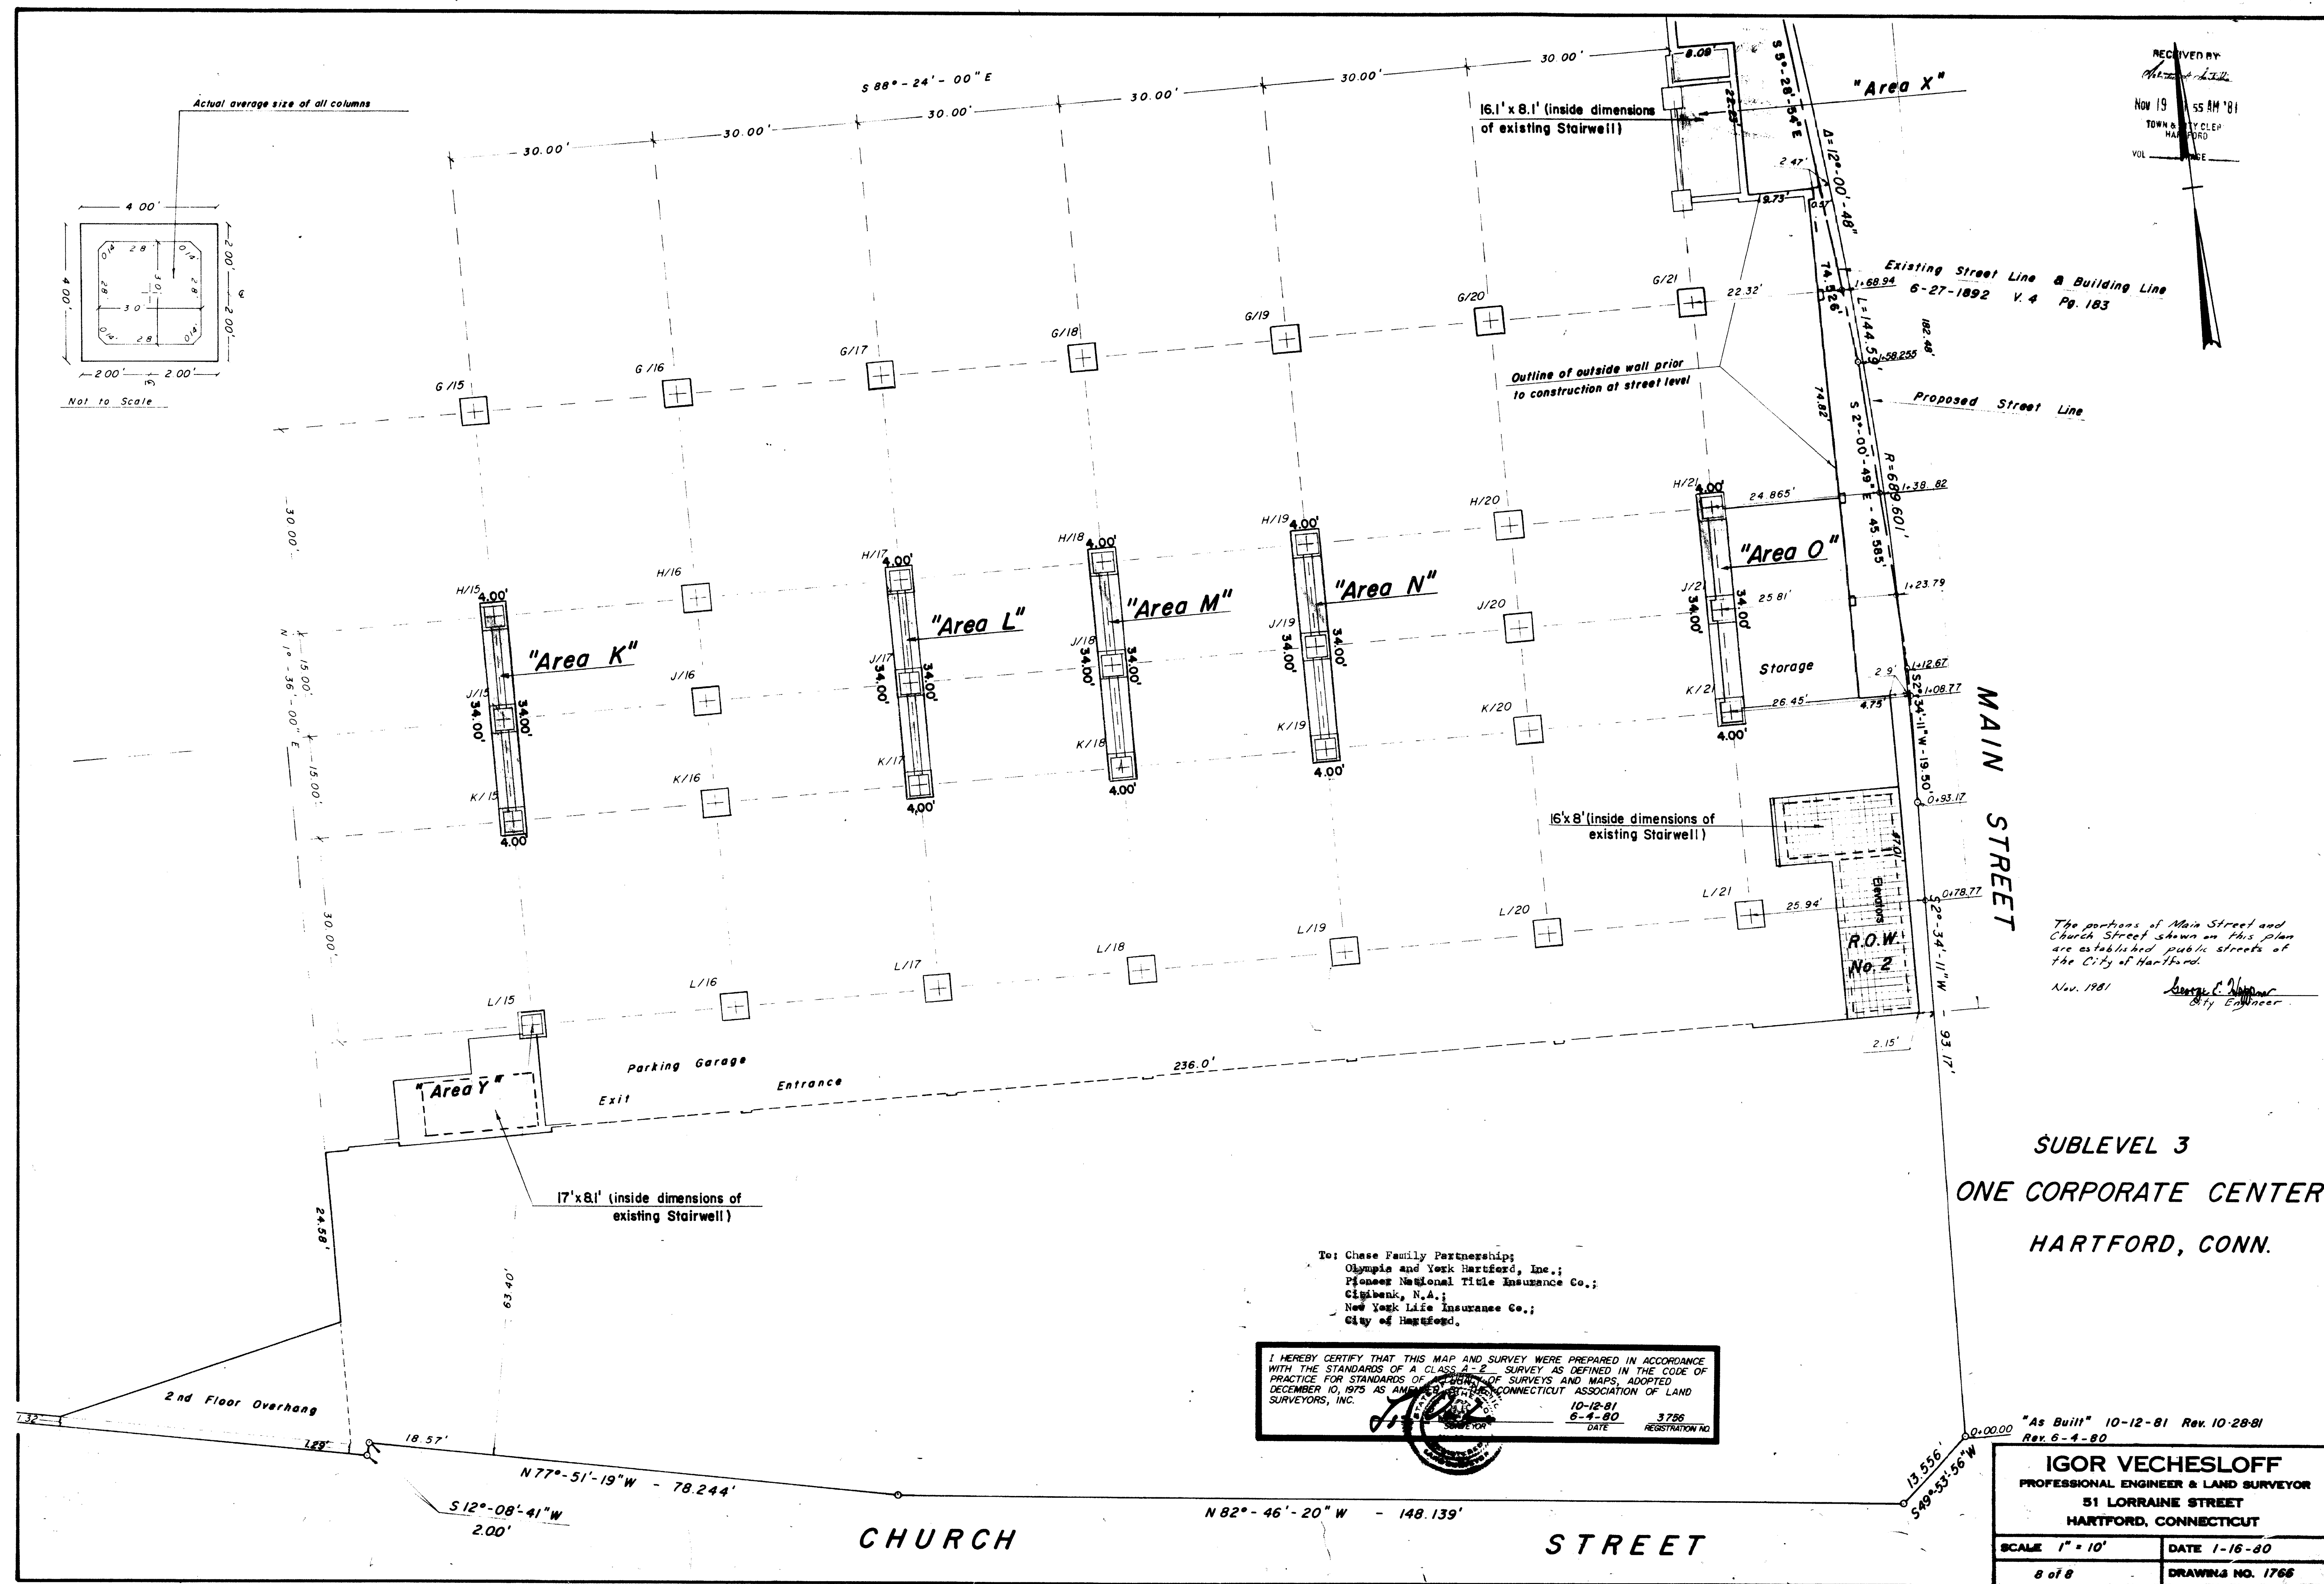

1189