


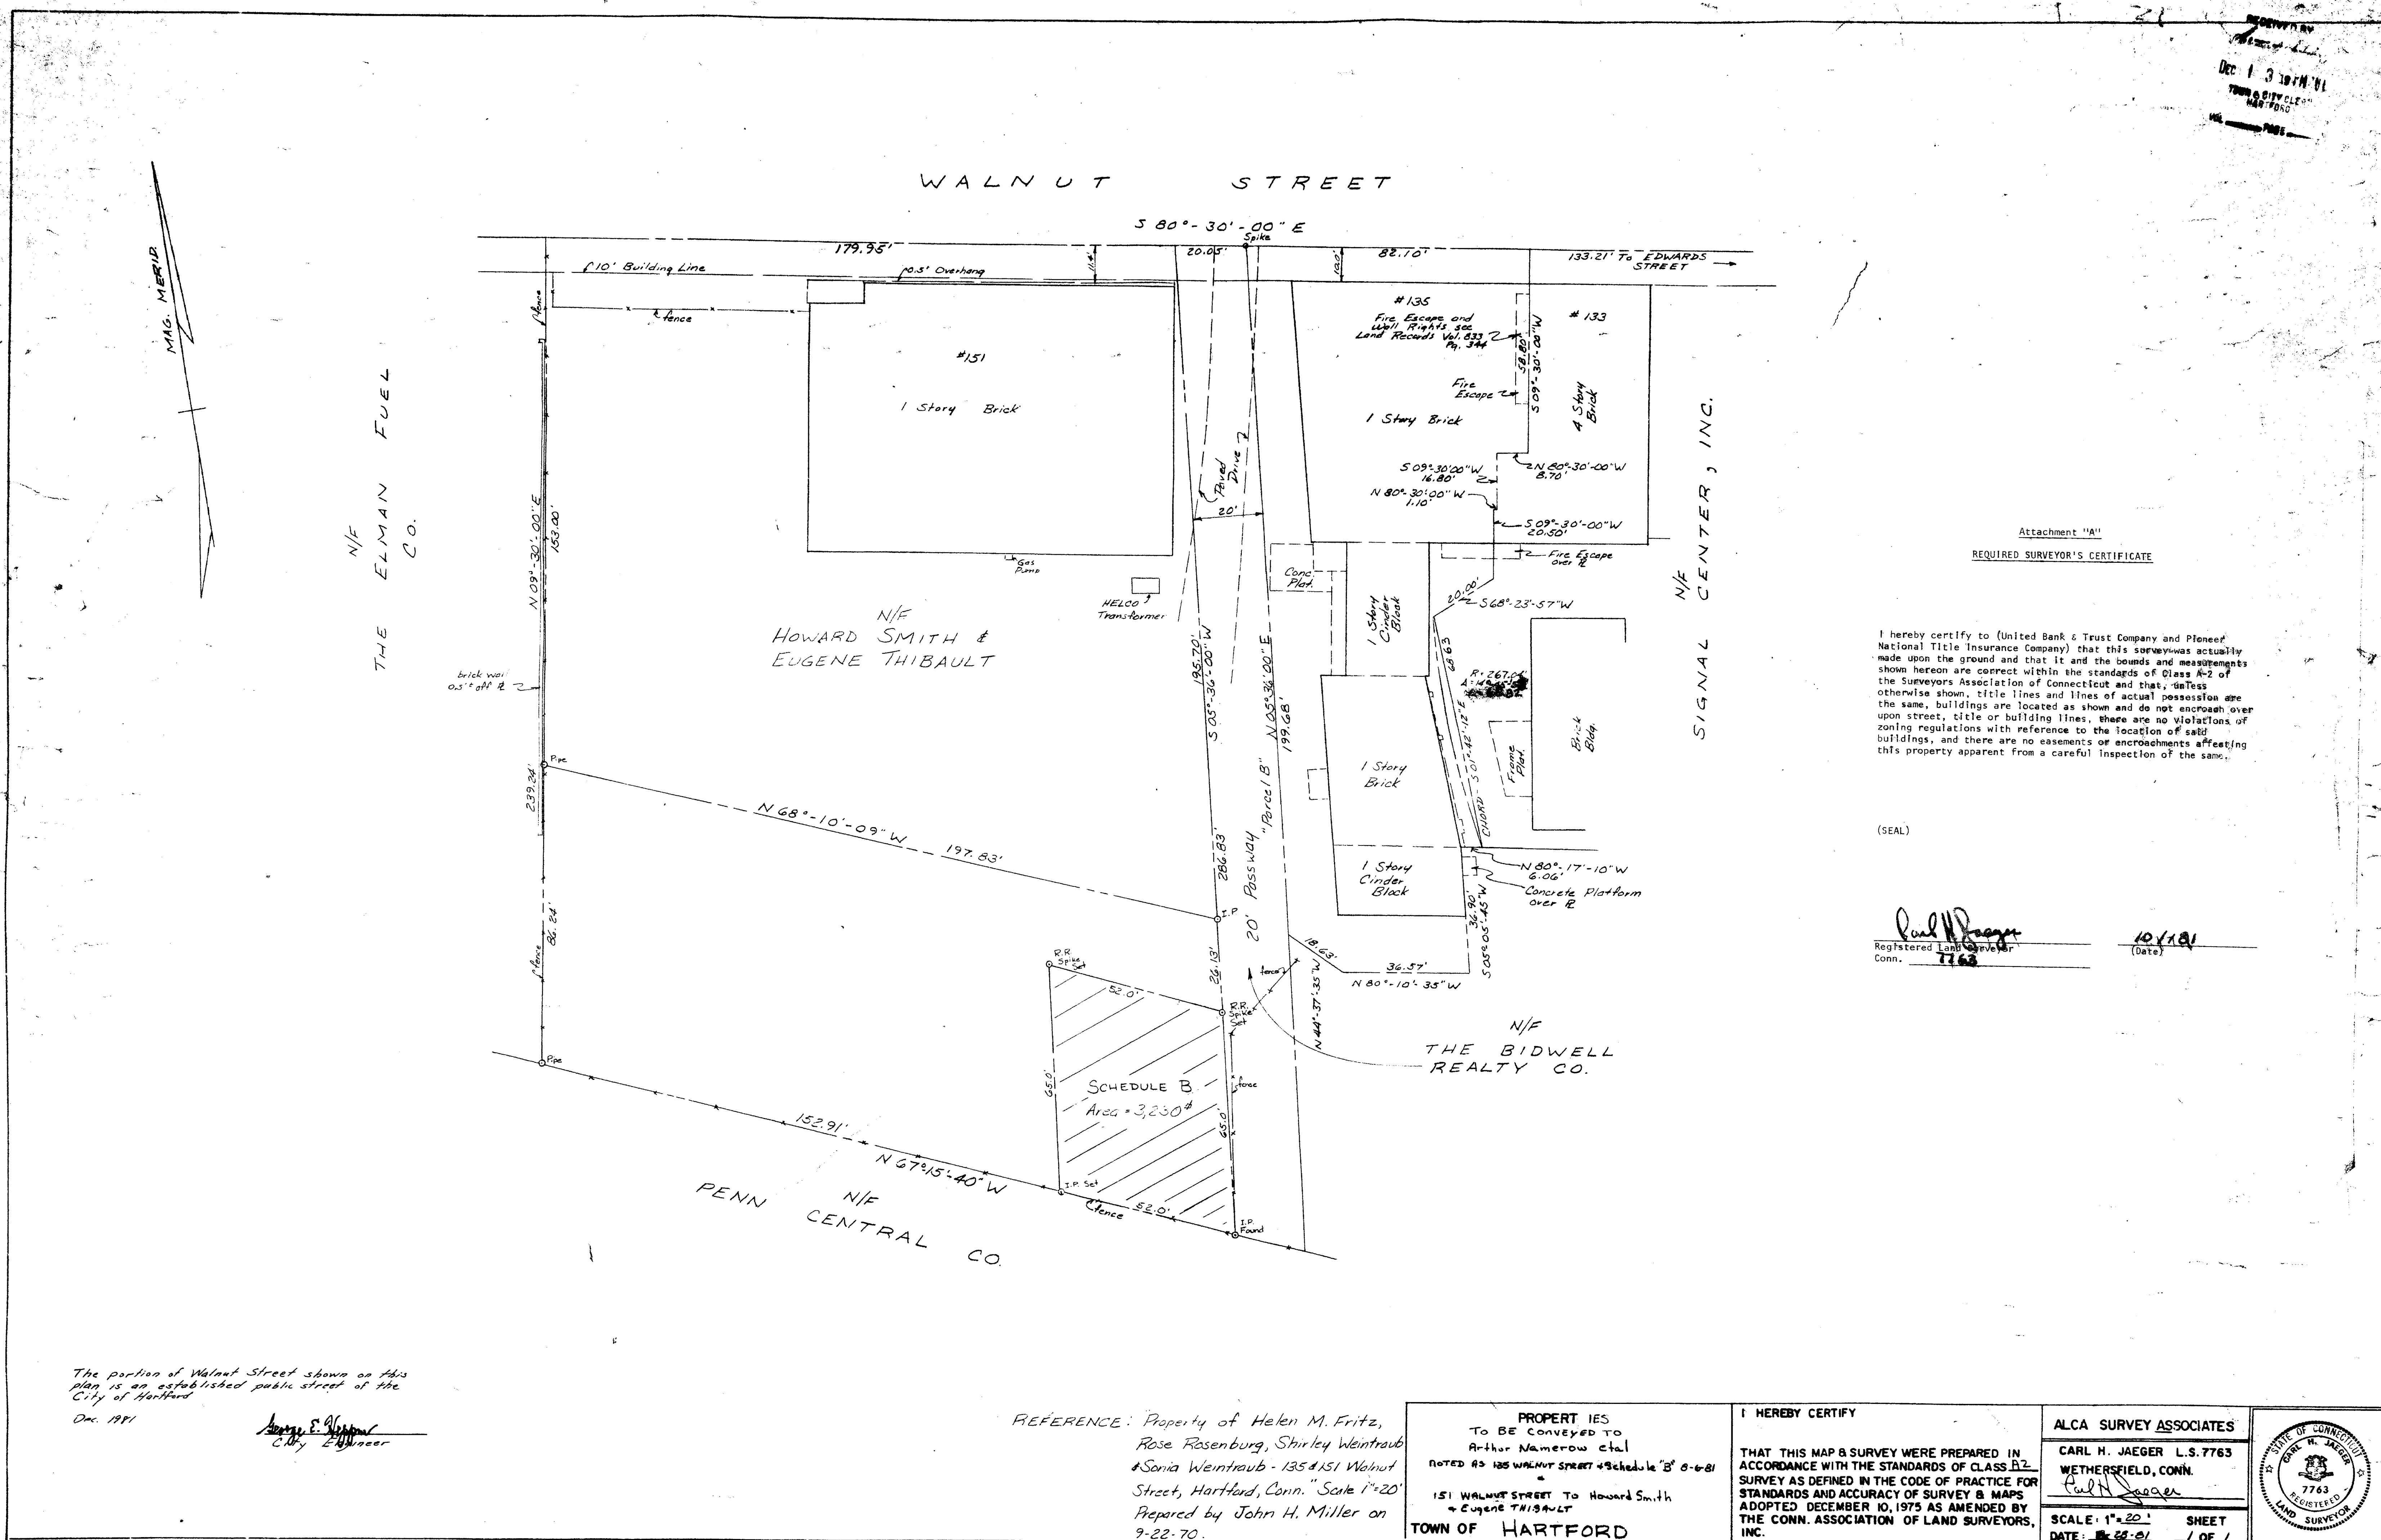

(SEAL)


Registered Land Surveyor
Conn. 7763

10/18
(Date)

ALCA SURVEY ASSOCIATES

CARL H. JAEGER L.S. 7763
WETHERSFIELD, CONN.

SCALE: 1" = 20' SHEET
DATE: 11-28-01 / OF /

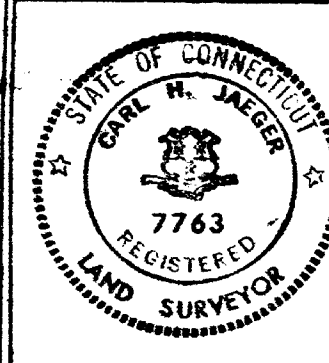

1190	