


WETHERSFIELD AVENUE

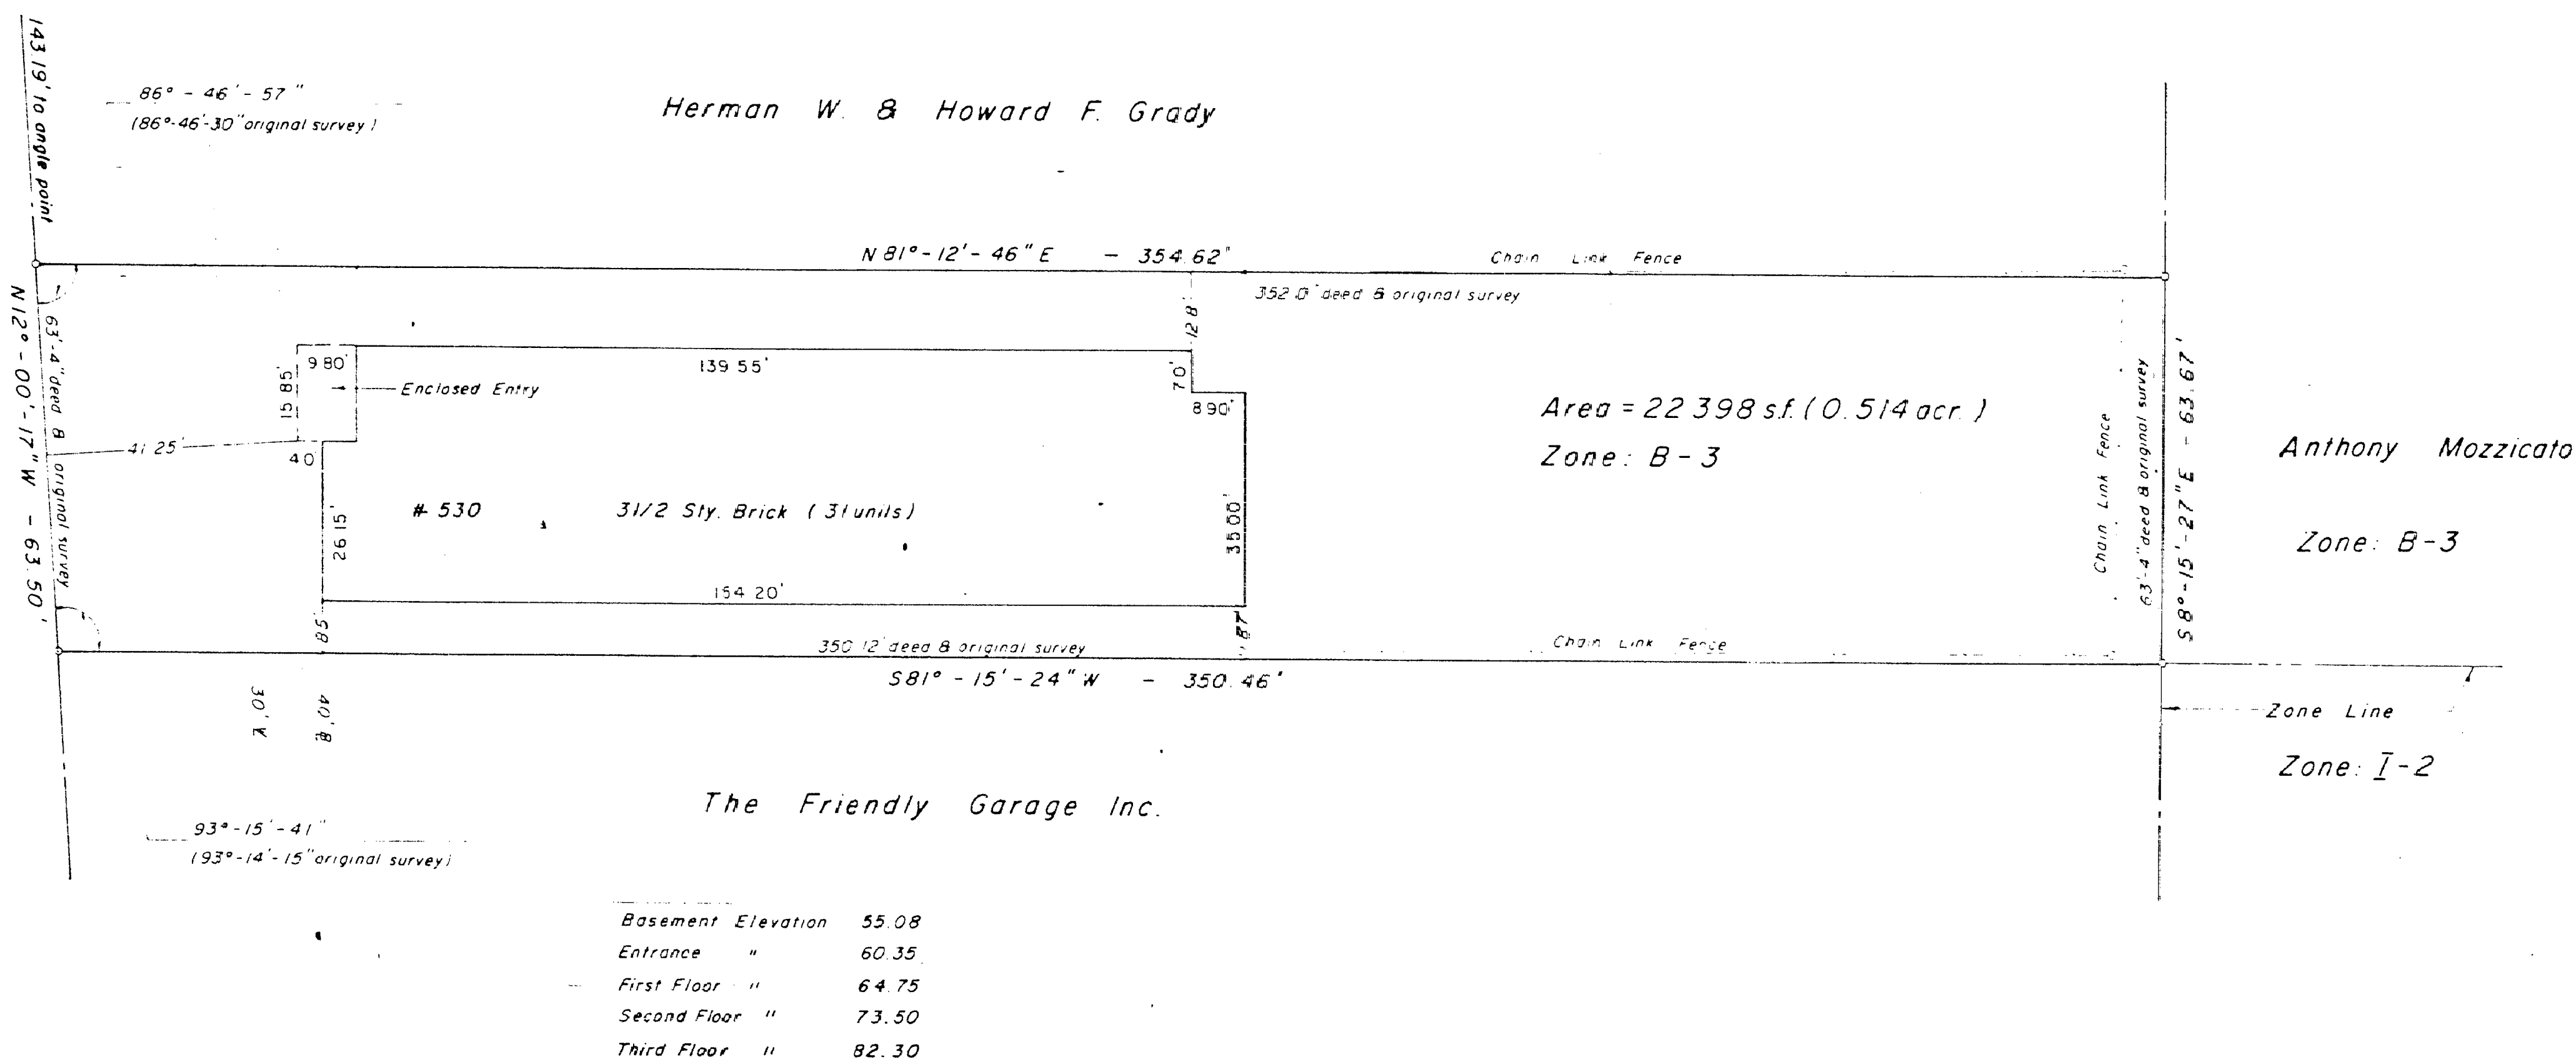

The portion of Wethersfield Ave. shown on this plan is an established public street of the City of Hartford.

March 1982 *George T. Hoffman*
City Engineer

SURVEY MAP
Property of
AETNA APARTMENTS
COOPERATIVE CORPORATION
530 WETHERSFIELD AVENUE
HARTFORD, CONNECTICUT

NOTE: Perimeter as shown (derived from original survey & deed information) is in accordance with map entitled "Map of Lands East Side of Wethersfield Avenue - Nos. 519 to 531 & Howard St., Hartford, Conn." dated Jan. 21, 1975, by Department of Public Works, Bureau of Engineering Services, City of Hartford (certified by F.J. D'Onofrio, L.S.).

I HEREBY CERTIFY THAT THIS MAP AND SURVEY WERE PREPARED IN ACCORDANCE WITH THE STANDARDS OF A CLASS A-2 SURVEY AS DEFINED IN THE CODE OF PRACTICE FOR STANDARDS OF ACCURACY OF SURVEYS AND MAPS, ADOPTED DECEMBER 10, 1975 AS AMENDED BY THE CONNECTICUT ASSOCIATION OF LAND SURVEYORS, INC.

3-6-80
DATE
REGISTRATION NO.

NOTE:
Elevation Based on M.D.C. Datum

12-4-81 Elevation

IGOR VECHELOFF
PROFESSIONAL ENGINEER & LAND SURVEYOR
51 LORRAINE STREET
HARTFORD, CONNECTICUT
SCALE 1" = 20'
DATE 3-6-80
DRAWING NO. 1050

0 INCHES 1 2 3 4