



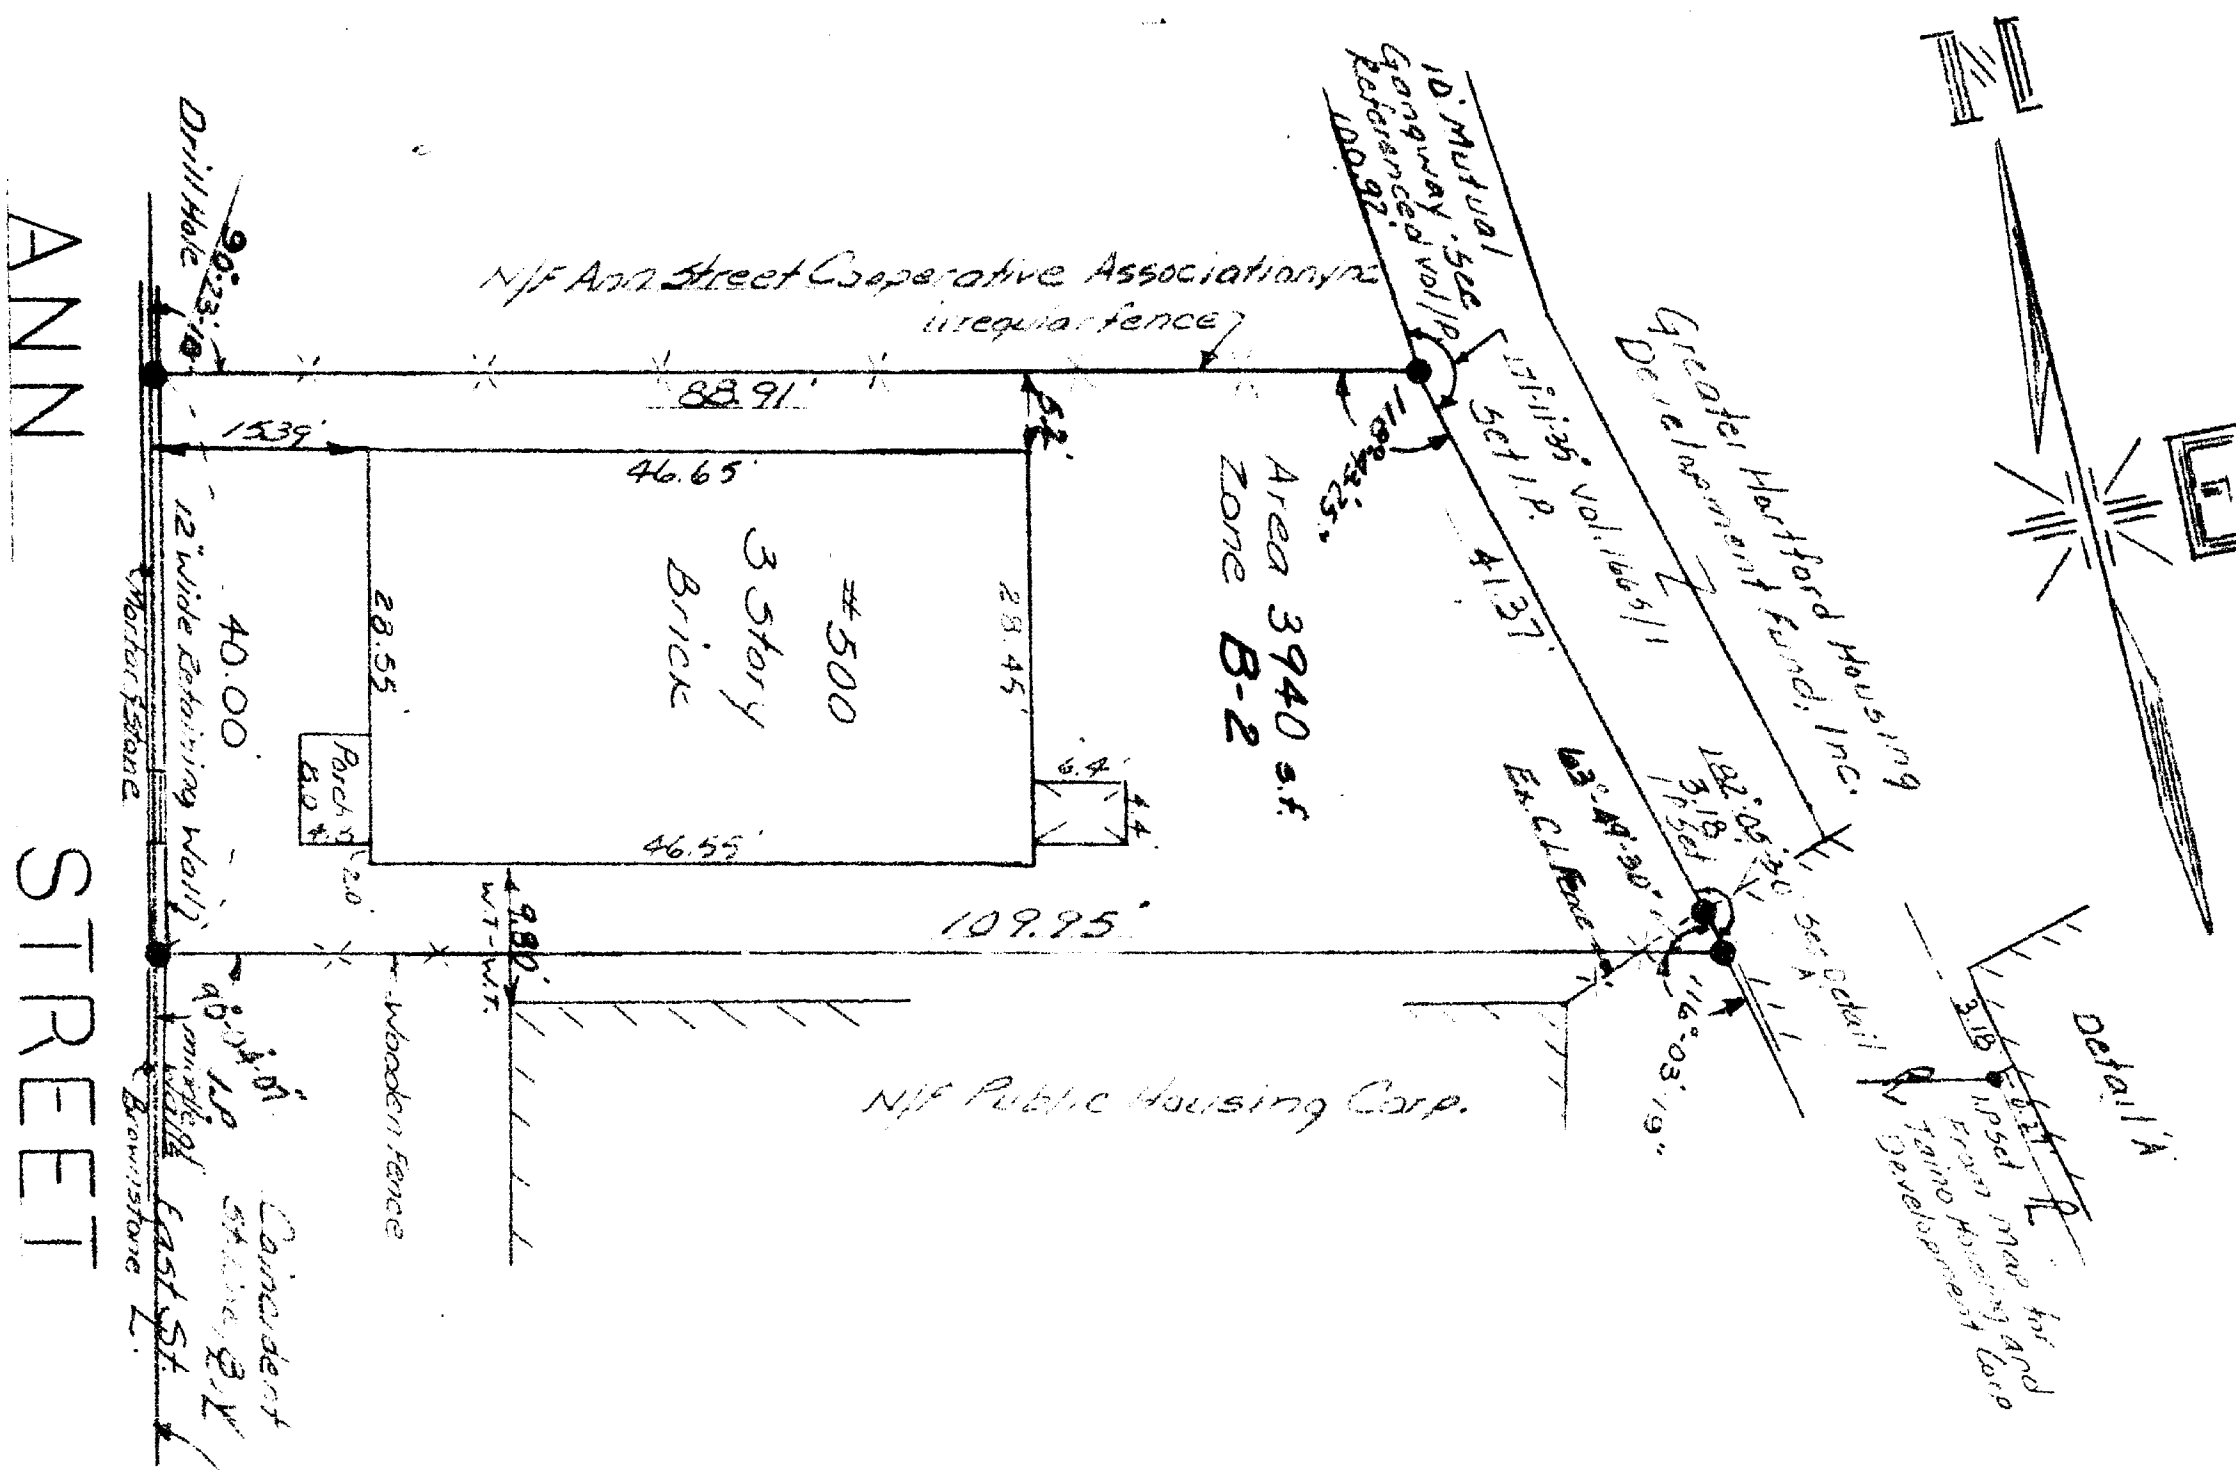

"Property of the Bidwell Hardware Co. and the Bidwell Realty Company, Main and Ann Streets, Seale 1"=10' May 1955, Rev. May 1968, Peterson

CERTIFIED SUBSTANTIALLY CORRECT

[Signature]
SURVEYOR

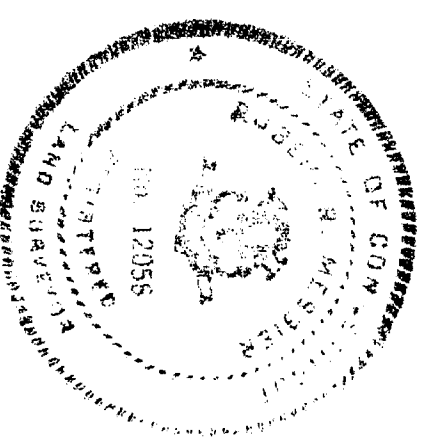

81-41

The portion of Main Street shown on this plan is an established public street of the City of Hartford

Dec. 1921

George F. Maynor
City Engineer

George E. Johnson
City Engineer

100

69

6611

