

1200-1

GREATER HARTFORD FLOOD COMMISSION

MAP SHOWING
TEMPORARY CONSTRUCTION EASEMENT AND
RIGHT OF ACCESS ACQUIRED FROM
CAPITOL AND BROAD COMPANY (PARCEL 5)


FOR PROPOSED CONDUIT EXTENSION

THE HARTFORD COURANT COMPANY
HARTFORD
SCALE: 1"=40'

FEBRUARY 1976
Revised Sept. 1981

NO. 458041
PAGE

JAN 9 2 12 PM '82
TOWN & CITY CLERK
HARTFORD

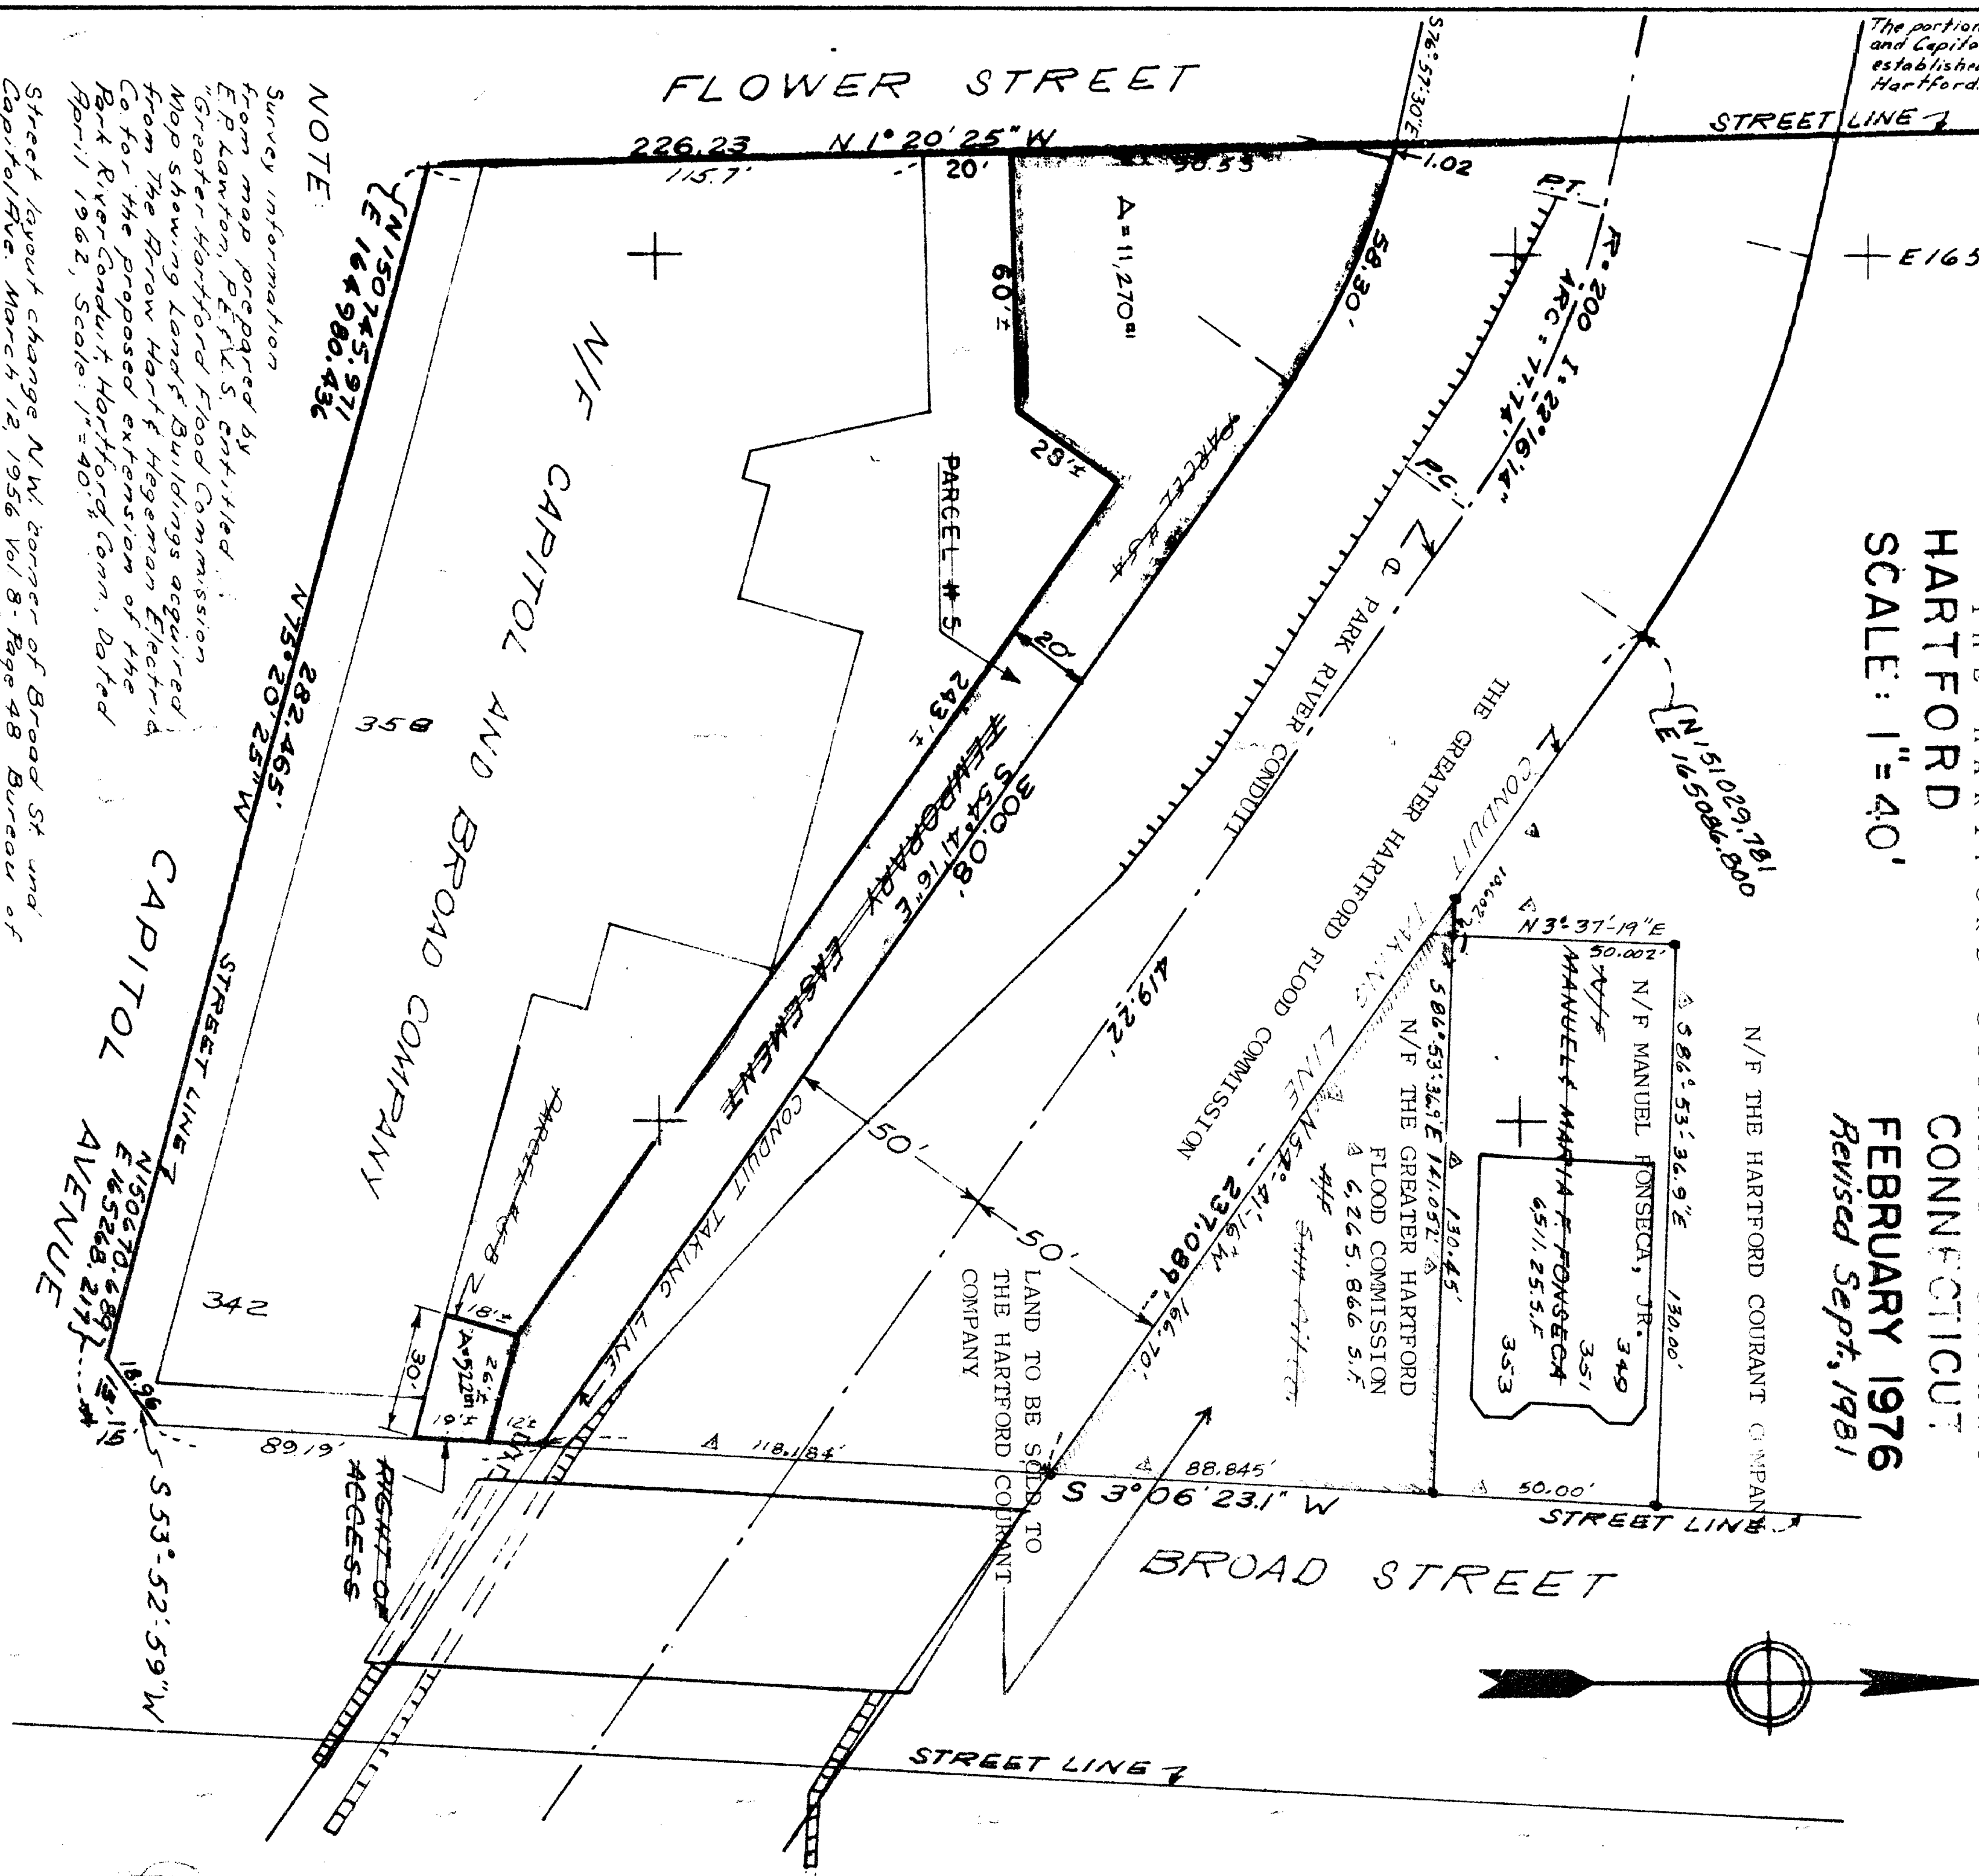

NOTE


CAPITOL AND BROAD COMPANY


RIGHT OF ACCESS


Certification for base map


I HEREBY CERTIFY THAT THIS MAP CONFORMS TO CLASS "D" OF THE CODE OF CONNECTICUT TECHNICAL COUNCIL, INCORPORATED AND IS SUBSTANTIALLY CORRECT.
P. E. & L. S. CONN. 05620
DEPT. OF PUBLIC WORKS BUREAU OF ENGINEERING SERVICES

A. Additions made by E. Donahue 9/2/81

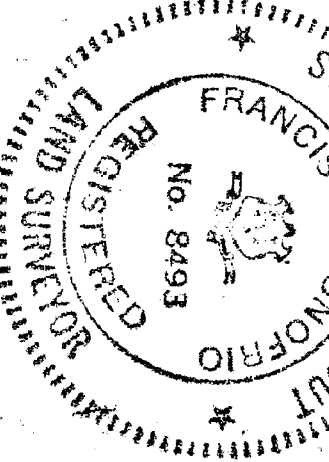

Certified substantially correct
James V. Donahue 9/2/81

Revised to 1-4-82-TMB

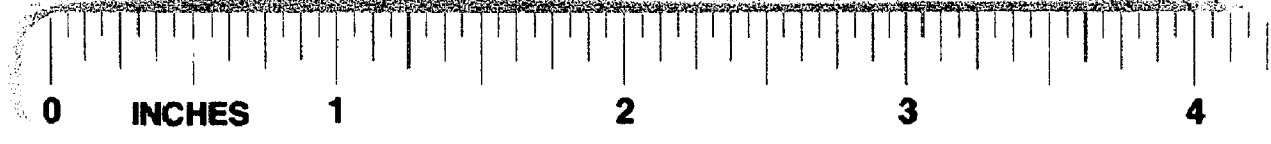

1200
EASI FILE COMP. IRVINE, CA
878 34