PLOT PLAN

PROPERTY OF

JOHN L. & BERTHA WARD

471-473 EDGEWOOD STREET

HARTFORD, CONN.

SCALE: 1"=20' DATE: OCT. 1981

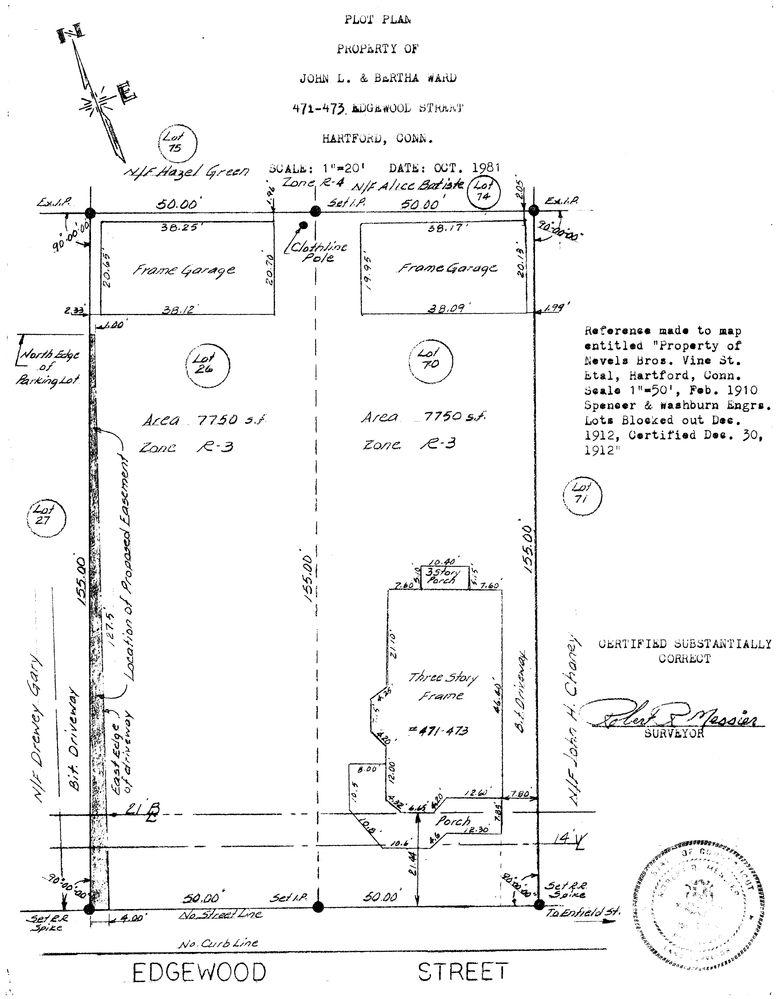

Reference made to map entitled "Property of Nevels Bros. Vine St. Etal, Hartford, Conn. Scale 1"=50', Feb. 1910 Spencer & Washburn Engrs. Lots Blocked out Dec. 1912, Certified Dec. 30, 1912"

CERTIFIED SUBSTANTIALLY CORRECT

Robert E. Messier
SURVEYOR

The portion of Edgewood St. shown on this plan is an established public street of the City of Hartford.

March 1982

George E. Wagner
City Engineer

RECEIVED BY

VOL. 460 PAGE 338

1201

#69

EASI FILE CORP. IRVINE CA

1201

1201-1