



EASI FILE CORP. IRVINE, CA	EPM 34
1202	

I hereby certify to:
 Connecticut Development Authority and
 The Colonial Bank and The U. S. Life
 Title Insurance Company
 that this survey was actually made upon the
 ground October 24, 1981 and that it and the
 bounds and measurements shown hereon are
 correct within the standards of Class 1-2
 as defined in the Code of Recommended Prac-
 tice for Standards of Accuracy of Surveys
 and Maps adopted by the Connecticut Assoc-
 iation of Land Surveyors, Inc., and that
 unless otherwise shown, title lines and
 lines of actual possession are the same,
 buildings are located as shown and do not
 encroach over or upon street, title or
 building lines, there are no violations of
 zoning regulations with reference to the
 location of said buildings, and there are
 no easements or encroachments affecting
 this property apparent from a careful in-
 spection of the same.

Francis T. D'Onofrio
 Francis T. D'Onofrio
 Conn. L.S. 8493


Revised 5/10/82 to show site improvements
Francis T. D'Onofrio L.S. 8493

The portion of Elliott Street East
 shown on this plan is an established
 public street of the City of Hartford.
George E. Higgins
 May 1982 City Engineer

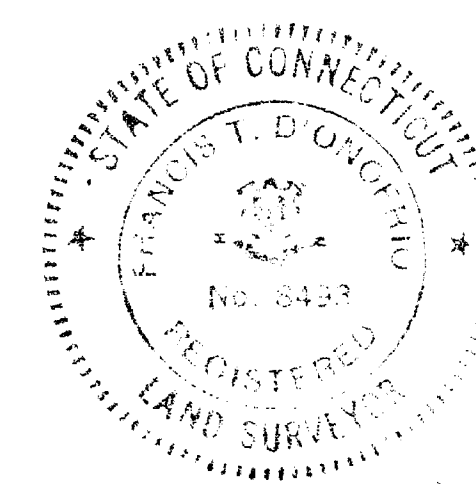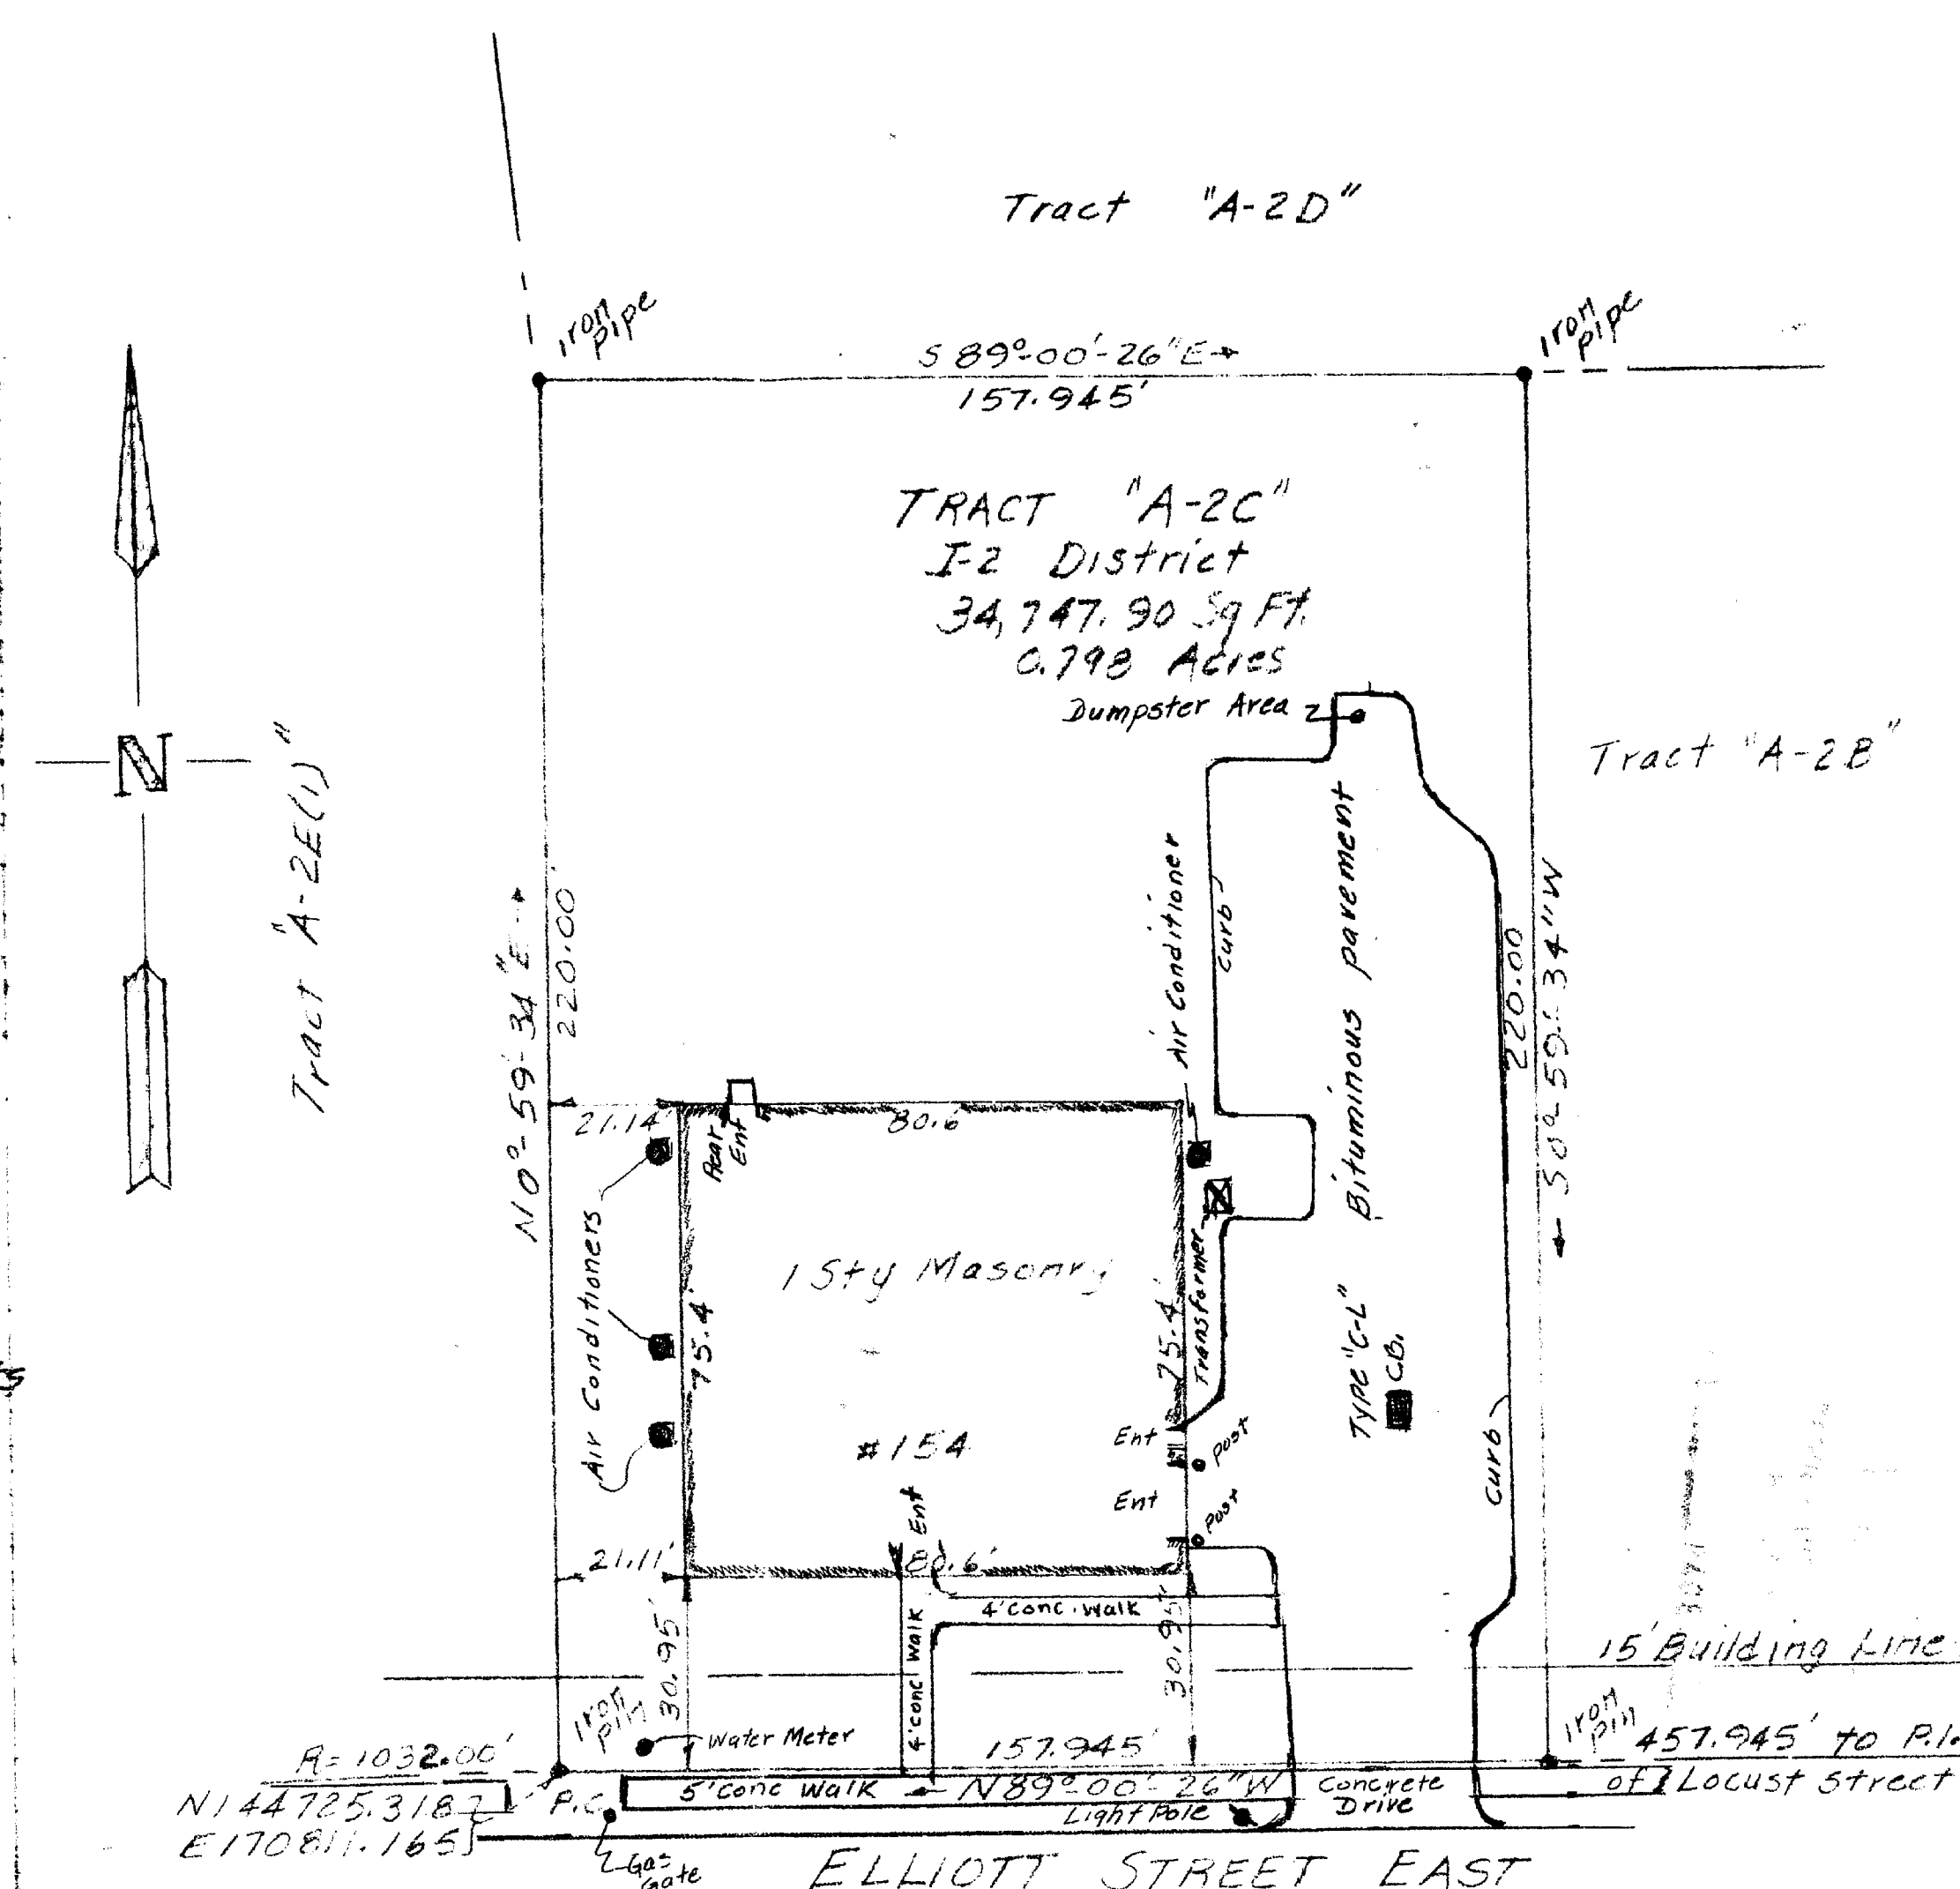

Notes:
 (1) Bearings and coordinates
 based on M.D.C. Datum.
 (2) Reference Map:
 "Colt Park South Project"
 Street Layout
 Scale: 1"=100' Dec. 1974
 Rev. 2/21/80
 Dayback # 010489"

MORTGAGE SURVEY
 Property of
 EDWARD LORENCE
 in
 Hartford, Connecticut
 Scale: 1"=40' July, 1981

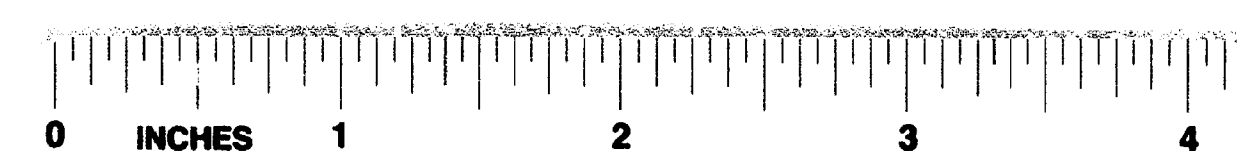

84