


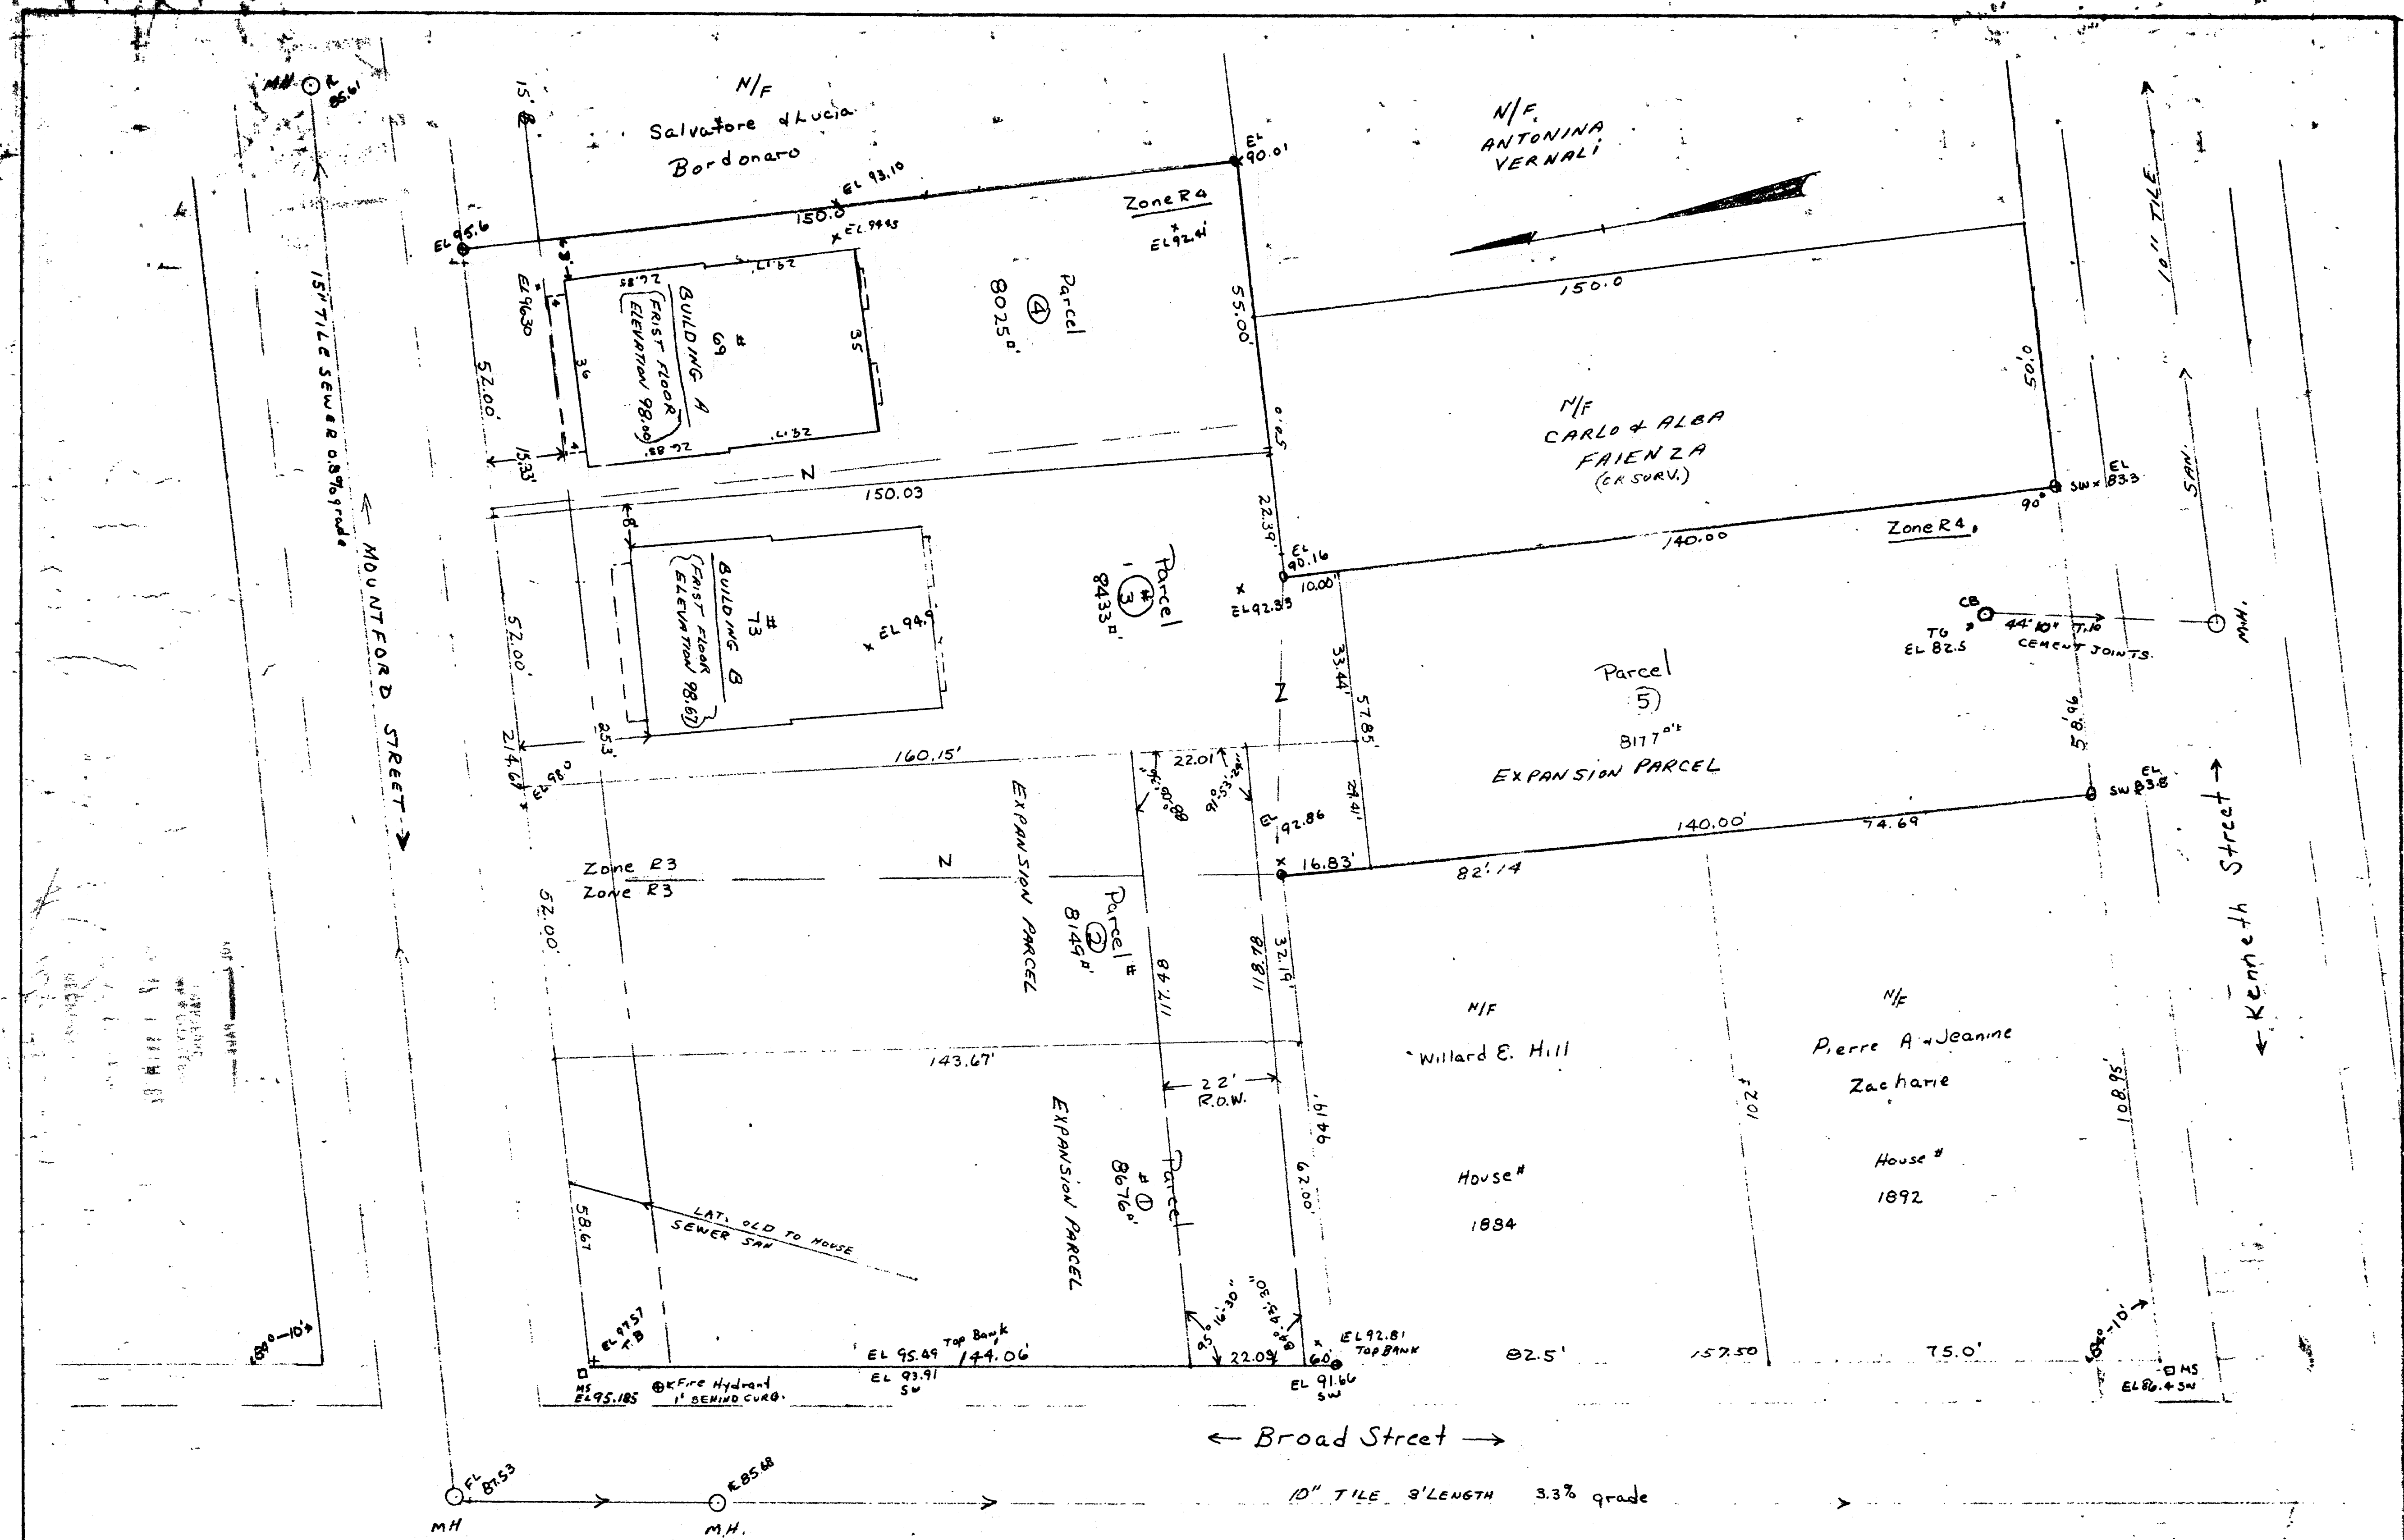


The portions of Broad St., Mountford St. and Kenneth St. shown on this plan are established public streets of the City of Hartford.
May 1982
City Engineer

PROPERTY OF
Plymouth Realty Inc. &
Filadelfo Ossino Trustees
BARRY SQUARE Condominium - AN EXPANDABLE
CONDOMINIUM, @
BROAD, MOUNTFORD & KENNETH STREET,
TOWN OF Hartford Connecticut

I HEREBY CERTIFY
THAT THIS MAP & SURVEY WERE PREPARED IN
ACCORDANCE WITH THE STANDARDS OF CLASS A-2
SURVEY AS DEFINED IN THE CODE OF PRACTICE FOR
STANDARDS AND ACCURACY OF SURVEY & MAPS
ADOPTED DECEMBER 10, 1975 AS AMENDED BY
THE CONN. ASSOCIATION OF LAND SURVEYORS,
INC.

ALCA SURVEY ASSOCIATES
CARL H. JAEGER L.S. 7763
ALCA SURVEY ASSOCIATES
WETHERSFIELD, CONN.
SCALE: 1" = 20' SHEET
DATE: 8/27/01 1 OF 1

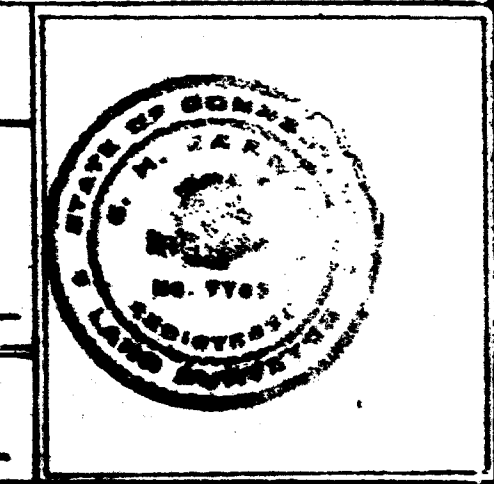

#83



R.O.W. ADDED 5-1-82
1204 #83
PLAN SIZE 18" x 24"