


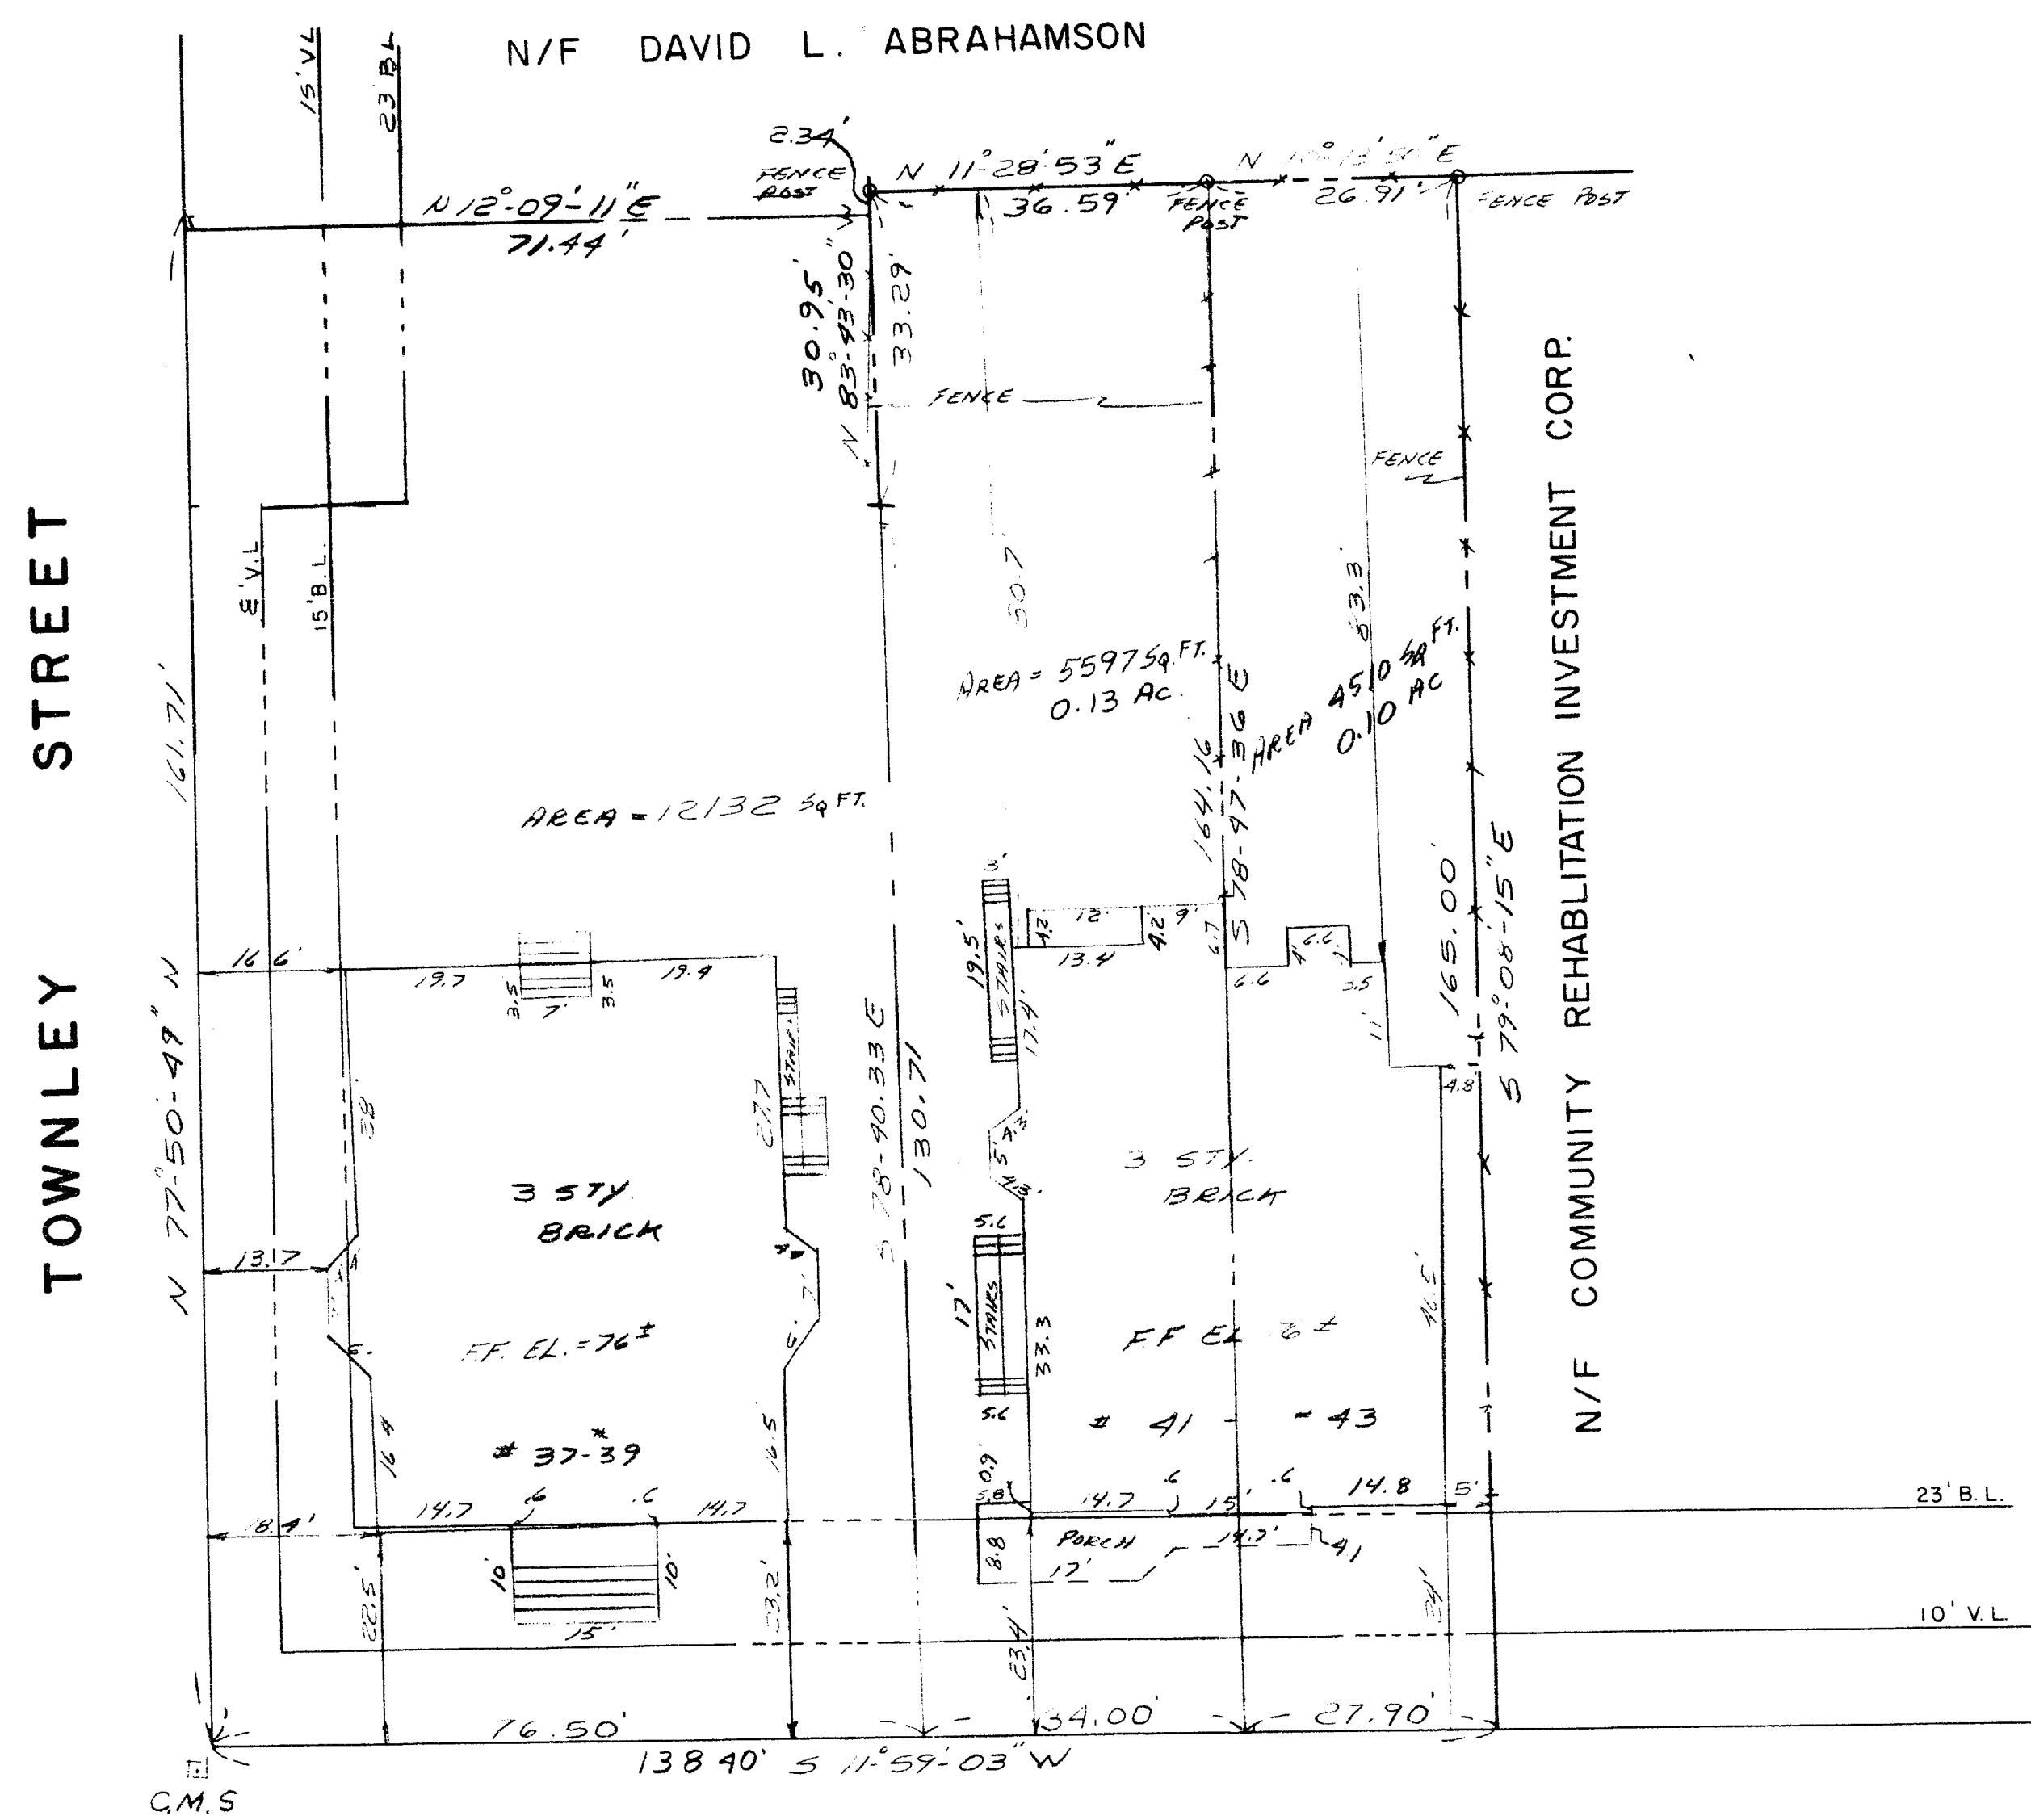

NOTE:
 ALL OFFSET DISTANCES ARE
 PERPENDICULAR TO THE
 STREET LINES OR PROPERTY
 LINES
 V.C. DATUM USED
 ZONE RO-2

RECEIVED
 MAY 29 4 14 PM '82
 TOWN & CITY CLERK
 HARTFORD
 VOL. PAGE

The portions of Willard St. and
 Townley St. shown on this plan are
 established public streets of the
 City of Hartford.
 June 1982 *George E. Flynn*
 City Engineer

WILLARD STREET

I HEREBY CERTIFY THAT THIS MAP AND SURVEY
 WERE PREPARED IN ACCORDANCE WITH THE
 STANDARDS OF A CLASS A-2 SURVEY AS DEFINED
 IN THE CODE OF PRACTICE FOR STANDARDS OF
 ACCURACY OF SURVEYS AND MAPS, ADOPTED
 DECEMBER 10, 1975 AS AMENDED BY THE
 CONNECTICUT ASSOCIATION OF LAND SURVEYORS INC.

Peter D. Flynn

12/10/81
 5/10/81
 4/10/81
 9/17/80
 REV. 4/18/80

PROPERTY MAP OF			
WILLARD PLACE - AN			
EXPANDABLE CONDOMINIUM			
37,39,41 & 43 WILLARD ST.			
HARTFORD CONNECTICUT			
date: 11/9/79	drawn by: CC	job no 79171	
scale: 1"=20'	checked by: PDF	sheet no 1 of 1	
F A HESKETH & ASSOCIATES •ENGINEERS 101 Millbrook Common Bloomfield, CT 06002 •SURVEYORS			

0 INCHES 1 2 3 4 1206