
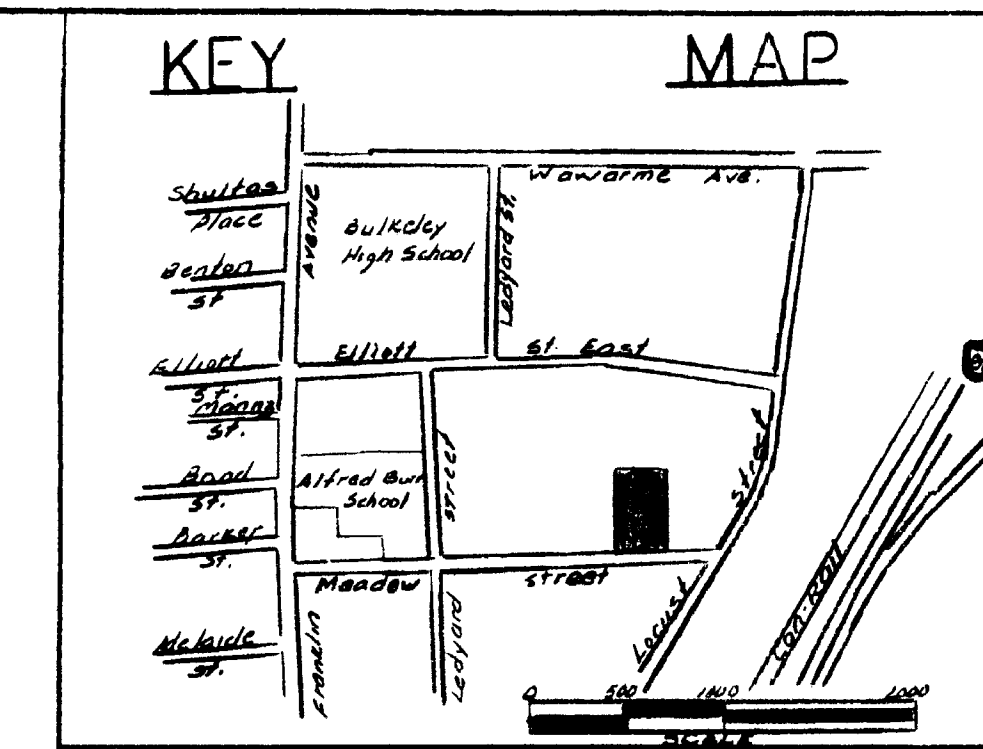


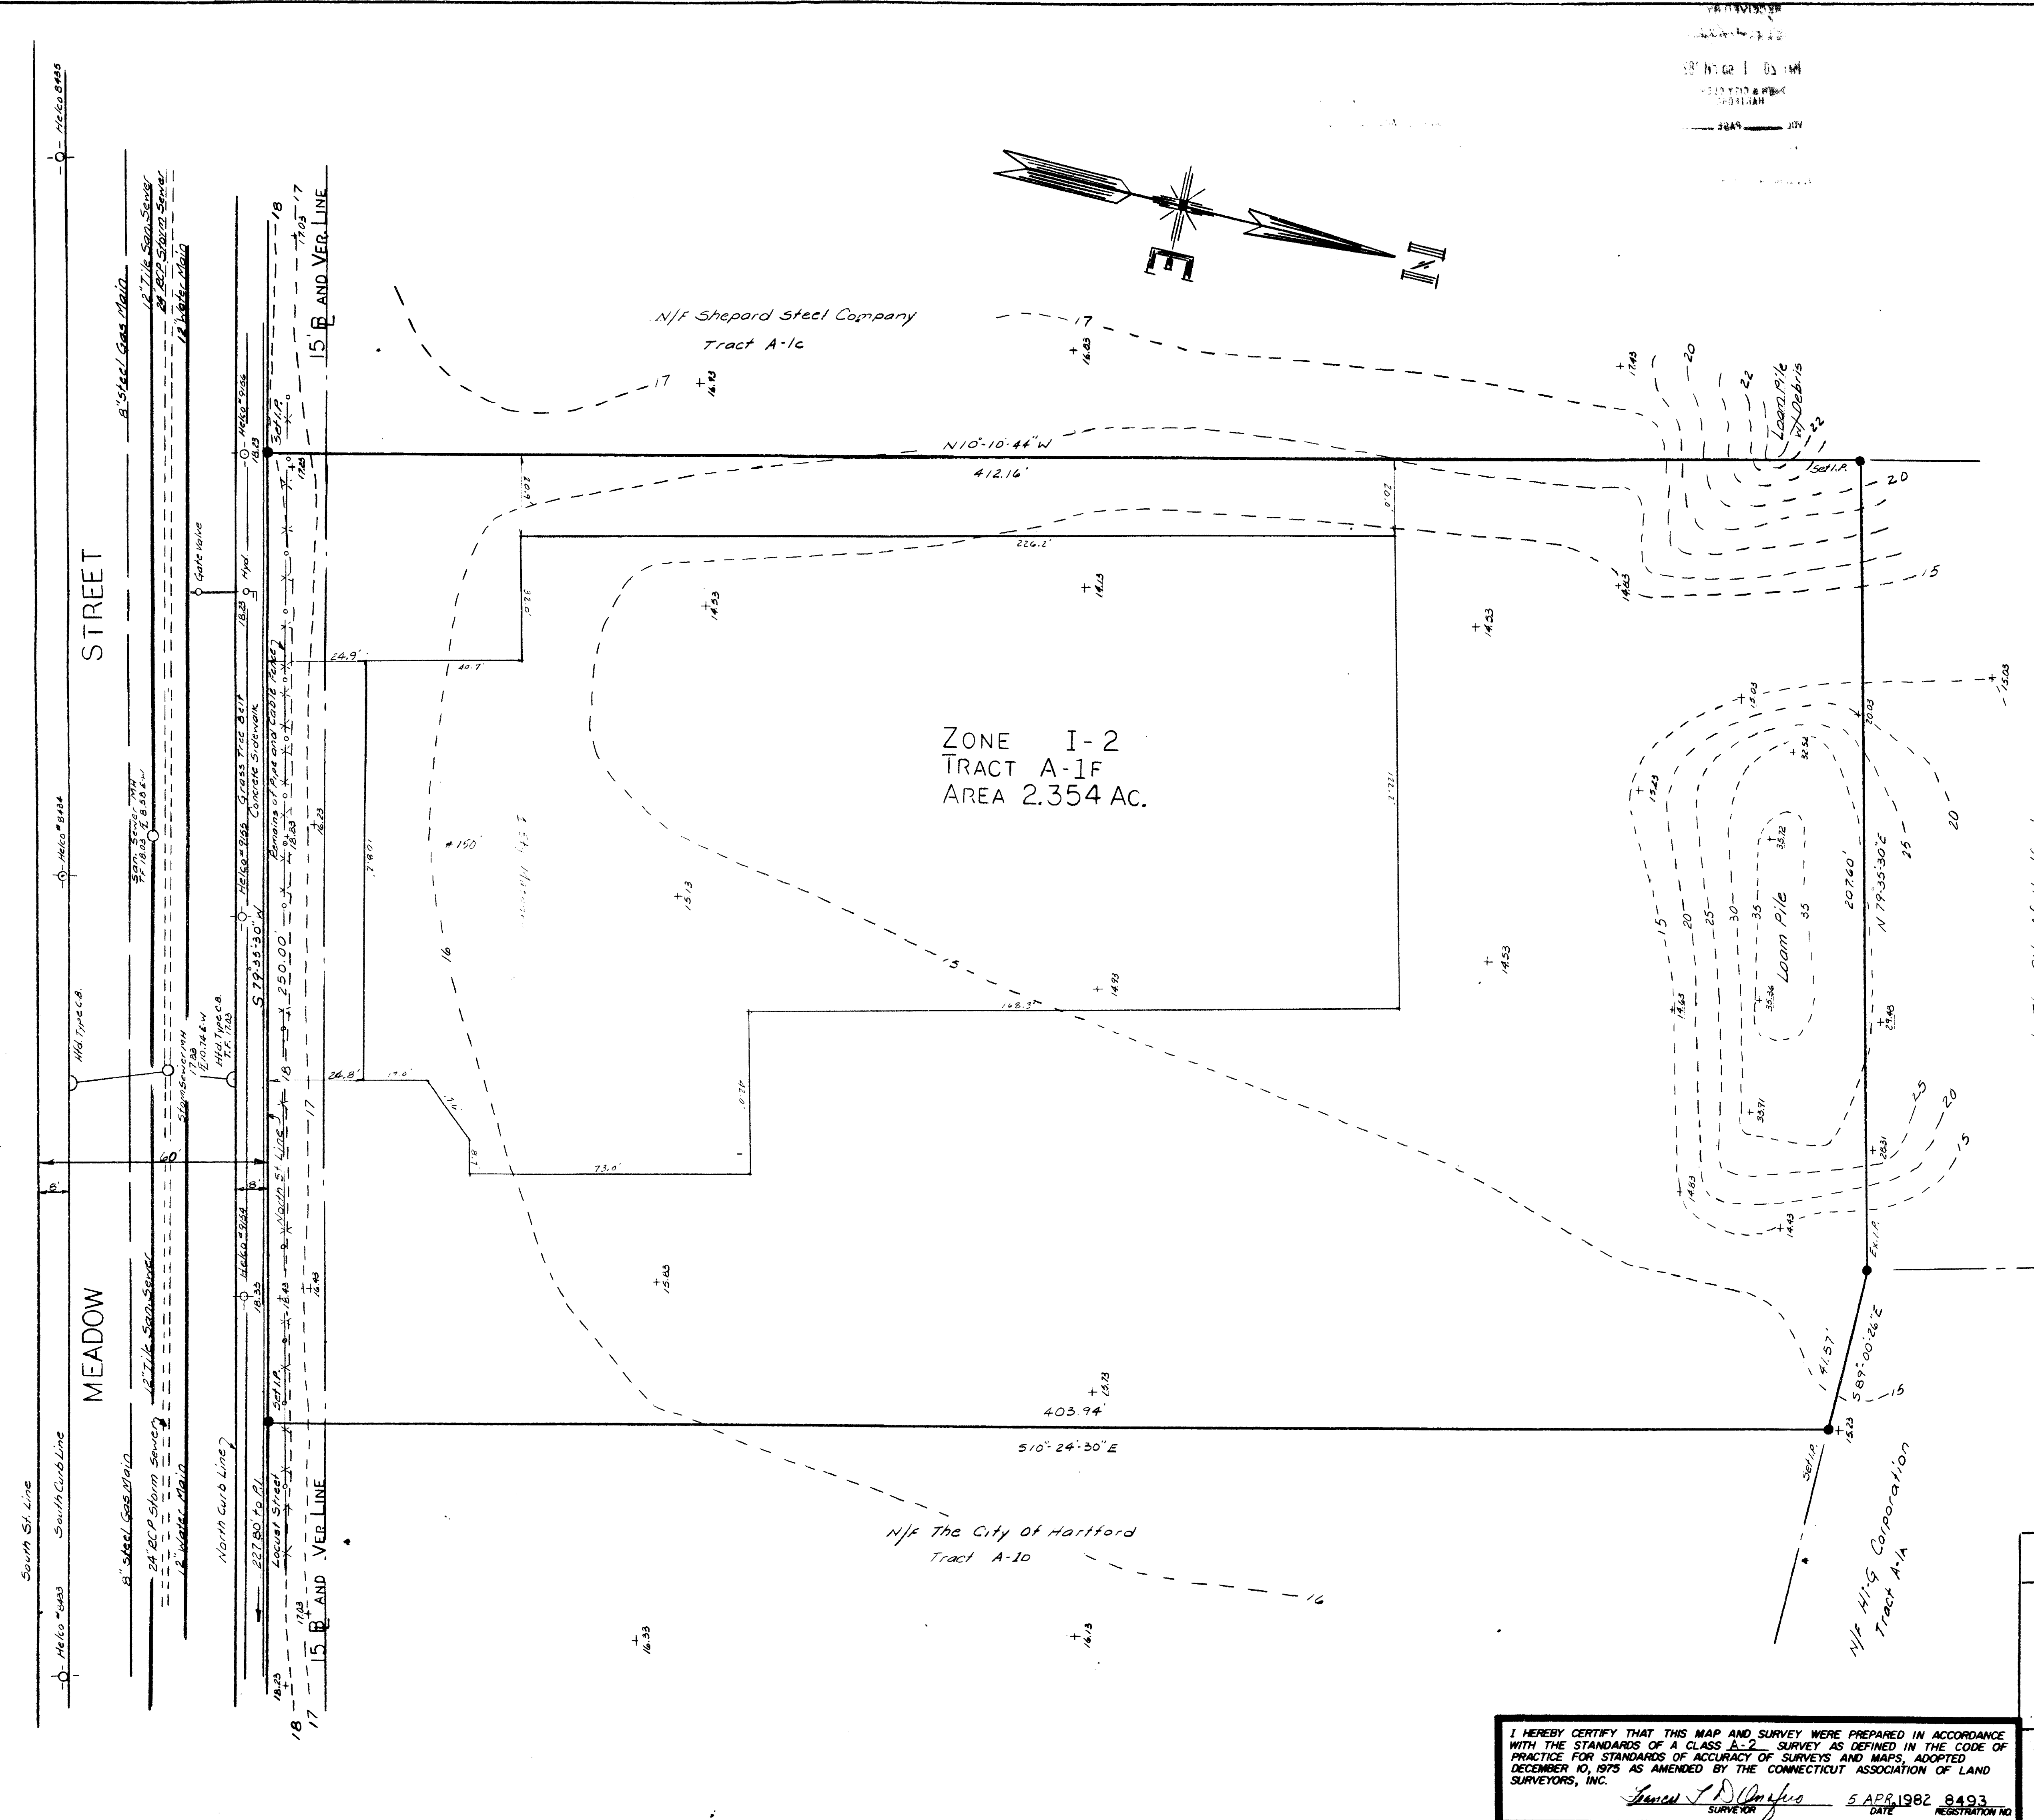

The portion of Meadow St. shown on this plan is an established public street of the City of Hartford.
George T. Doreffio
City Engineer
May 1982

NOTES

Reference made to plan entitled "Colt Park South Project, Property to be Conveyed to Hartford Wireworks Co. On Meadow Street in Hartford, Connecticut, Scale 1"=40', July, 1980, Daybook No. 010714, Francis T. Doreffio, L.S."

All locations, depths, etc., of the utilities shown shall be field verified.

Elevations based on MDC Datum.

BM 18.19 S.E. lug on Hyd. in front of Shepard Steel Company

14.76 Spot Elevations

-- 20'-- Existing Contours

Lot area: 102,531.13 sq. ft.

Bldg area: 34,905.37 sq. ft.

Fldy occupies: 34.0% of Lot

Connecticut Development Authority
Connecticut Attorney's Title
Guaranty Fund, Inc.

A-2

1/30/82

I HEREBY CERTIFY THAT THIS MAP AND SURVEY WERE PREPARED IN ACCORDANCE WITH THE STANDARDS OF A CLASS A-2 SURVEY AS DEFINED IN THE CODE OF PRACTICE FOR STANDARDS OF ACCURACY OF SURVEYS AND MAPS, ADOPTED DECEMBER 10, 1975 AS AMENDED BY THE CONNECTICUT ASSOCIATION OF LAND SURVEYORS, INC.

Francis T. Doreffio
SURVEYOR
DATE 5 APR 1982
REGISTRATION NO. 8493

SURVEY FOR BEAUTY ENTERPRISES TRACT A-1F MEADOW STREET HARTFORD, CONN.	DRAWN RRM
	CHECKED FTD
	DATE JAN 1981
	SCALE 1"=20'
	SHEET 1 OF 1
REVISIONS: A. Addition of Building 1/30/82	

1208

