


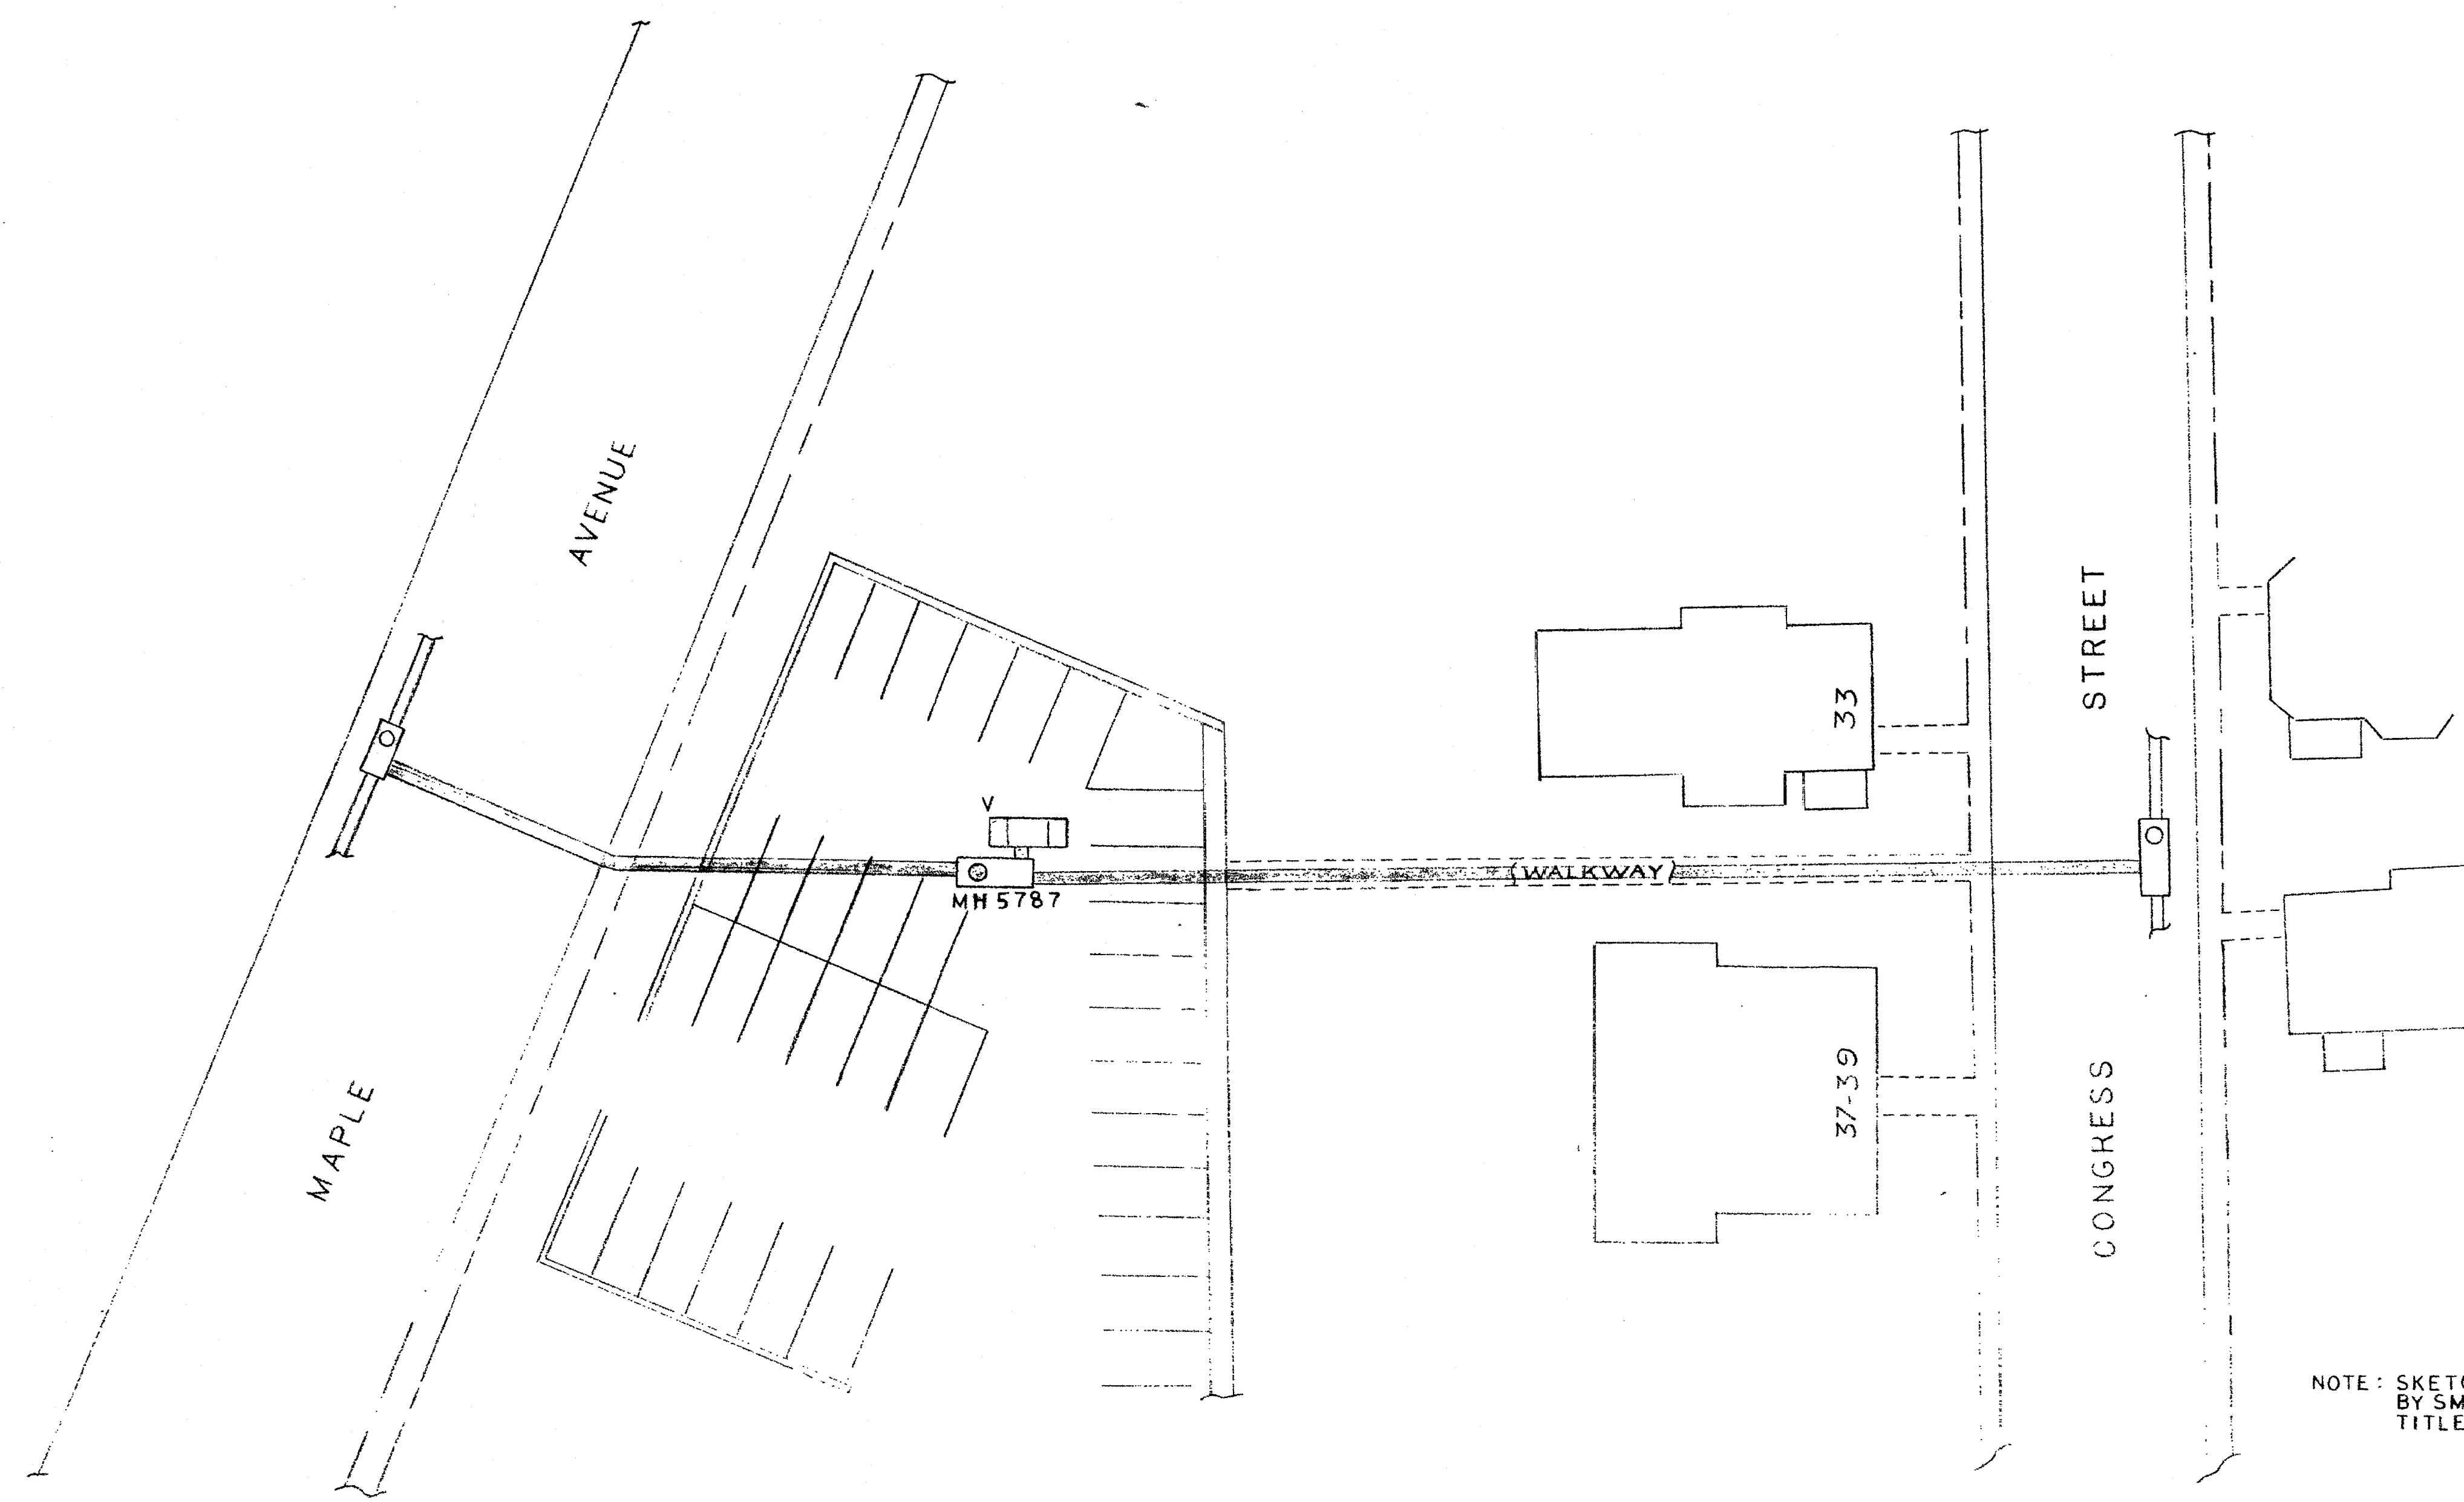

NOTE: SKETCH COMPILED FROM A MAP DRAWN BY SMITH EDWARDS ARCHITECTS 1/18/78 TITLED-CONGRESS STREET PLAN.

The portions of Maple Avenue and Congress Street shown on this plan are established public streets of the City of Hartford.
July 1982
Serge E. Higgins
City Engineer

LEGEND


-  6'2" X 14' X 8'10" MANHOLE
-  7'X14'X8' VAULT FOR TRANSFORMER
-  8-DUCT CONDUIT BANK

THE SUPERSEDED STREET EMPLOYEE
NOTES THIS MAP TO BE
"LEGALLY CORRECT" AND IN
RESPONSE TO CLASS "D" OF CHARTER
OF HARTFORD, CONNECTICUT, INC.
THE HARTFORD ELECTRIC LIGHT COMPANY
BY *Donald F. Poirer*

NO.	DATE	DESCRIPTION	BY

THE HARTFORD ELECTRIC LIGHT CO.
SKETCH TO SHOW LOCATION-MANHOLE, TRANSFORMER VAULT AND DUCT LINE OF THE HARTFORD ELECTRIC LIGHT CO. ON THE PROPERTY OF THE CITY OF HARTFORD, HARTFORD, CONNECTICUT.

DRAWN BY D.F.P. APPROVED BY *[Signature]*
SCALE 1"=20'
DATE 5-29-79 NO. 36280604

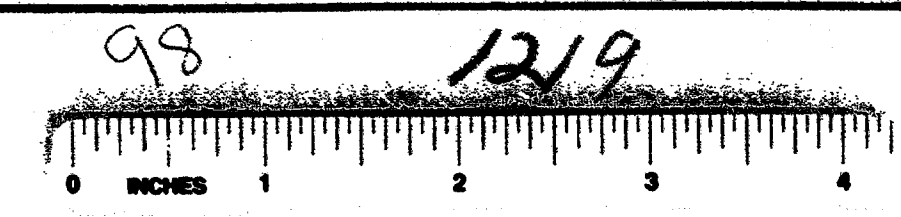

1219
FILED IN THE CITY OF HARTFORD
JUL 25 1982