

GARDEN STREET

N/F SWAG, INC.

N/F MELVIE LANIEZ

N/F WILLIAM EDWARDS

BROOK STREET

LIBERTY STREET

N/F LILLIAN L. HOLTMAN ET AL

N/F ARTHUR C. PHELPS

N/F ALEXANDER MORRIS ET AL

N/F HAROLD STICKLER

N/F ANGEL VASQUES




The portions of Brook Street, Garden Street and Liberty Street shown on this plan are established public streets of the City of Hartford.

August 1982

George P. Apper  
City Engineer

FOUNDATIONS LOCATED AS SHOWN  
NO ZONING VIOLATIONS

|   |          |
|---|----------|
| I HEREBY CERTIFY THAT THIS MAP COMPLIES WITH CLASS "O" CLASSIFICATION AS DEFINED BY CONNECTICUT ASSOCIATION OF LAND SURVEYORS, INC. |          |
| W. M. Alford, Inc.   |          |
| ALFORD ASSOCIATES, INC.   |          |
| CIVIL ENGINEERS<br>WINDSOR, CONNECTICUT<br>WILSON W. ALFORD SR., P.E. & L.S.<br>WILSON W. ALFORD, JR., P.E. & L.S.                  |          |
| DATE   | REVISION |
| SCALE: 1 IN. = 20 FT. DATE: AUG. 5, 1982                                                                                            |          |
| PROPERTY OF   |          |
| DUTIL REALTY CORPORATION   |          |
| LIBERTY STREET HARTFORD, CONN.   |          |

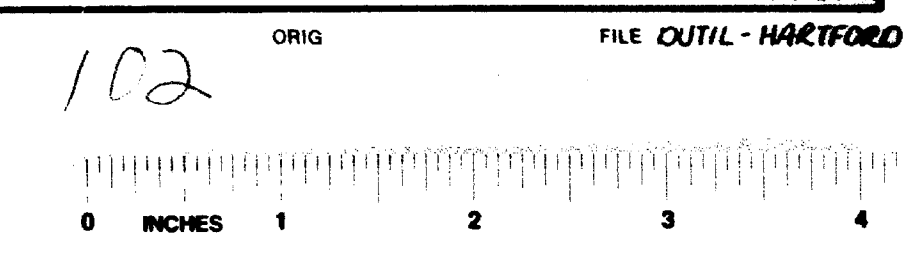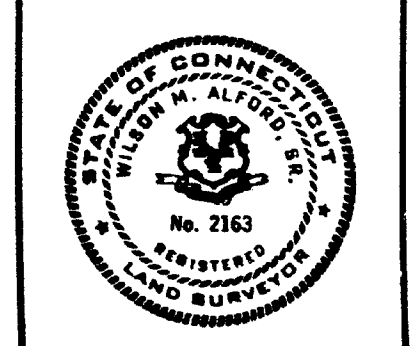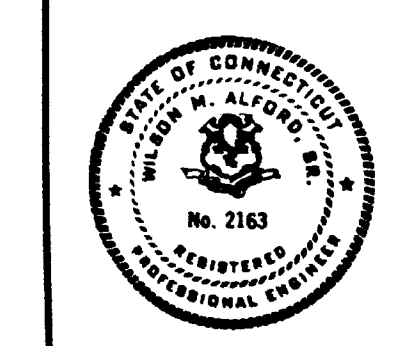

FILE NO. 102