


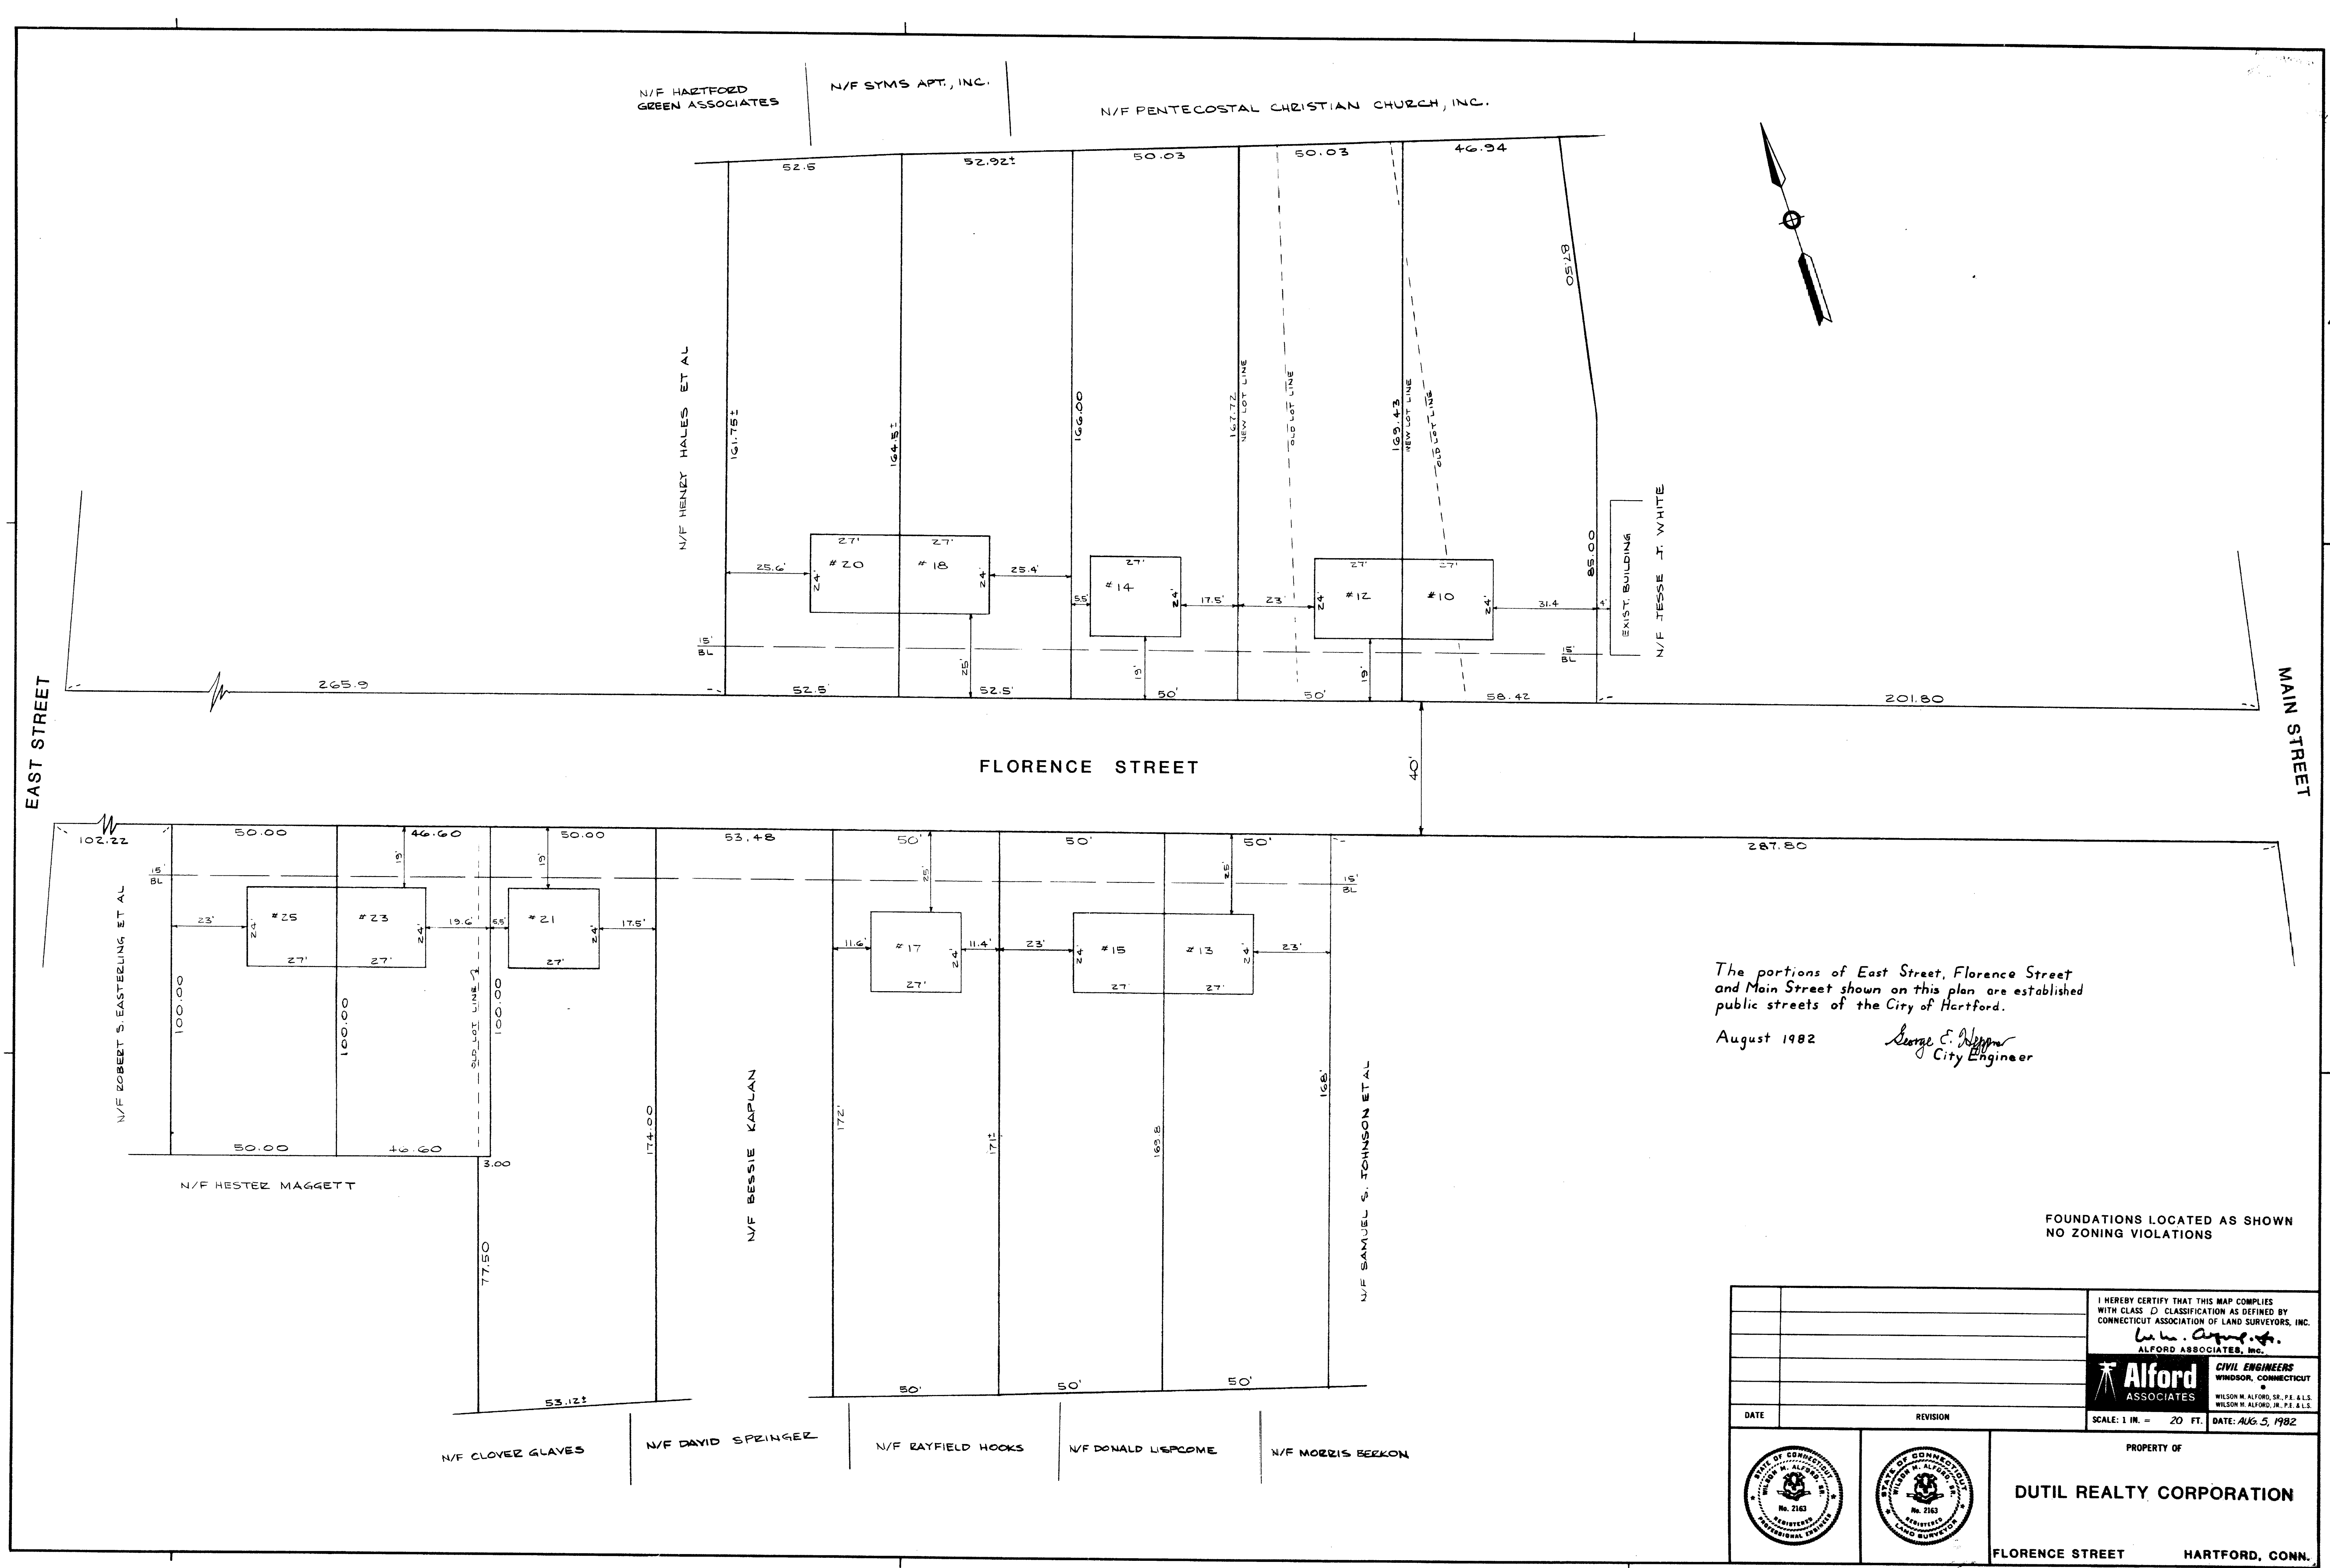

The portions of East Street, Florence Street and Main Street shown on this plan, are established public streets of the City of Hartford.
August 1982
George E. Nye
City Engineer

FOUNDATIONS LOCATED AS SHOWN
NO ZONING VIOLATIONS

DATE		REVISION		I HEREBY CERTIFY THAT THIS MAP COMPLIES WITH CLASS "D" CLASSIFICATION AS DEFINED BY CONNECTICUT ASSOCIATION OF LAND SURVEYORS, INC. <i>Wm. Alford, Jr.</i> ALFORD ASSOCIATES, INC.	
DATE		REVISION		CIVIL ENGINEERS WINDSOR, CONNECTICUT WILSON M. ALFORD, SR., P.E., A.L.S. WILSON M. ALFORD, JR., P.E., A.L.S. SCALE: 1 IN. = 20 FT. DATE: AUG 5, 1982	
PROPERTY OF DUTIL REALTY CORPORATION FLORENCE STREET HARTFORD, CONN.					

1223

