


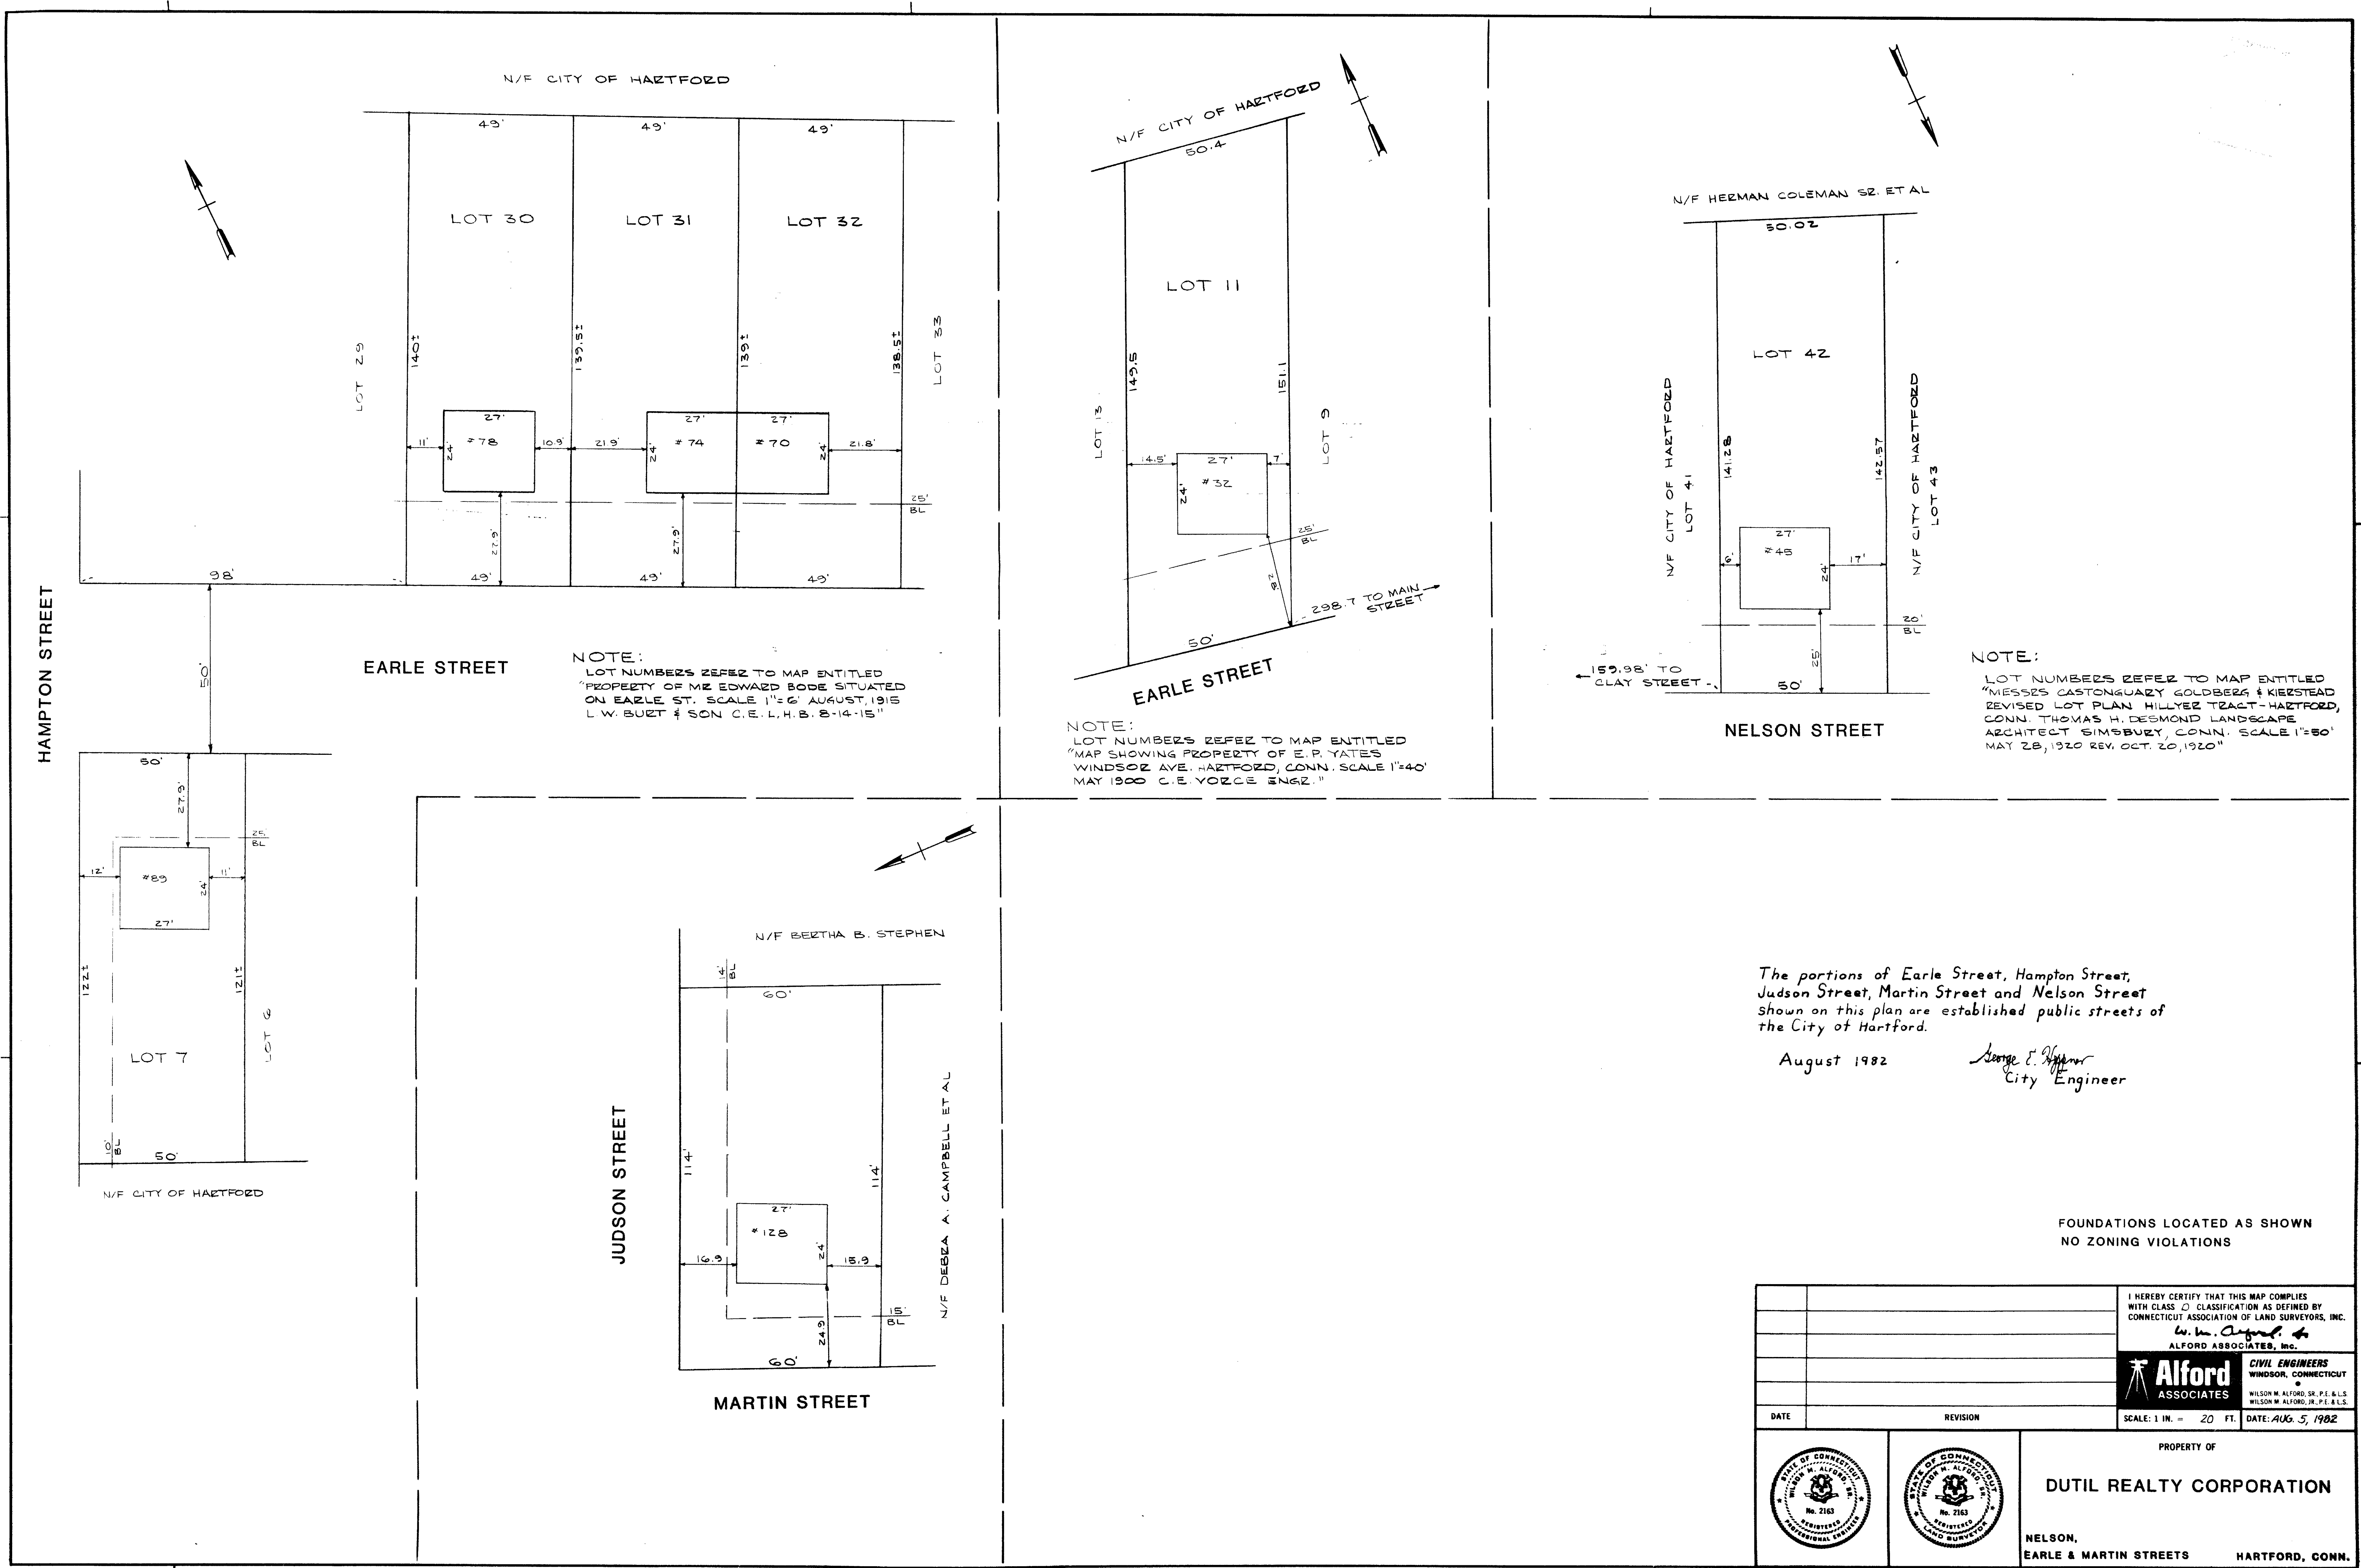

NOTE:
LOT NUMBERS REFER TO MAP ENTITLED
"PROPERTY OF MR EDWARD BODE, SITUATED
ON EARLE ST. SCALE 1"=6' AUGUST, 1915
L. W. BUET & SON C.E., L.H.B. 8-14-15"


NOTE:
LOT NUMBERS REFER TO MAP ENTITLED
"MAP SHOWING PROPERTY OF E. P. YATES
WINDSOR AVE. HARTFORD, CONN. SCALE 1"=40'
MAY 1900 C.E. VOZCE ENG'G."

NOTE:
LOT NUMBERS REFER TO MAP ENTITLED
"MESSES CASTONGUARY GOLDBERG & KIERSTAD
REVISED LOT PLAN HILLIER TRACT - HARTFORD,
CONN. THOMAS H. DESMOND LANDSCAPE
ARCHITECT SIMSBURY, CONN. SCALE 1"=80'
MAY 28, 1920 REV. OCT. 20, 1920"

The portions of Earle Street, Hampton Street,
Judson Street, Martin Street and Nelson Street
shown on this plan are established public streets of
the City of Hartford.
August 1982
George E. Hoffman
City Engineer

FOUNDATIONS LOCATED AS SHOWN
NO ZONING VIOLATIONS

I HEREBY CERTIFY THAT THIS MAP COMPLIES WITH CLASS "C" CLASSIFICATION AS DEFINED BY CONNECTICUT ASSOCIATION OF LAND SURVEYORS, INC. <i>Wm. Alfred</i> ALFORD ASSOCIATES, INC.	
Alford ASSOCIATES CIVIL ENGINEERS WINDSOR, CONNECTICUT WILSON M. ALFORD, JR., P.E. & L.S. WILSON M. ALFORD, JR., P.E. & L.S.	
DATE	REVISION
SCALE: 1 IN. = 20 FT. DATE: AUG. 5, 1982	
PROPERTY OF DUTIL REALTY CORPORATION NELSON, EARLE & MARTIN STREETS HARTFORD, CONN.	

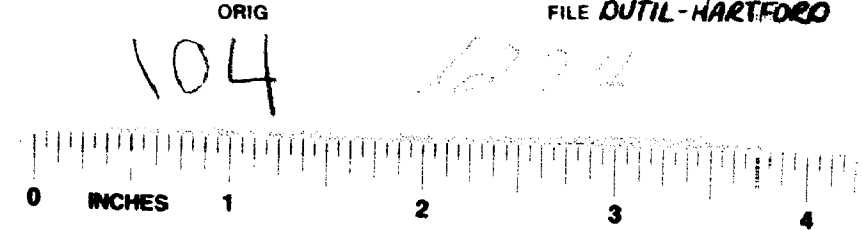

1224