


1232

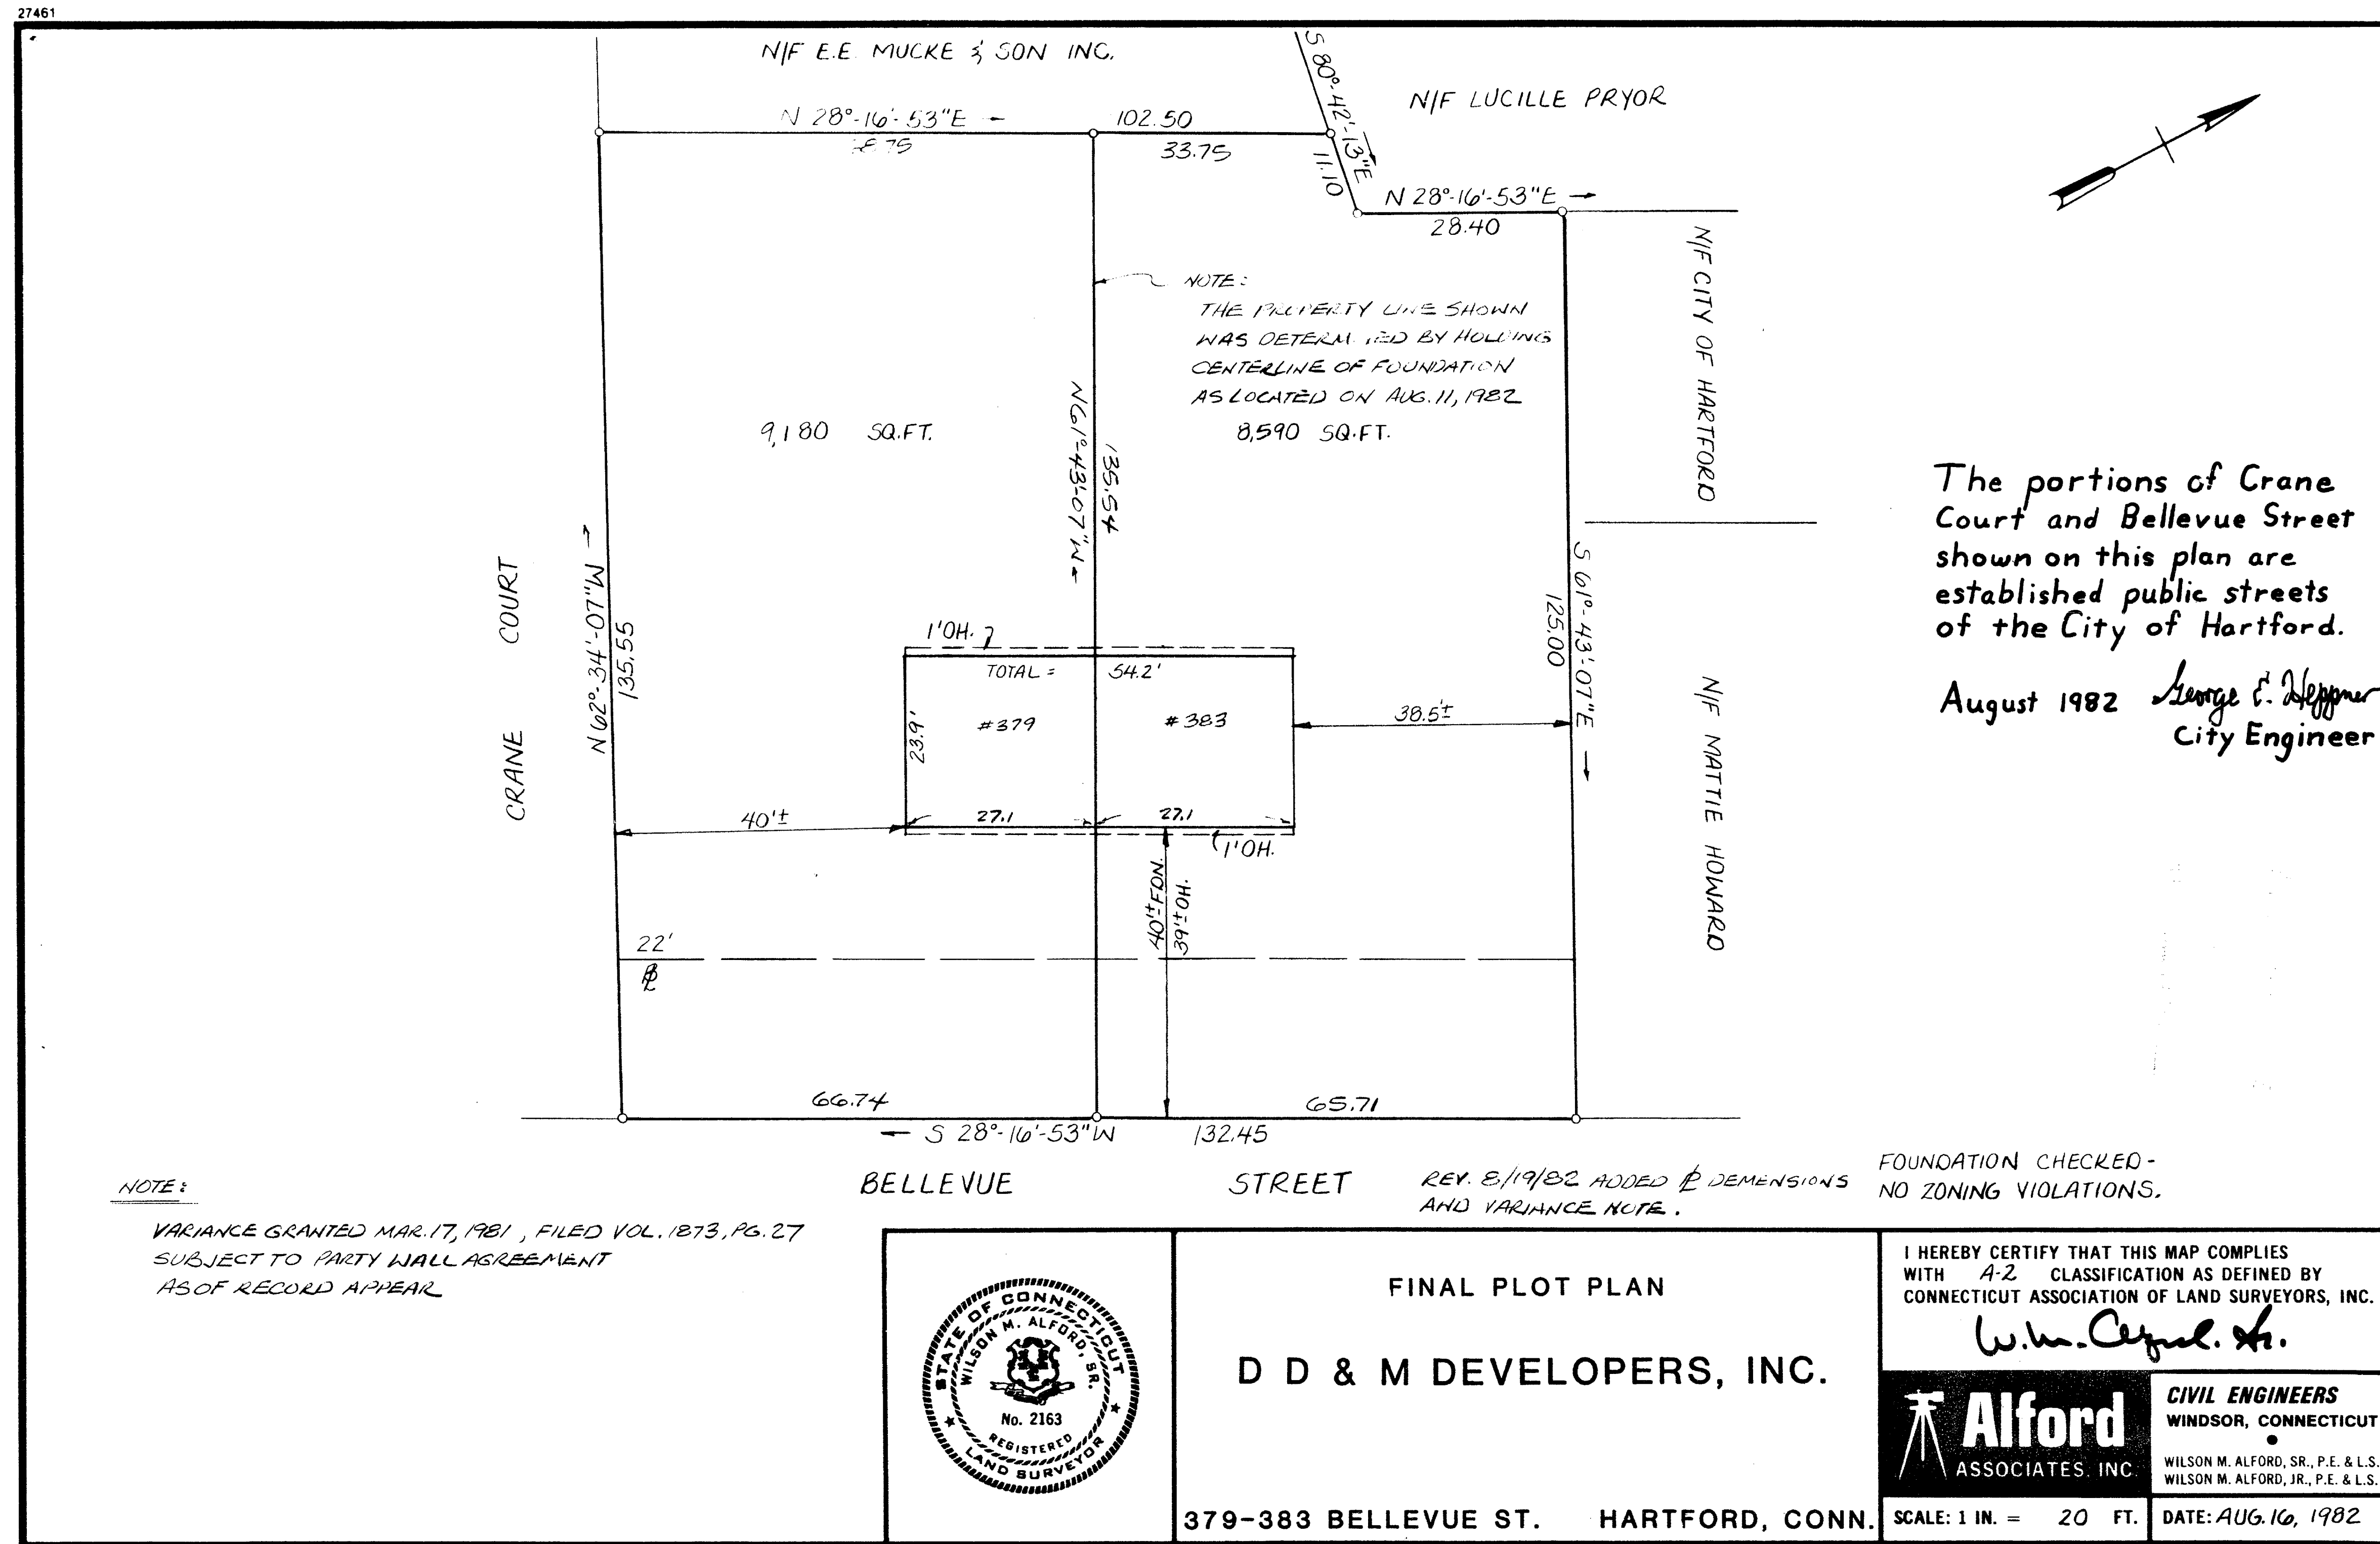

The portions of Crane Court and Bellevue Street shown on this plan are established public streets of the City of Hartford.

August 1982 *George E. Heppner*
City Engineer

NOTE:

VARIANCE GRANTED MAR.17,1981, FILED VOL.1873, PG.27
SUBJECT TO PARTY WALL AGREEMENT
AS OF RECORD APPEAR



FINAL PLOT PLAN

D D & M DEVELOPERS, INC.

379-383 BELLEVUE ST. HARTFORD, CONN.

FOUNDATION CHECKED-
NO ZONING VIOLATIONS.

I HEREBY CERTIFY THAT THIS MAP COMPLIES
WITH A-2 CLASSIFICATION AS DEFINED BY
CONNECTICUT ASSOCIATION OF LAND SURVEYORS, INC.

Wm. Cephal. H.



Alford
ASSOCIATES, INC.


CIVIL ENGINEERS

WILSON M. ALFORD, SR., P.E. & L.S.
WILSON M. ALFORD, JR., P.E. & L.S.

SCALE: 1 IN. = 20 FT.

DATE: AUG. 16, 1982

C F FILE *PARE*

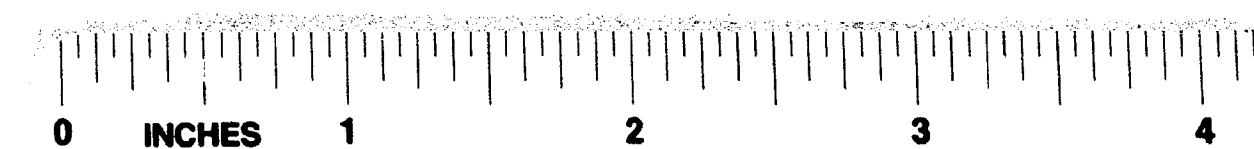

#108

FILE *PARÉ*