


1233

1 2 3 3 - 2

75 Locust St

OCT 2 | 24 PM '82

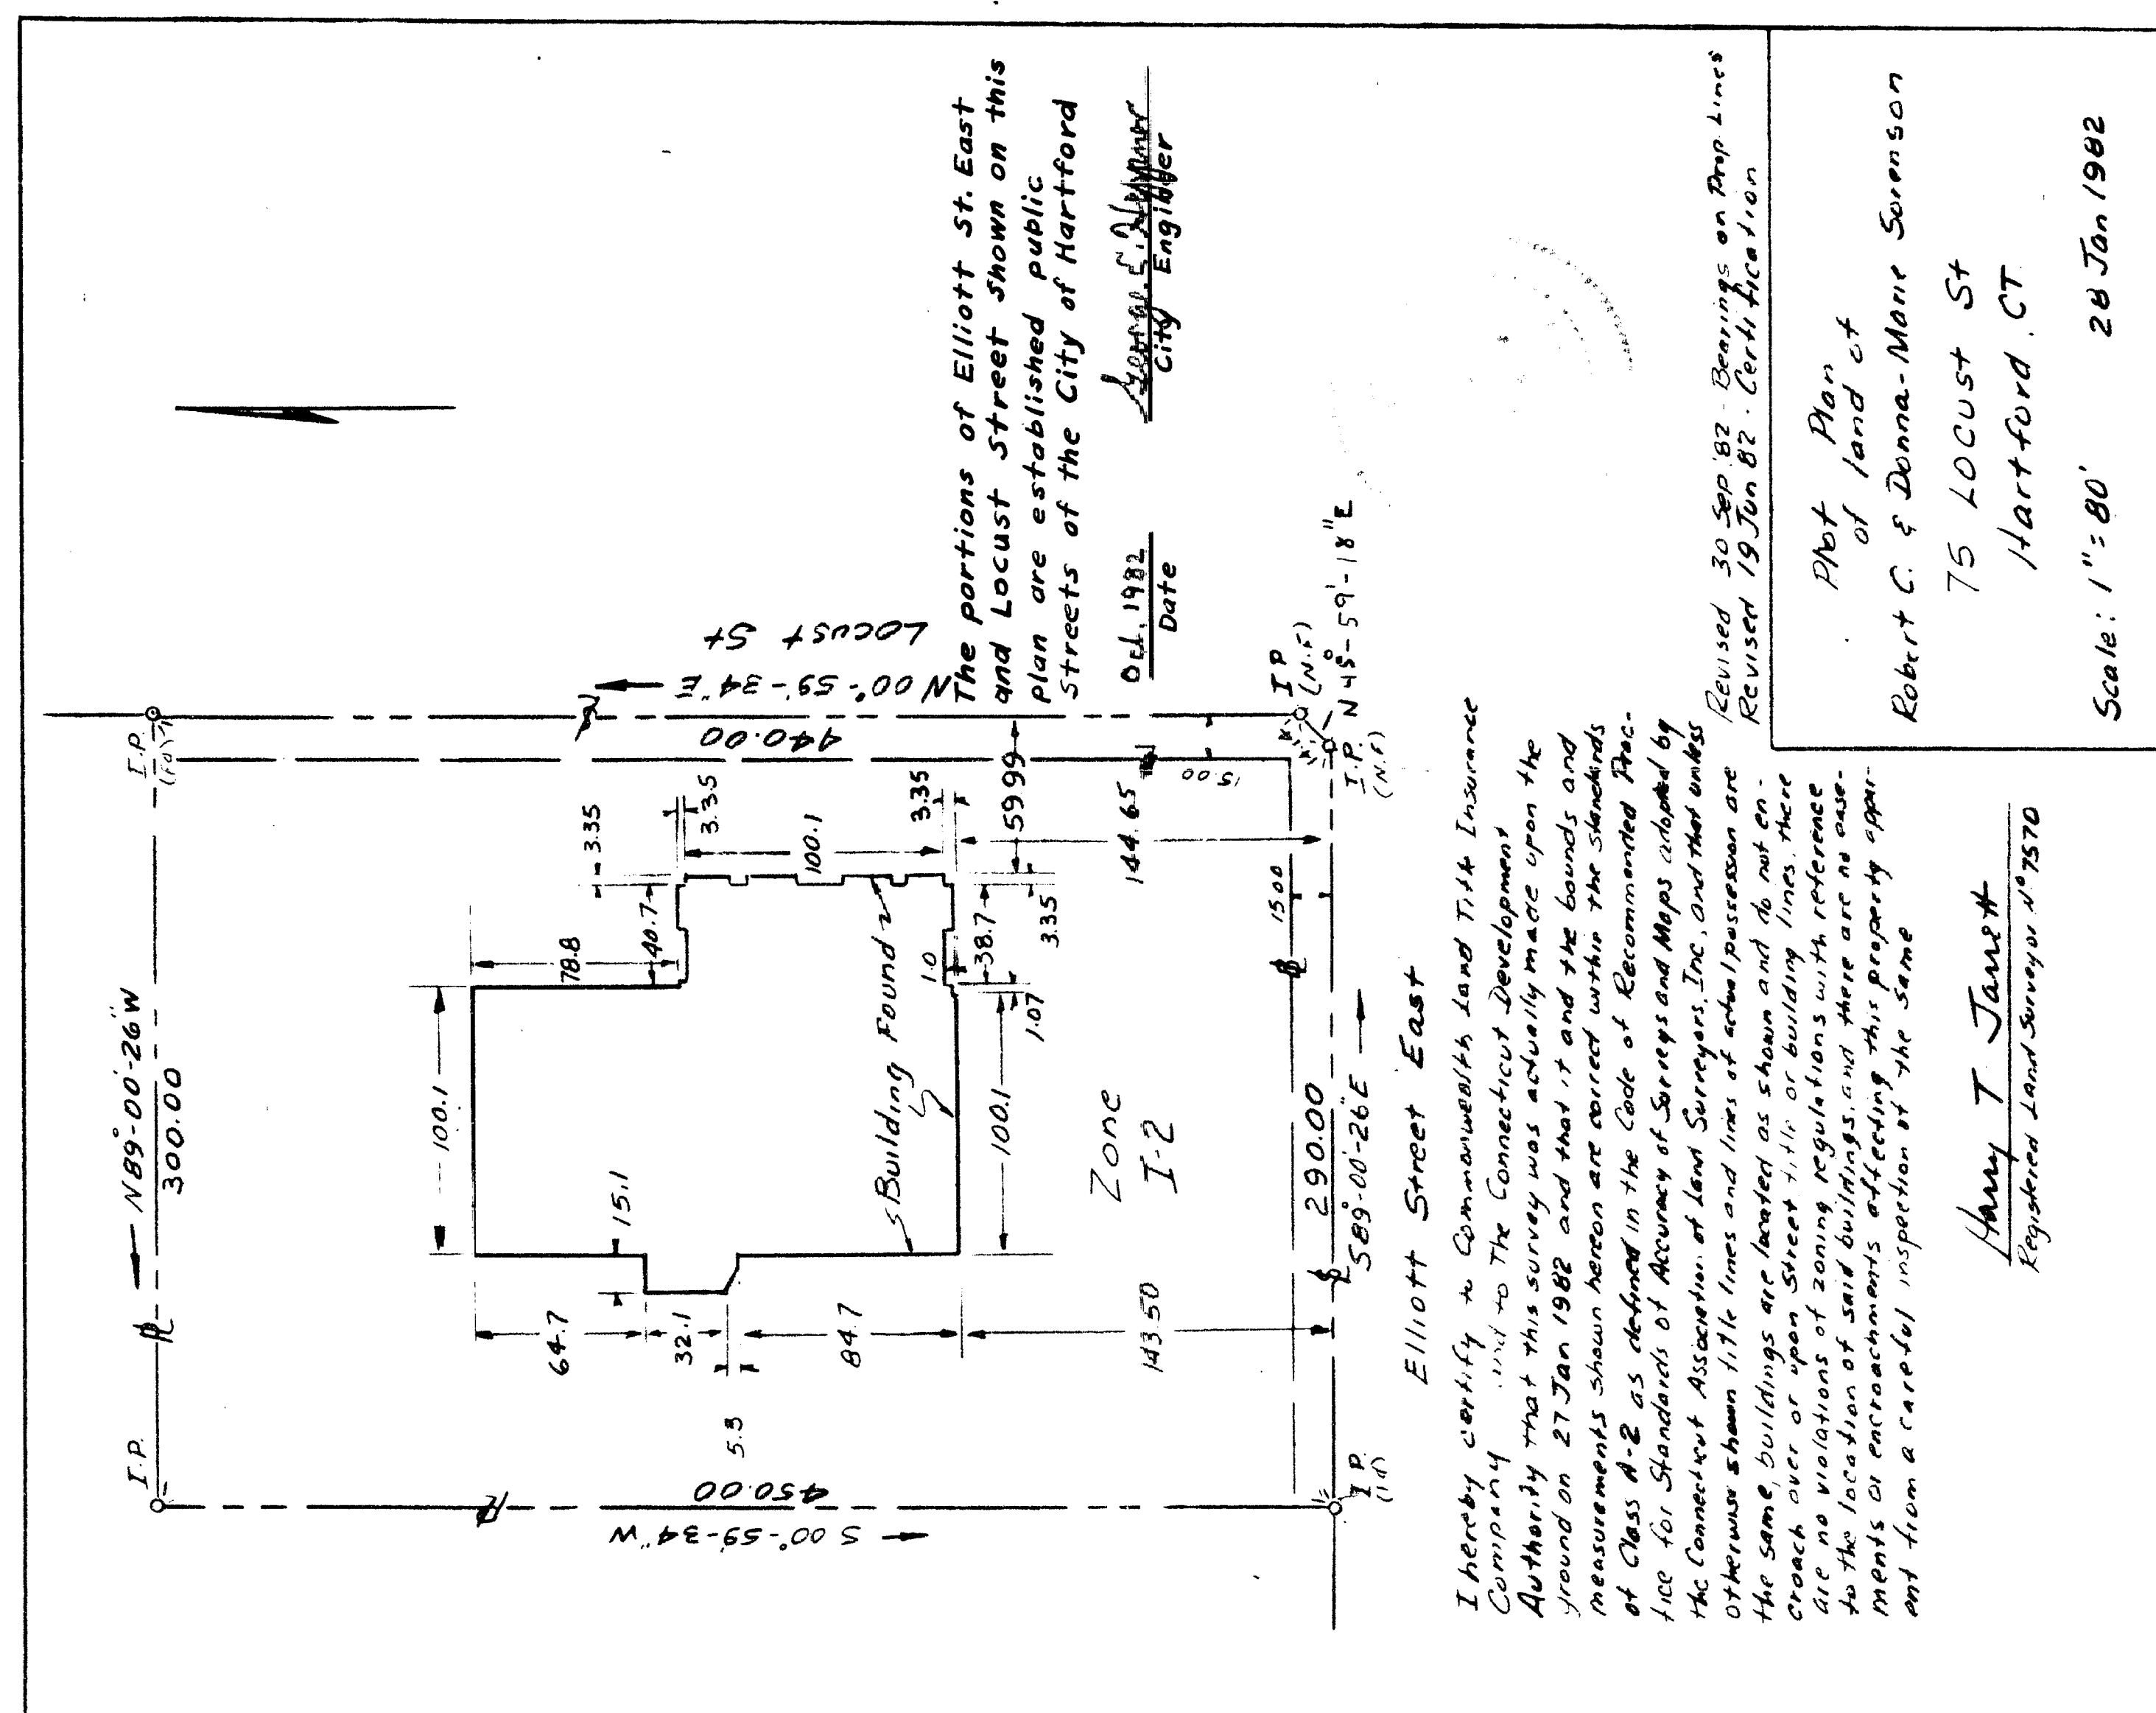

119