


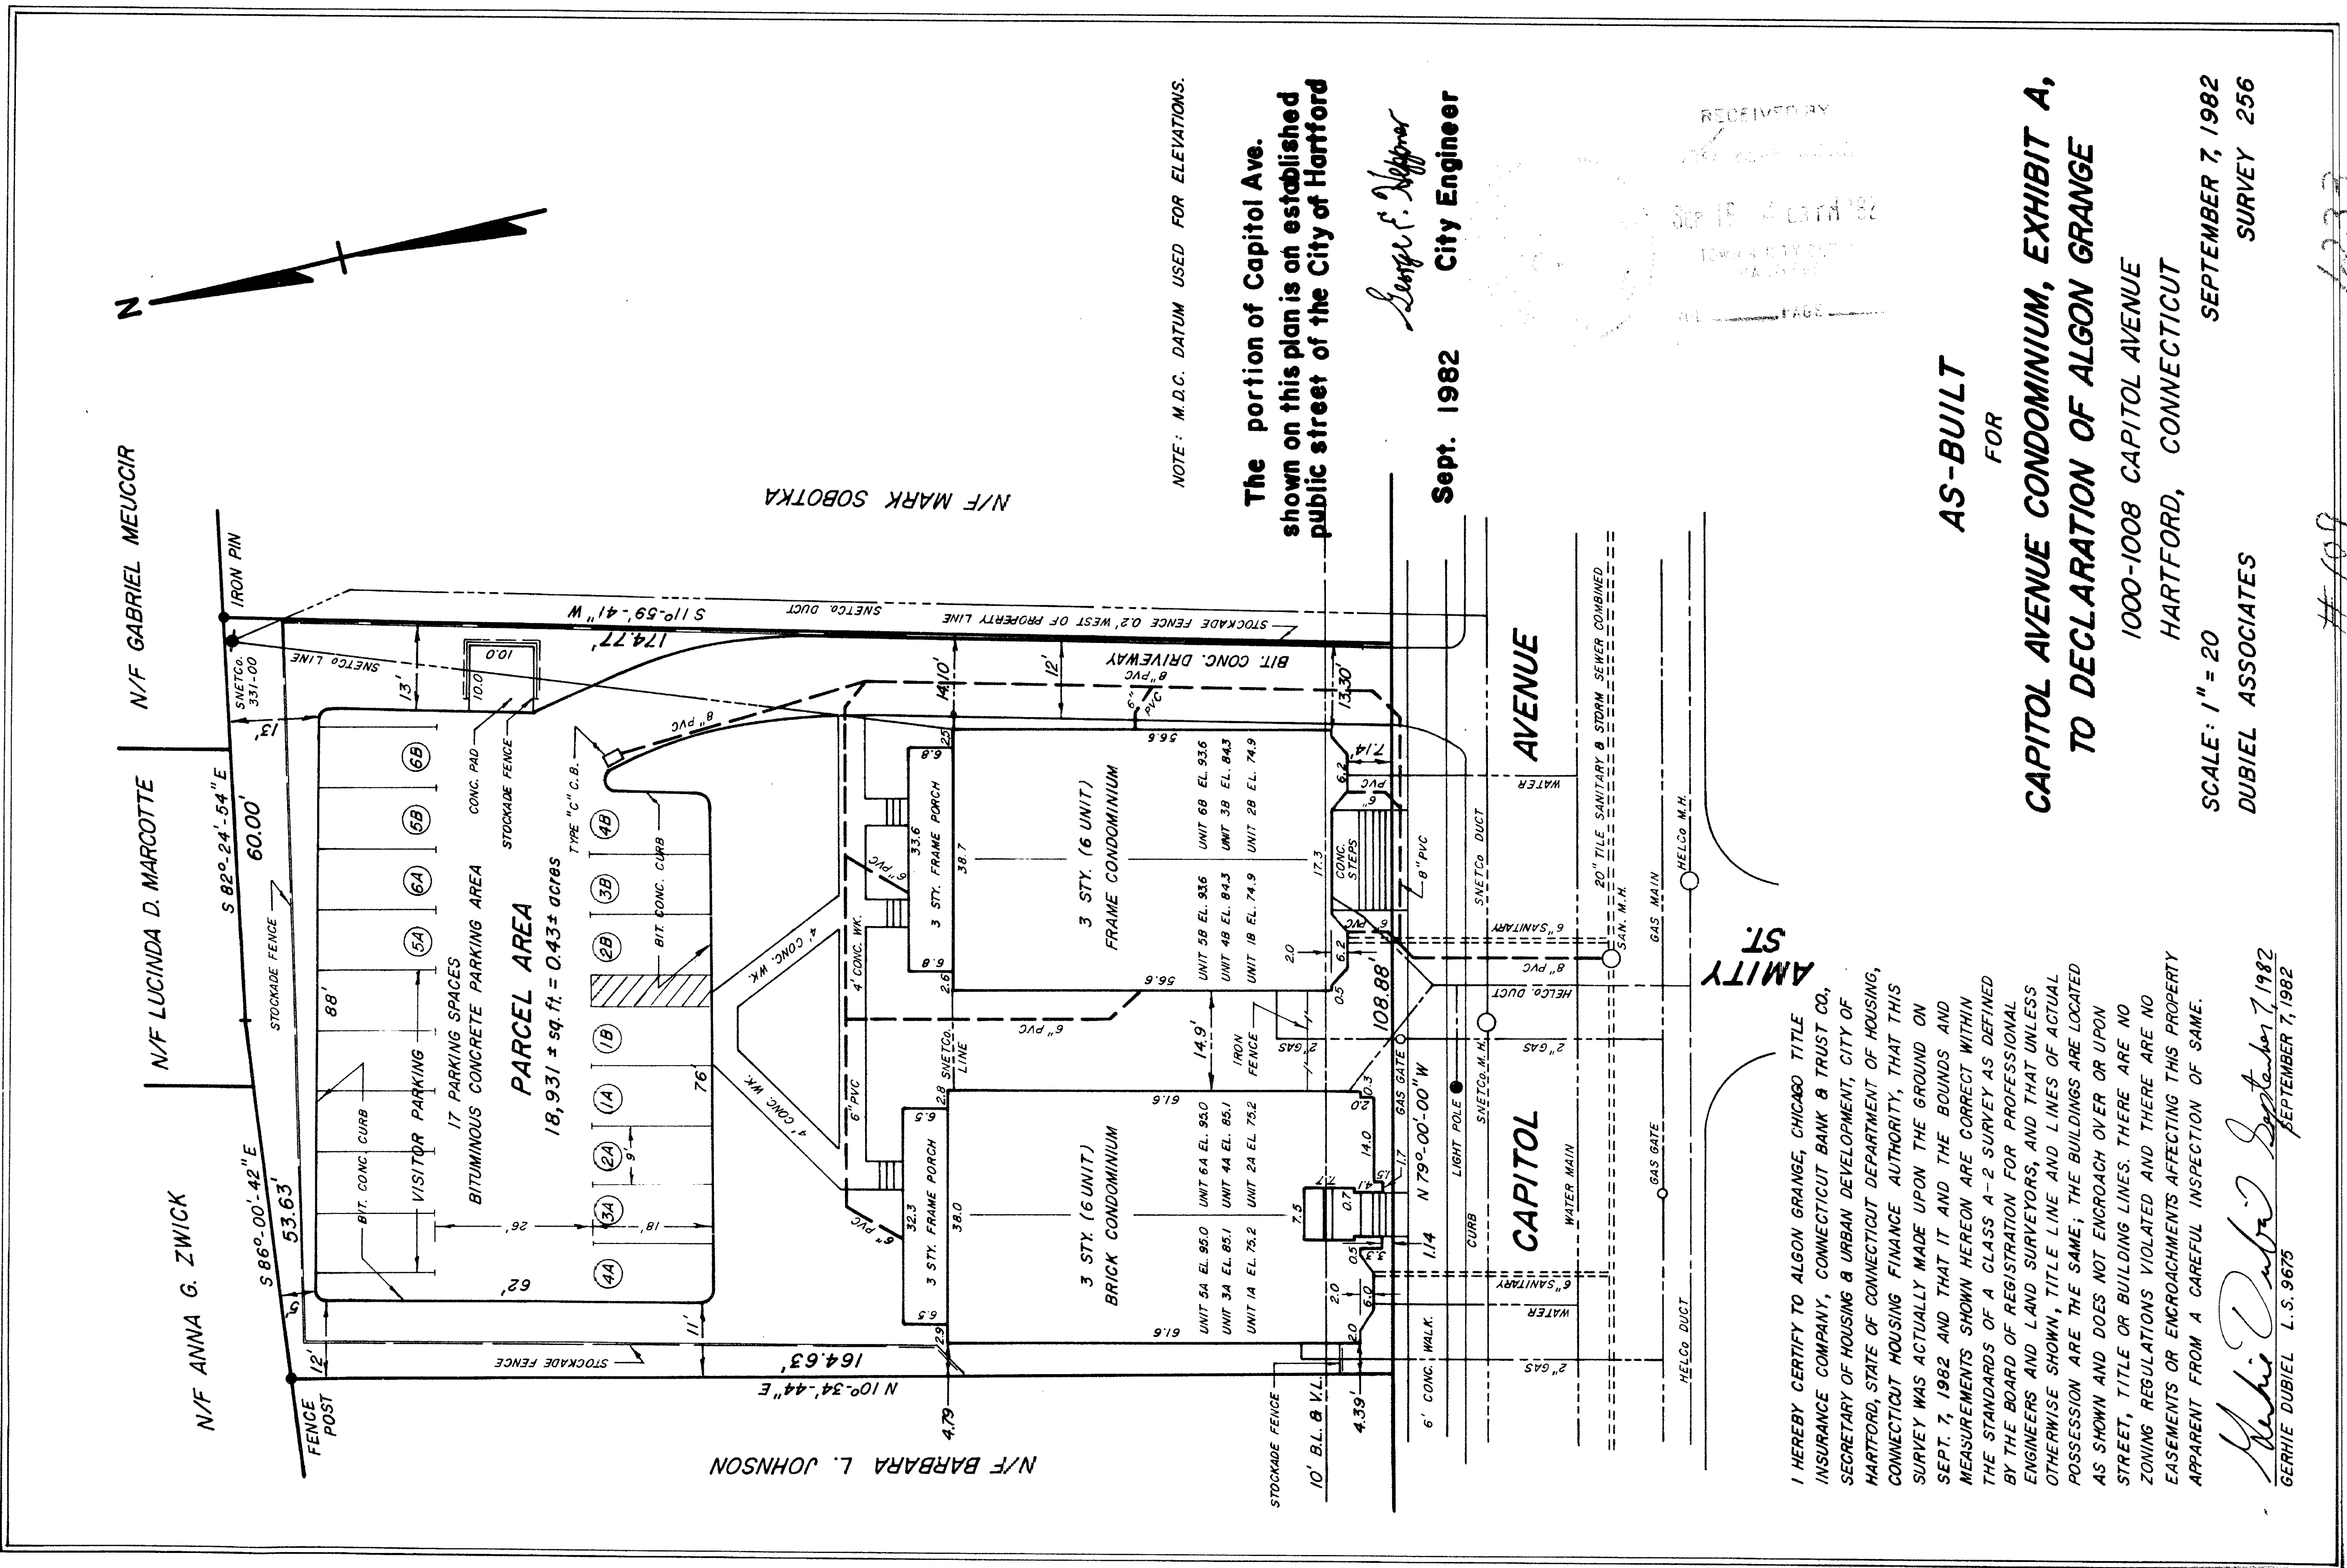

0 INCHES 1 2 3 4