
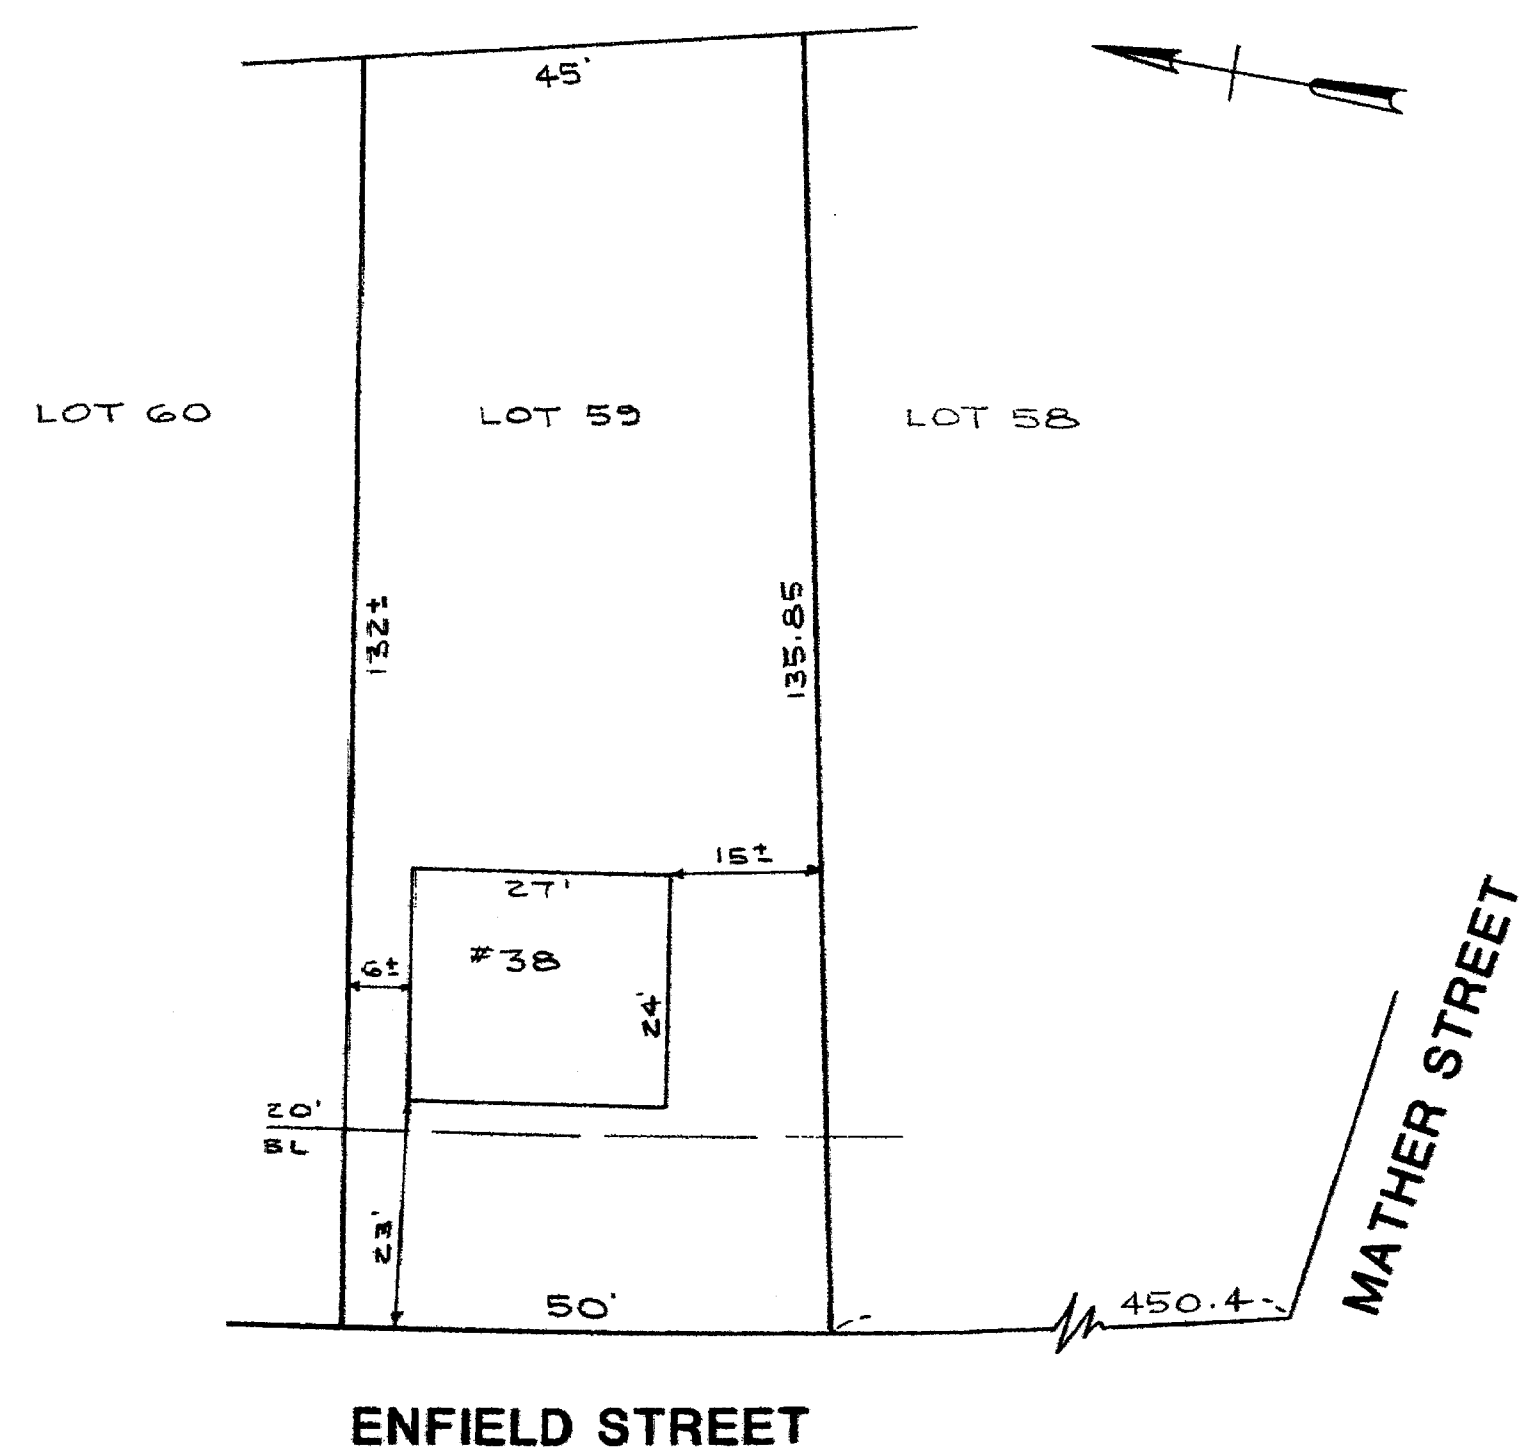
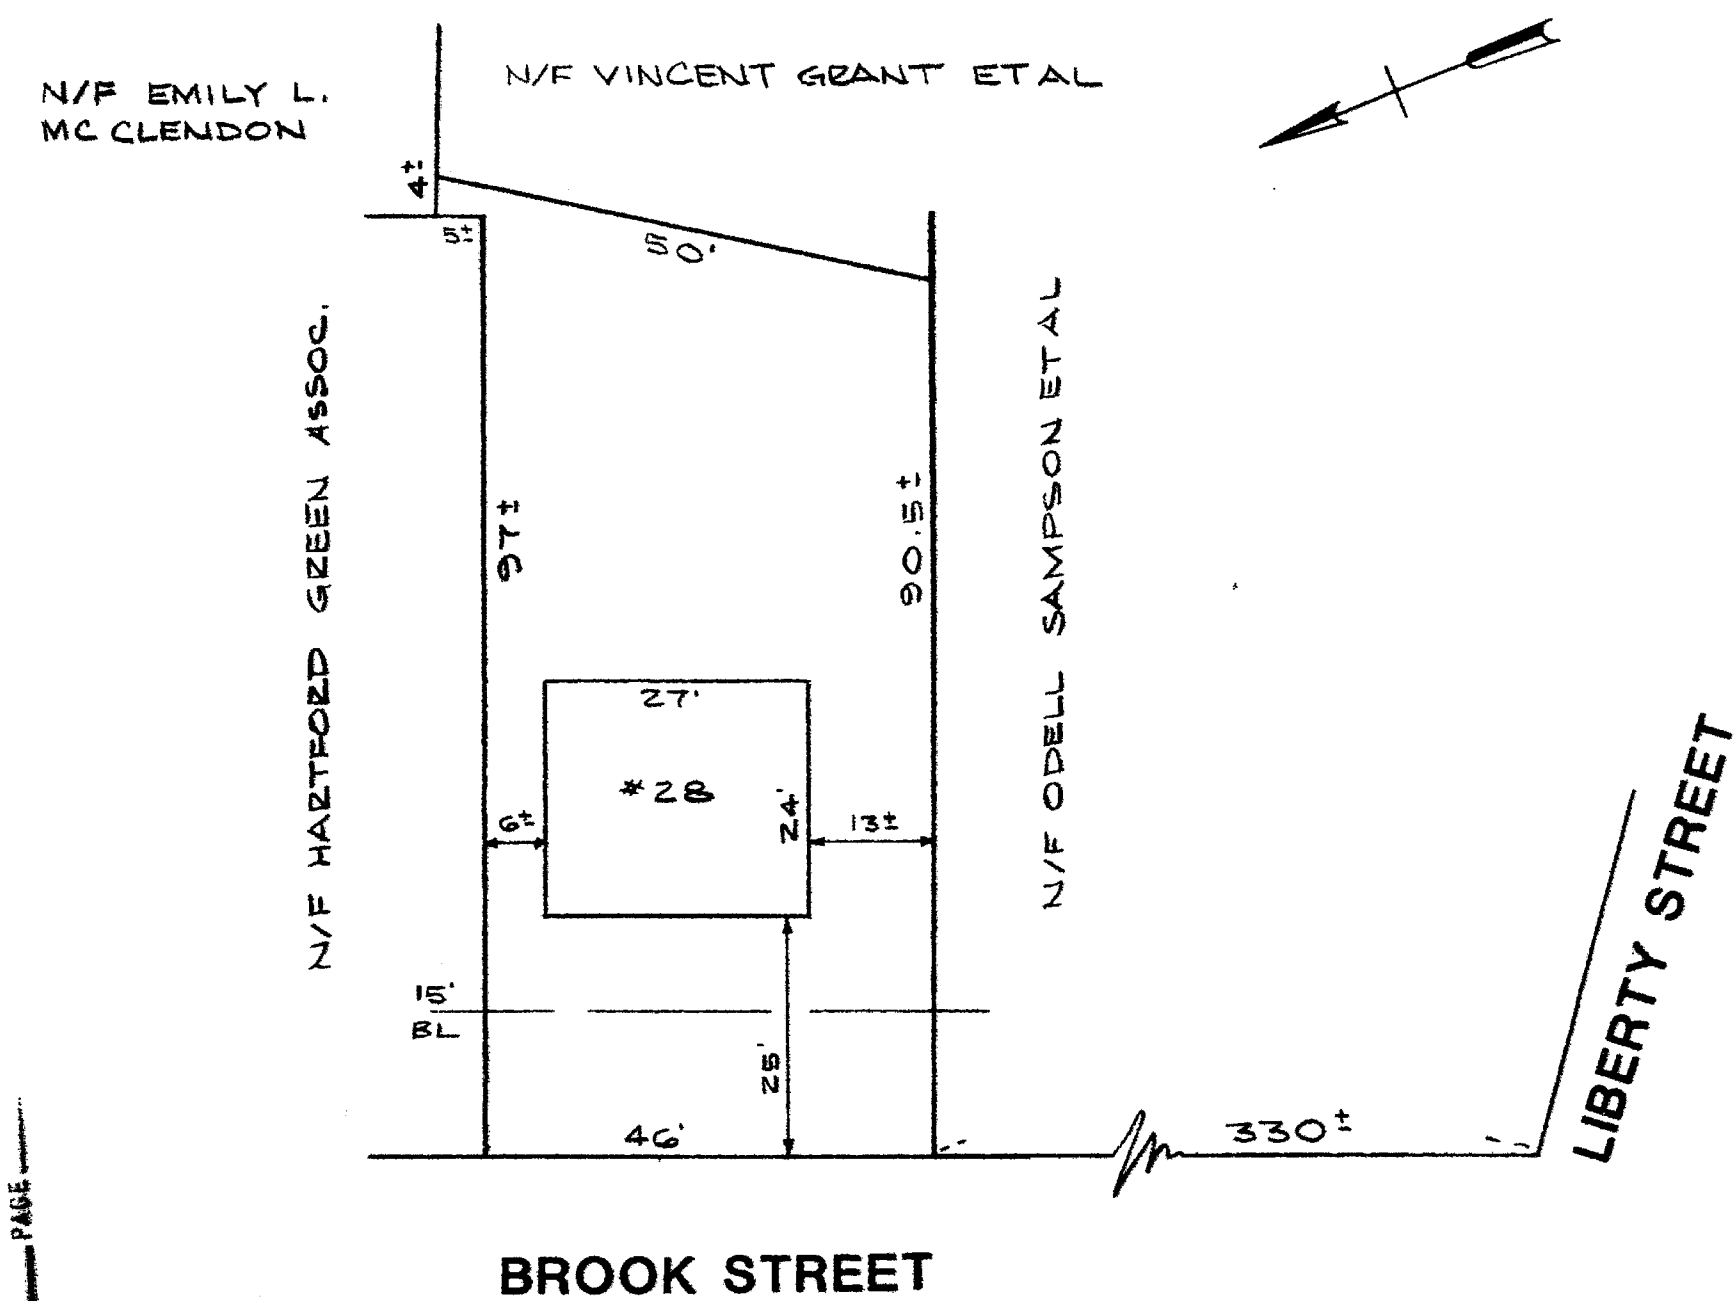
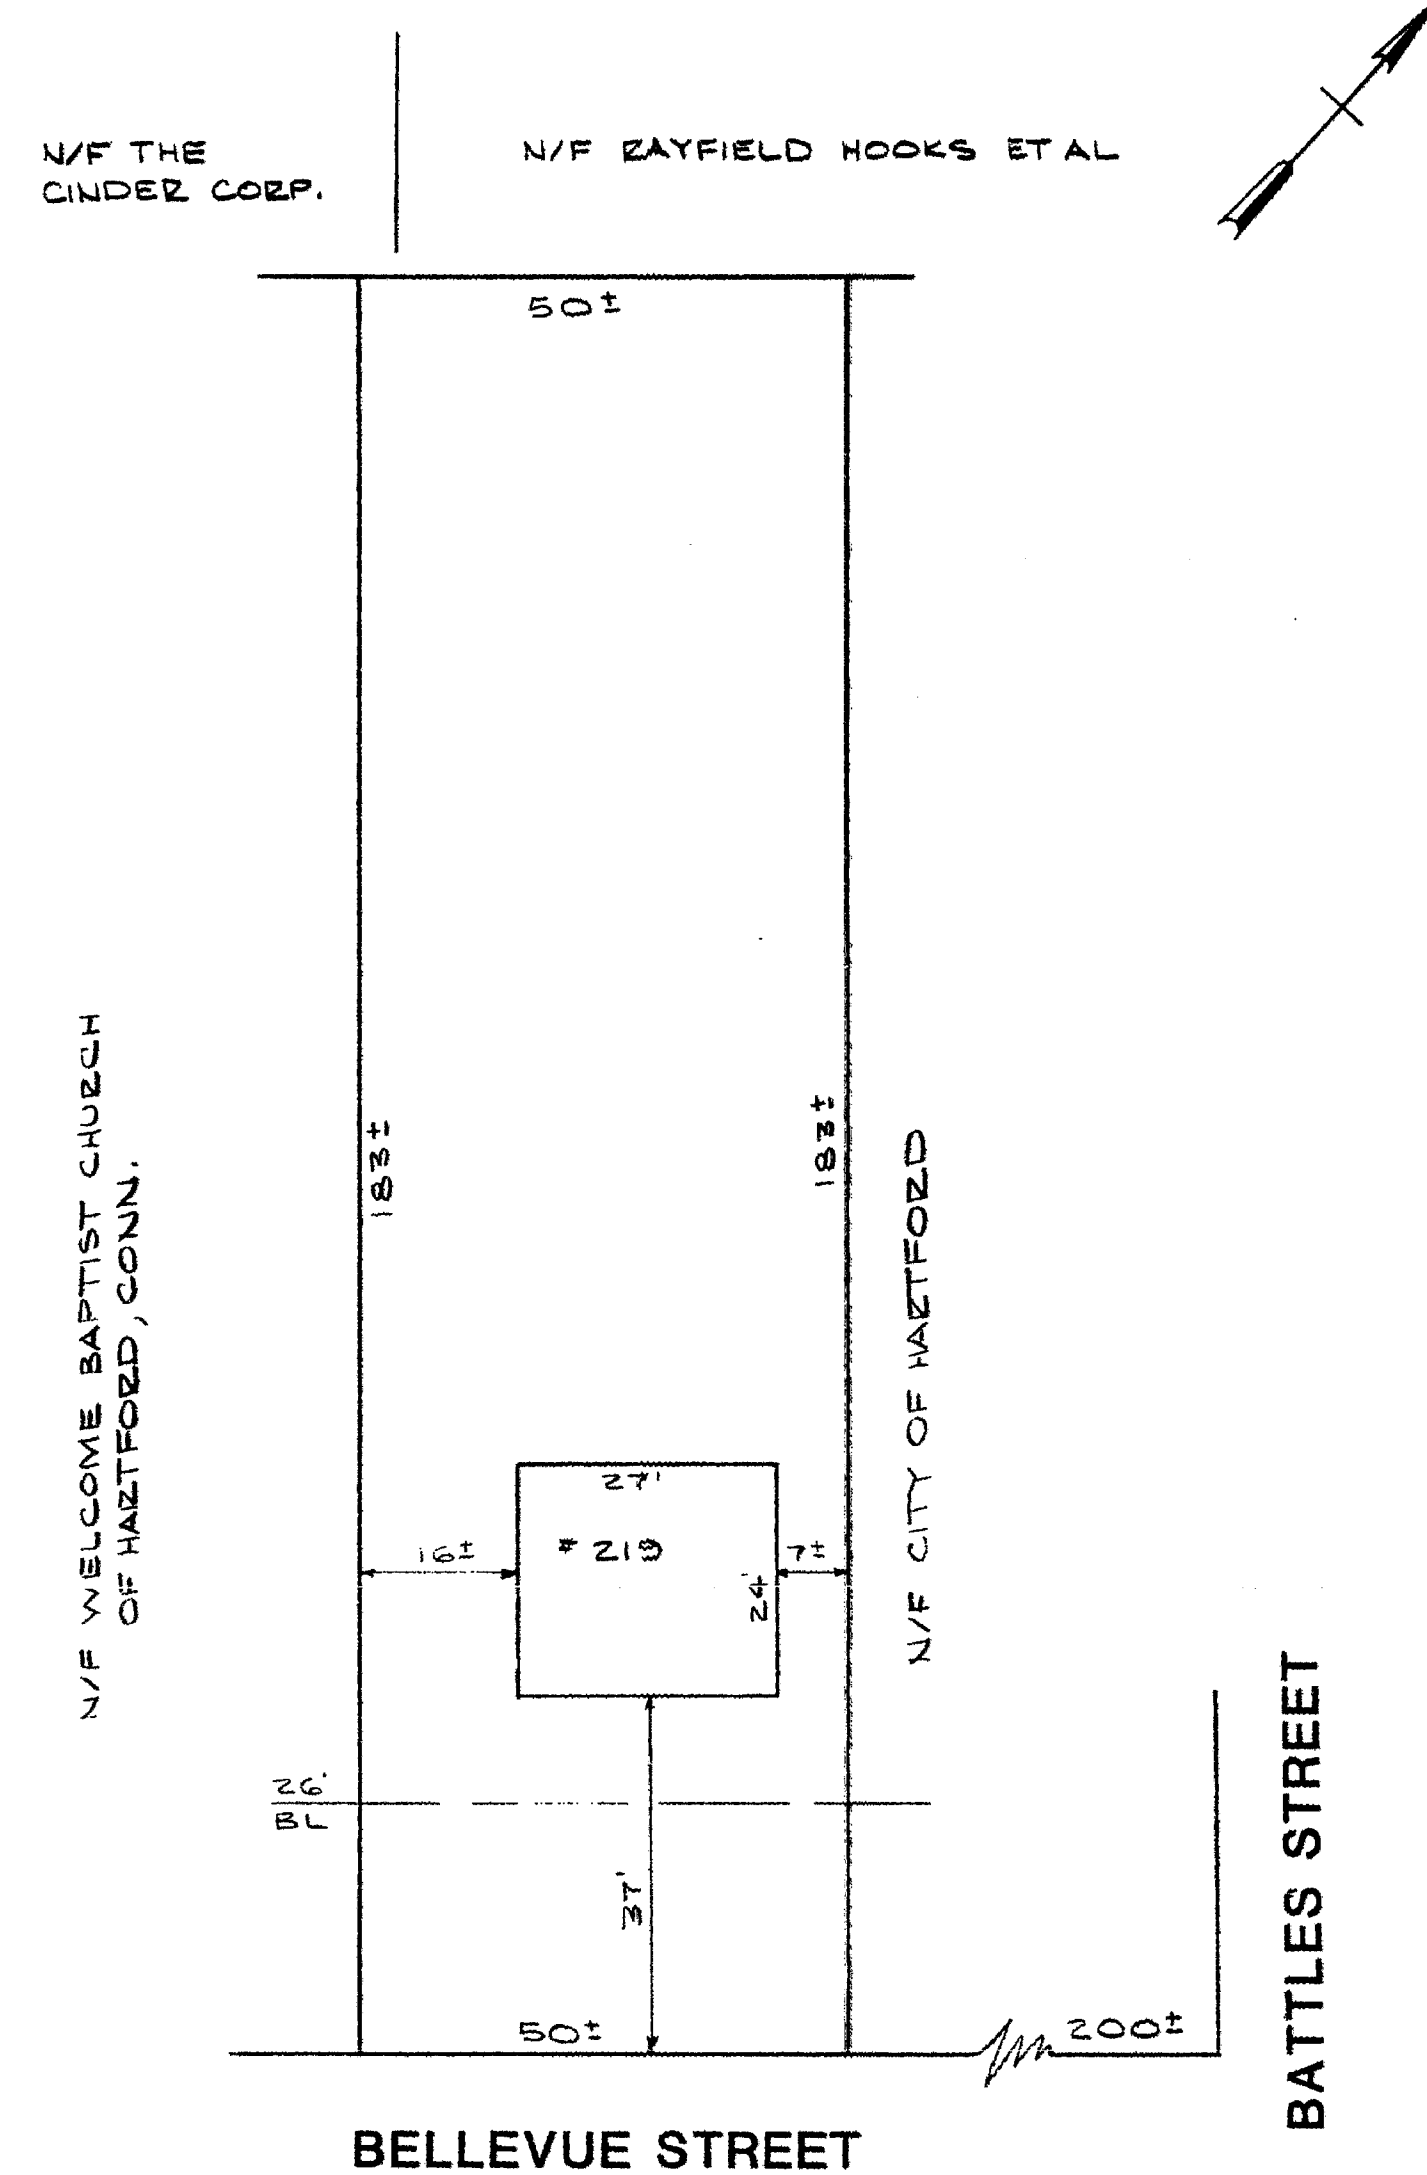
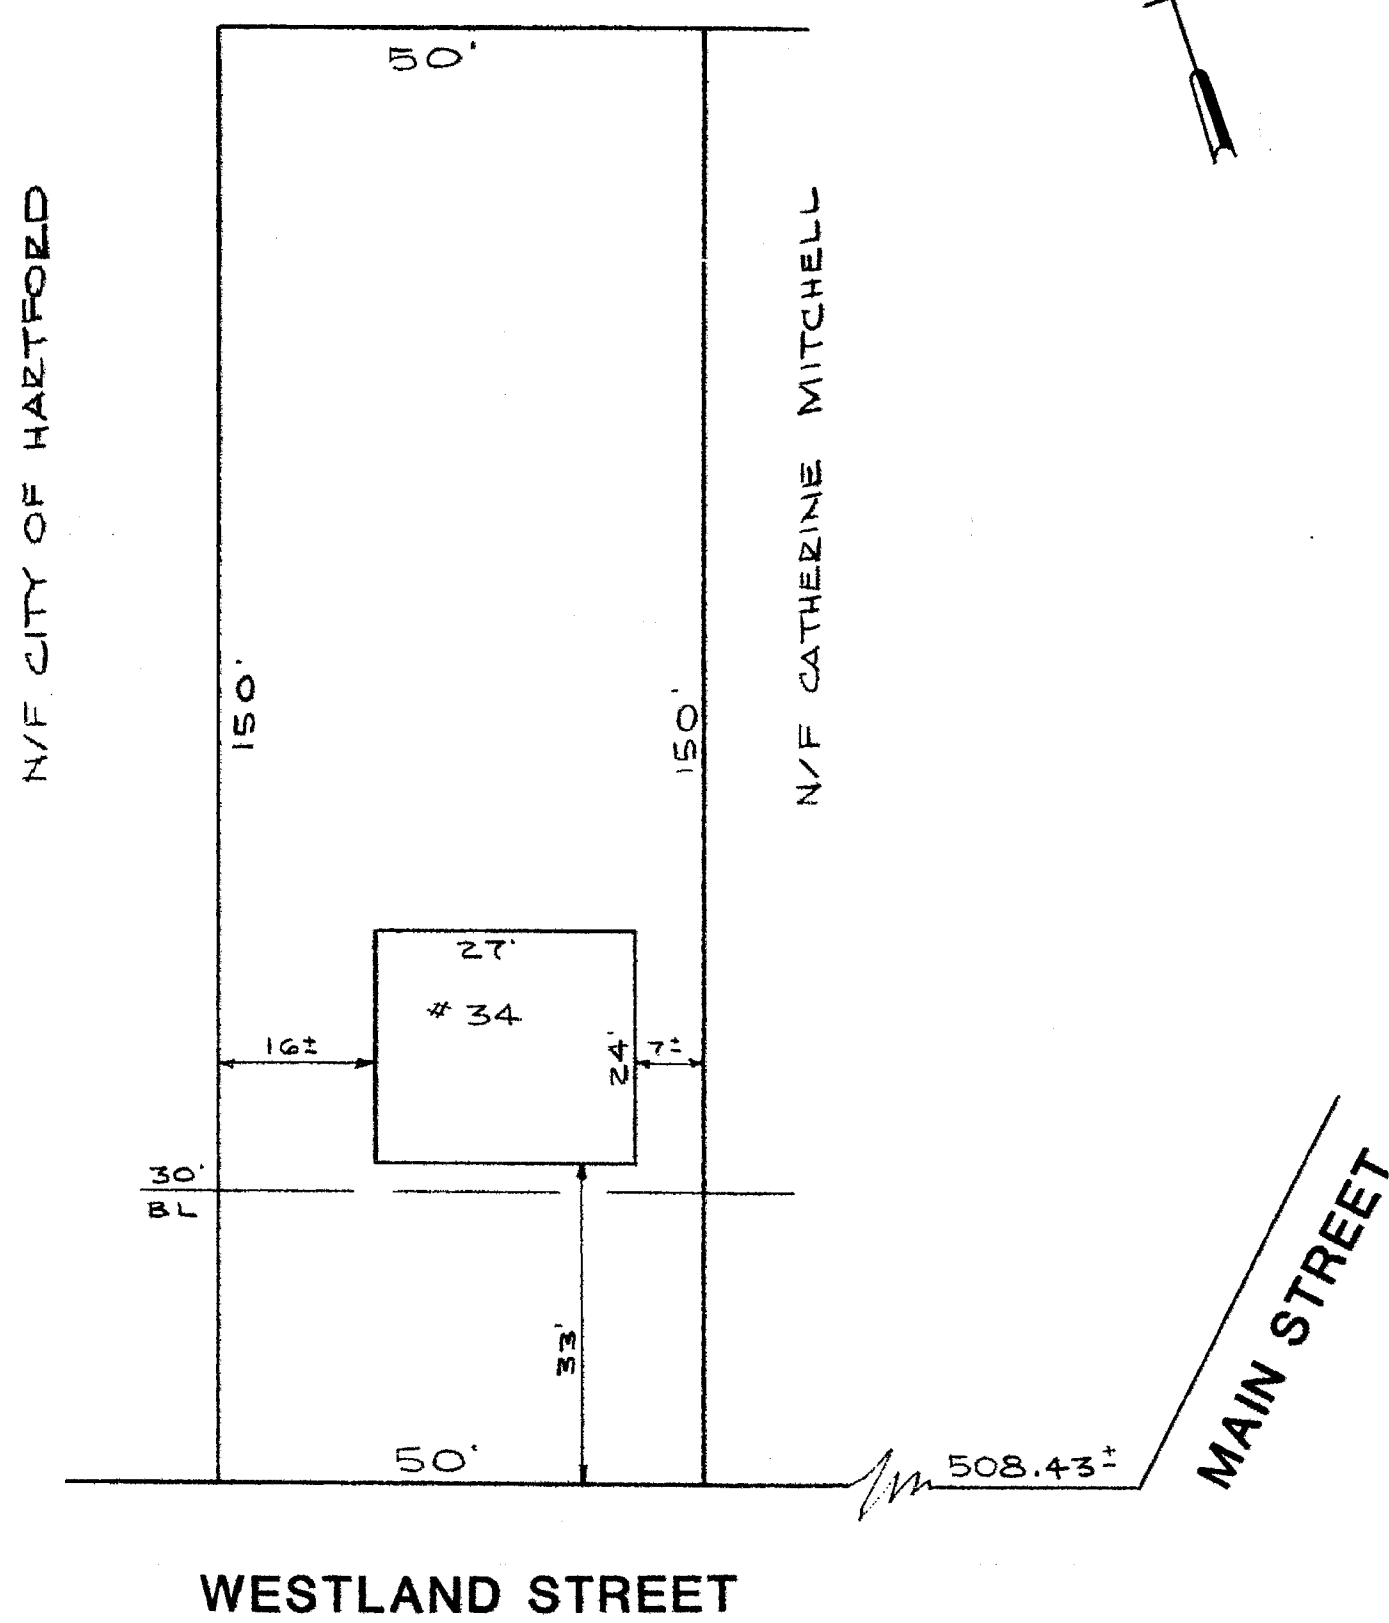


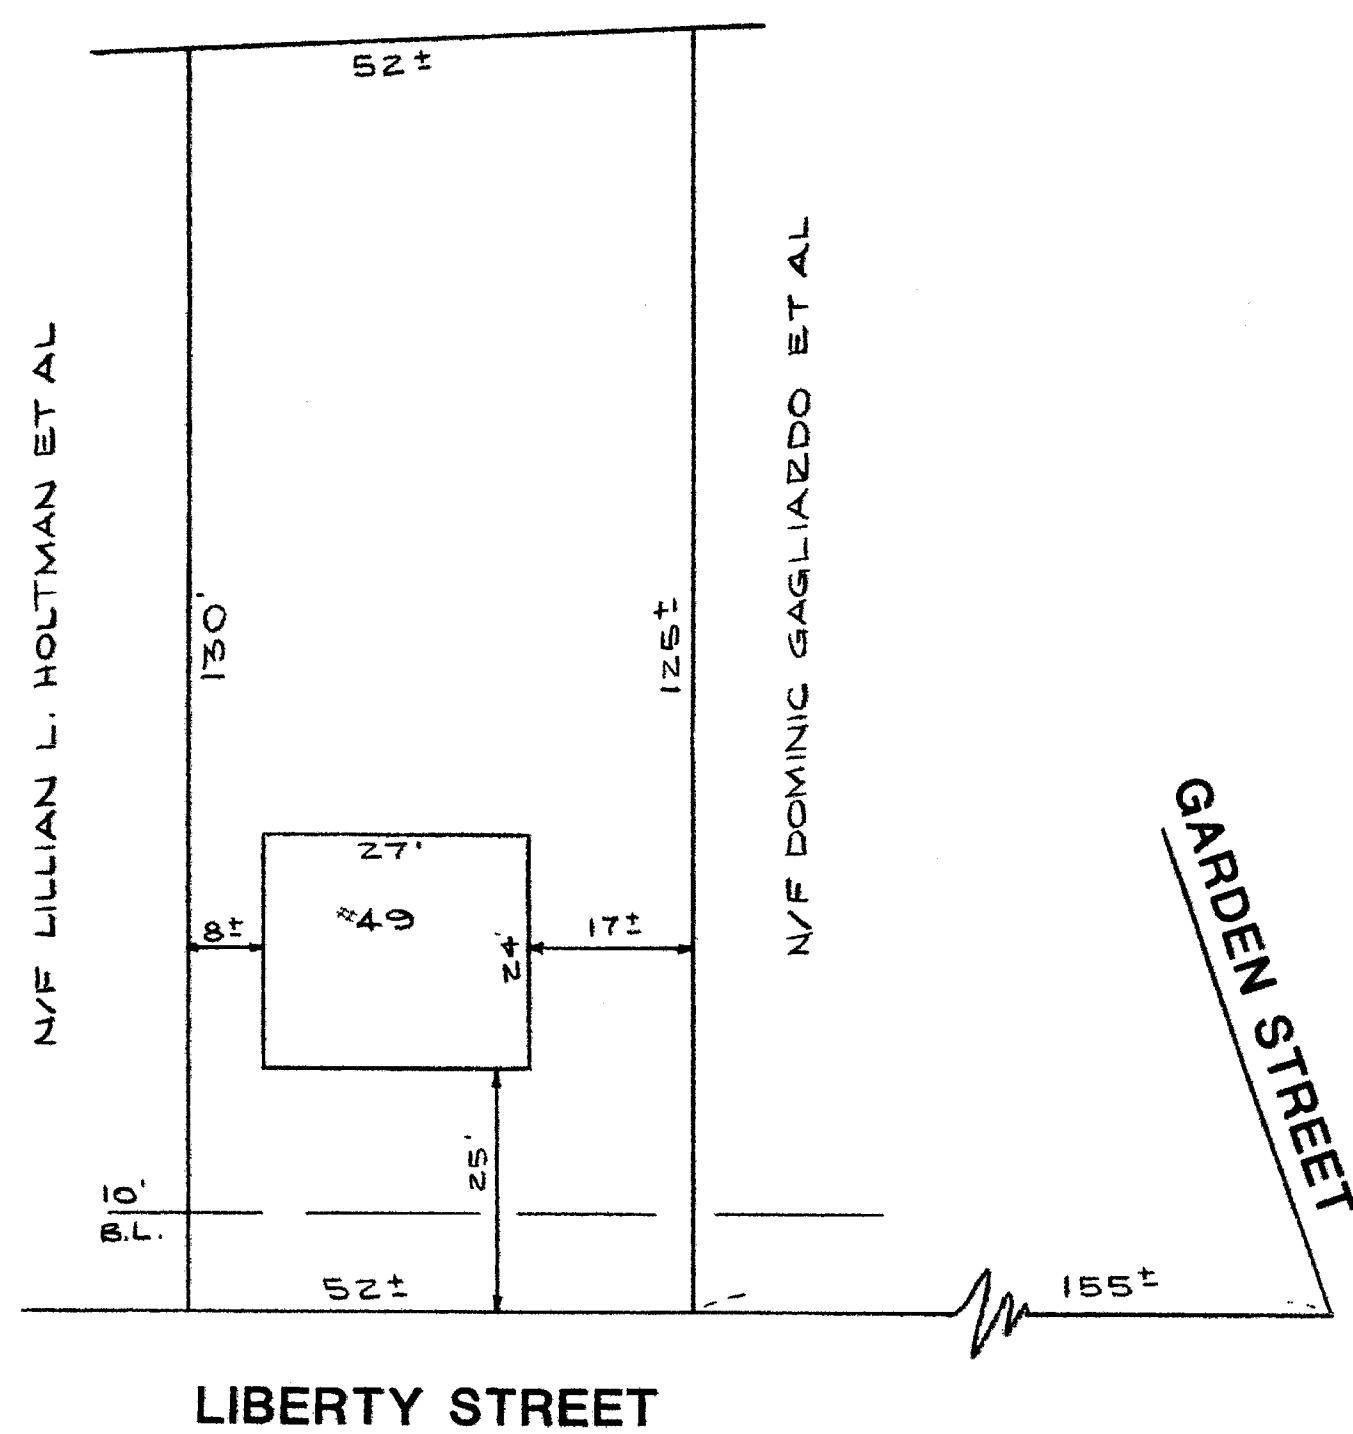

NOTE:
LOT NUMBERS REFER TO MAP ENTITLED
"BUILDING LOTS PROPERTY OF THE BUILDERS
REALTY AND IMPROVEMENT CO. VINE ST.,
MATHER ST. ET AL HARTFORD, CONN.
SCALE 1"=50' APR. 1903"

The portions of Liberty St., Garden St., Westland St., Main St.,
Bellevue St., Battles St., Brook St., Liberty St., Enfield St. and
Mather St. shown on this plan are established public Streets
of the City of Hartford.

Nov. 17, 1982
Date

George S. Alfond
City Engineer

FOUNDATIONS LOCATED AS SHOWN
NO ZONING VIOLATIONS

DATE		REVISION		I HEREBY CERTIFY THAT THIS MAP COMPLIES WITH CLASS C CLASSIFICATION AS DEFINED BY CONNECTICUT ASSOCIATION OF LAND SURVEYORS, INC.	
				W. W. Alfond, Jr. ALFORD ASSOCIATES, INC.	
				CIVIL ENGINEERS WINDSOR, CONNECTICUT	
				WILSON M. ALFORD, SR., P.E. & L.S. WILSON M. ALFORD, JR., P.E. & L.S.	
				SCALE: 1 IN. = 20 FT. DATE: OCT. 22, 1982	
				PROPERTY OF DUTIL REALTY CORPORATION LIBERTY STREET WESTLAND STREET BELLEVUE STREET BROOK STREET ENFIELD STREET HARTFORD, CONN.	

