



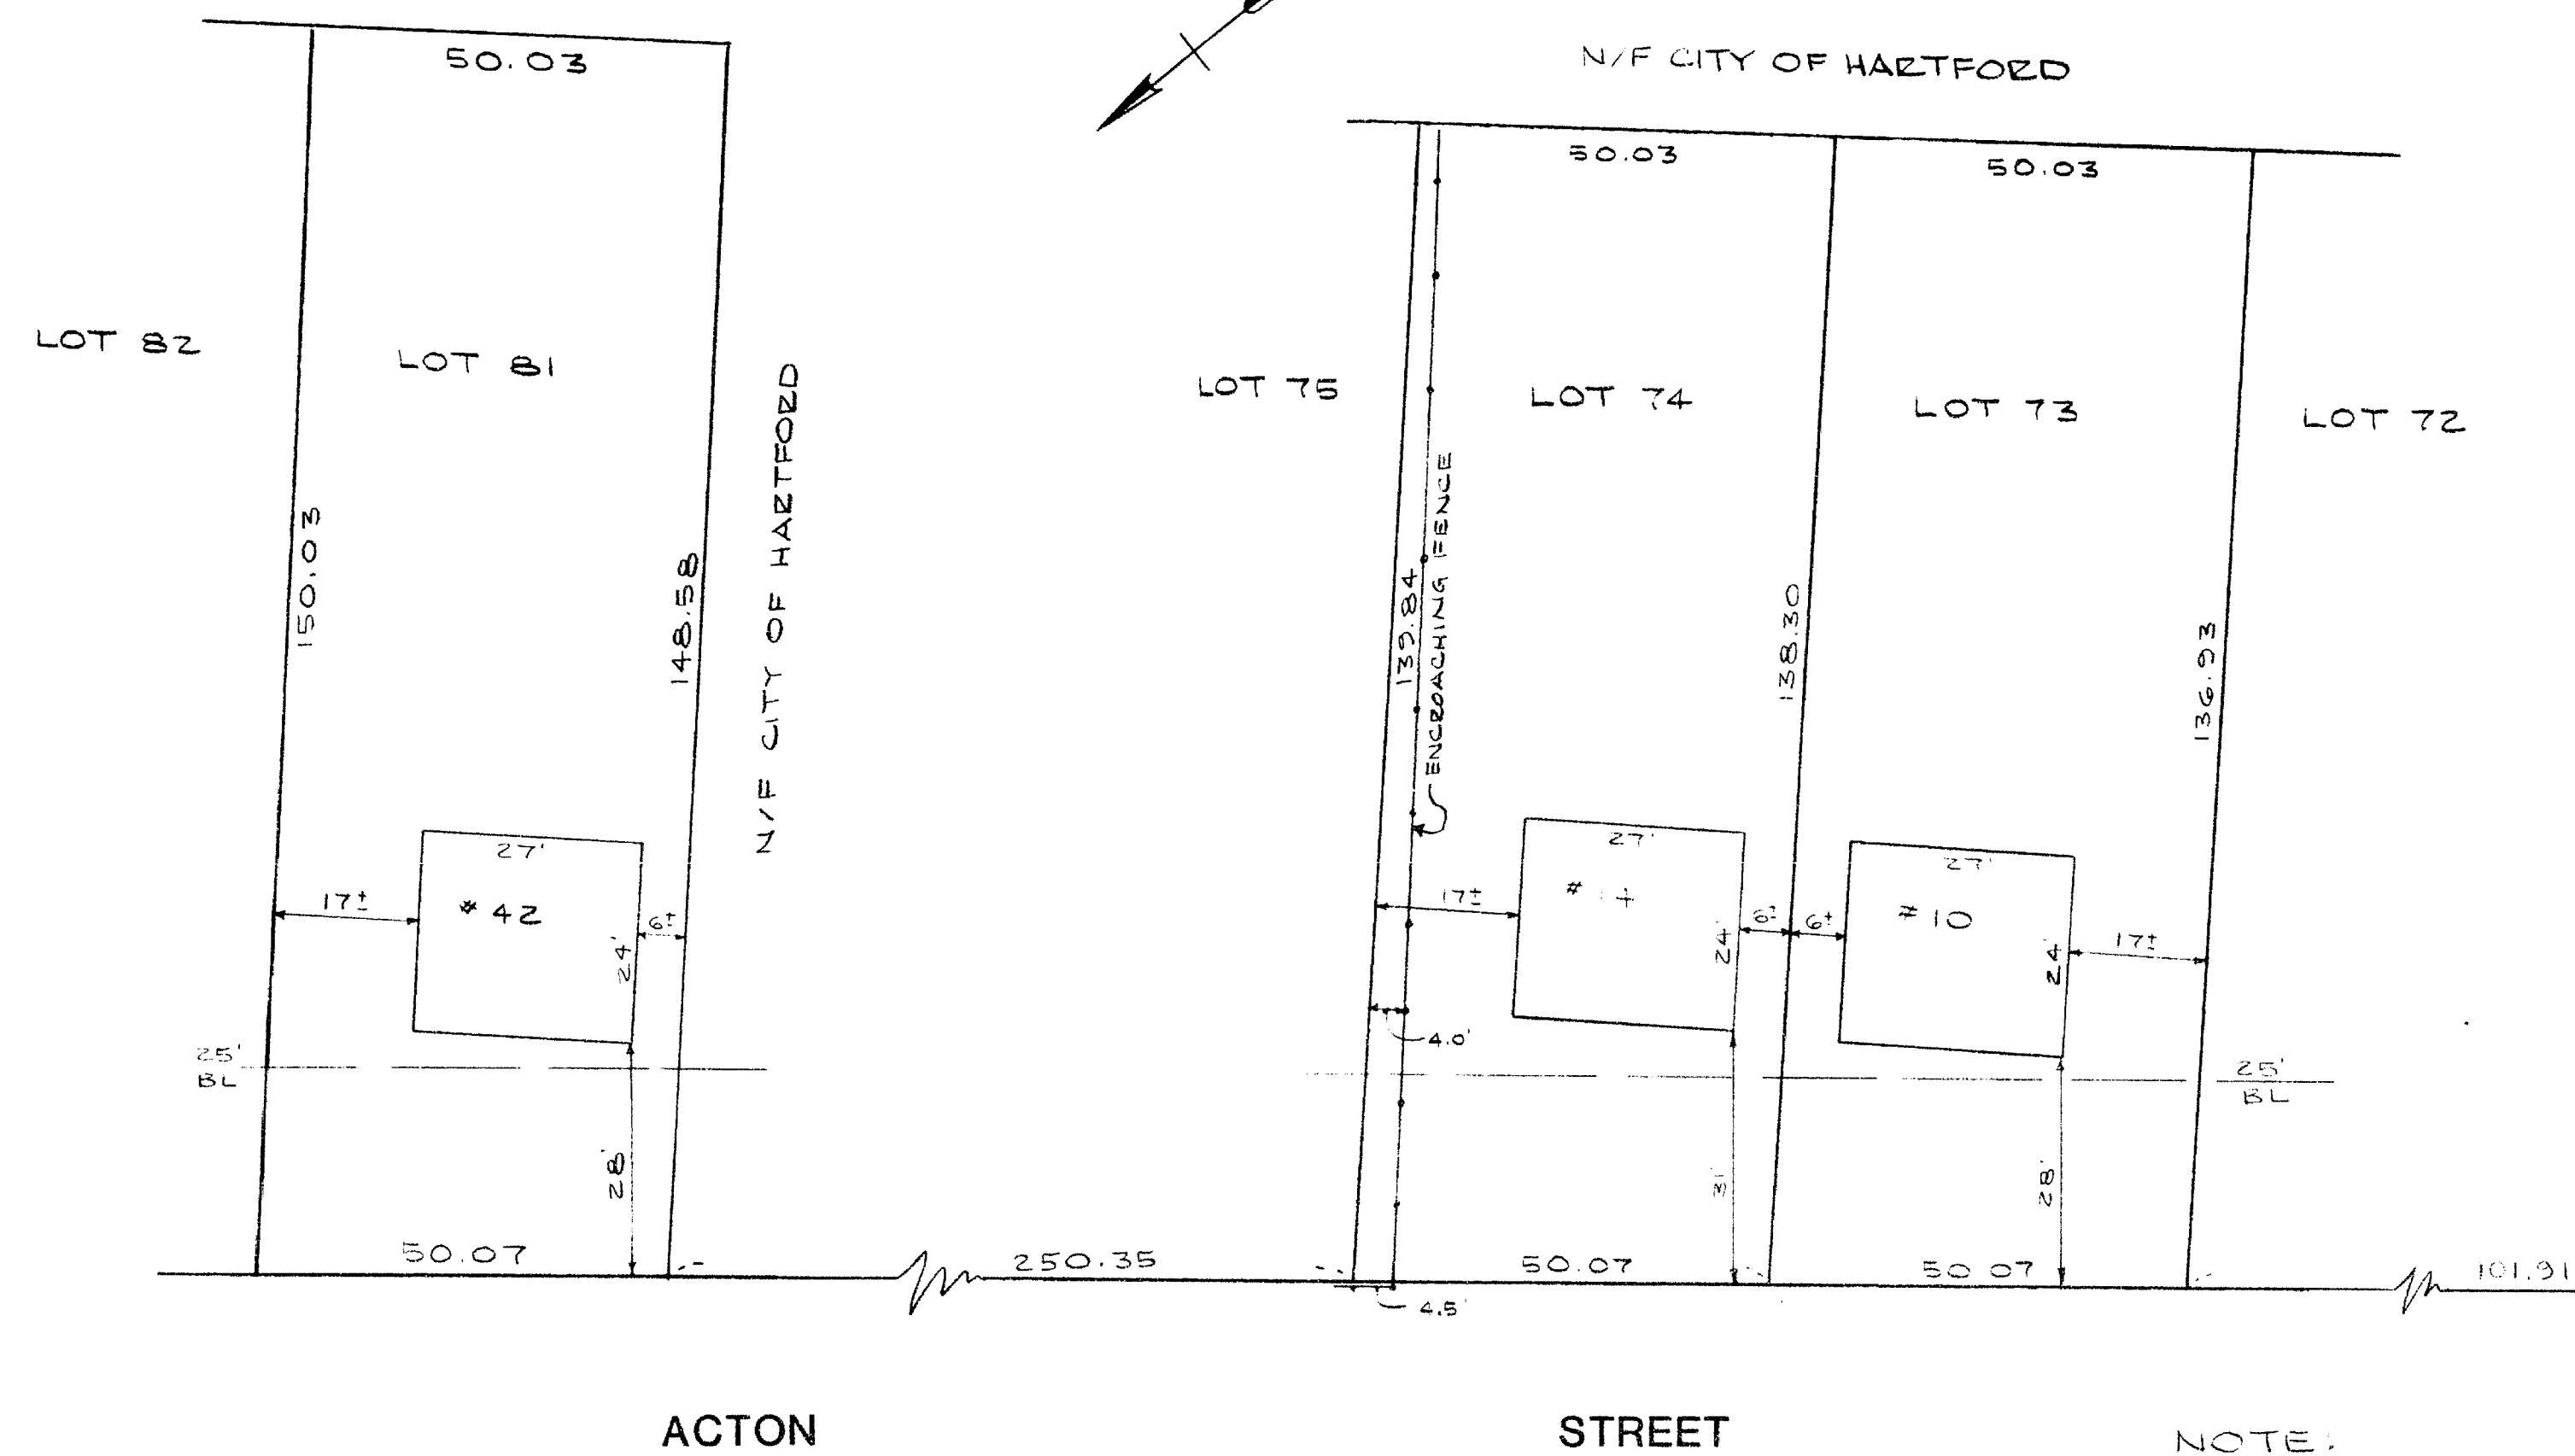

NOTE:
LOT NUMBERS REFER TO MAP ENTITLED
"NESSED CASTONGUAY GOLDBERG &
KIEZSTEAD REVISED LOT PLAN HILLYER
TRACT - HARTFORD, CT SCALE 1"=50'
MAY 28, 1920 REV. OCT 20, 1920"

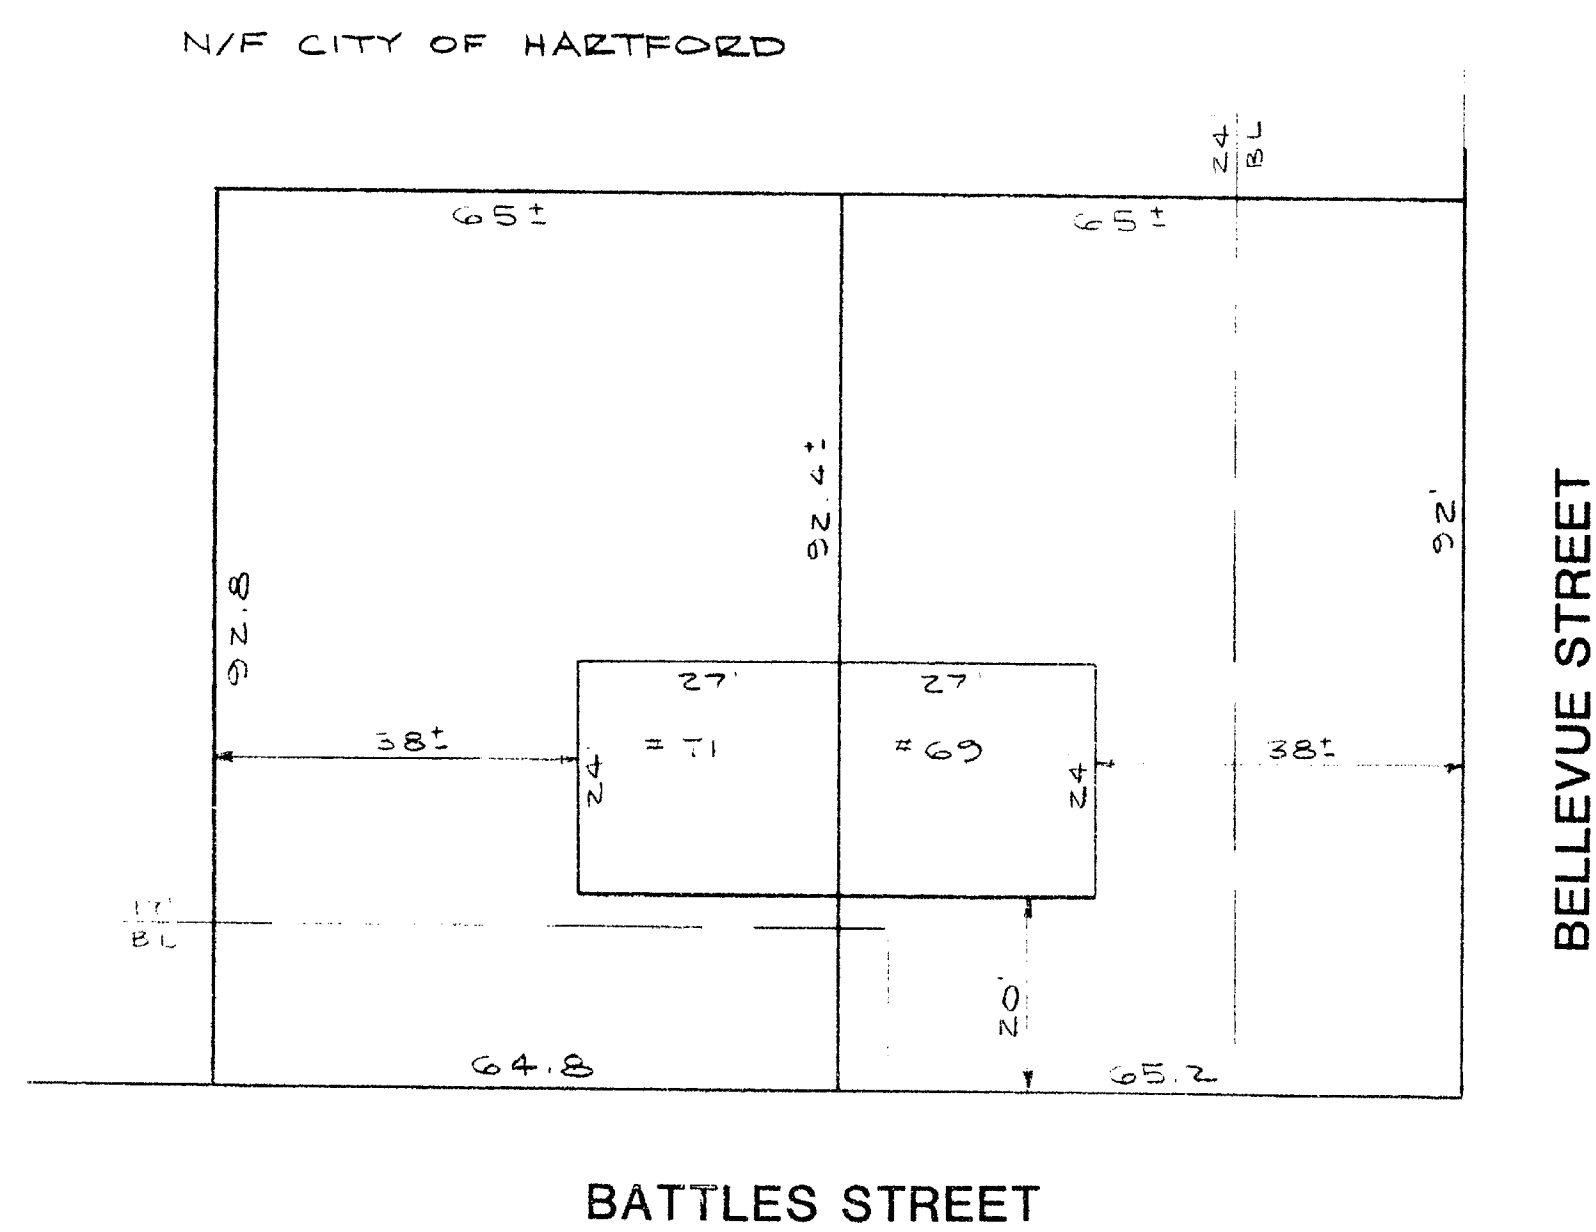

The portions of Acton St., Nelson St., Battles St., Bellevue St.,
Capen St., and Barbour St. shown on this plan are established
public Streets of the City of Hartford.

Nov. 17, 1982
Date

George C. Williams
City Engineer

FOUNDATIONS LOCATED AS SHOWN
NO ZONING VIOLATIONS

I HEREBY CERTIFY THAT THIS MAP COMPLIES WITH CLASS ☒ CLASSIFICATION AS DEFINED BY CONNECTICUT ASSOCIATION OF LAND SURVEYORS, INC. W. M. Alford & Co. ALFORD ASSOCIATES, INC.		CIVIL ENGINEERS WINDSOR, CONNECTICUT WILSON M. ALFORD, JR., P.E., S.E. WILSON M. ALFORD, JR., P.E., S.E.
DATE	REVISION	SCALE: 1 IN. = 20 FT. DATE: OCT 22, 1982
PROPERTY OF DUTIL REALTY CORPORATION ACTON STREET BATTLES STREET CAPEN STREET HARTFORD, CONN.		HARTFORD, CONN.

